




DETAIL E
NOT TO SCALE

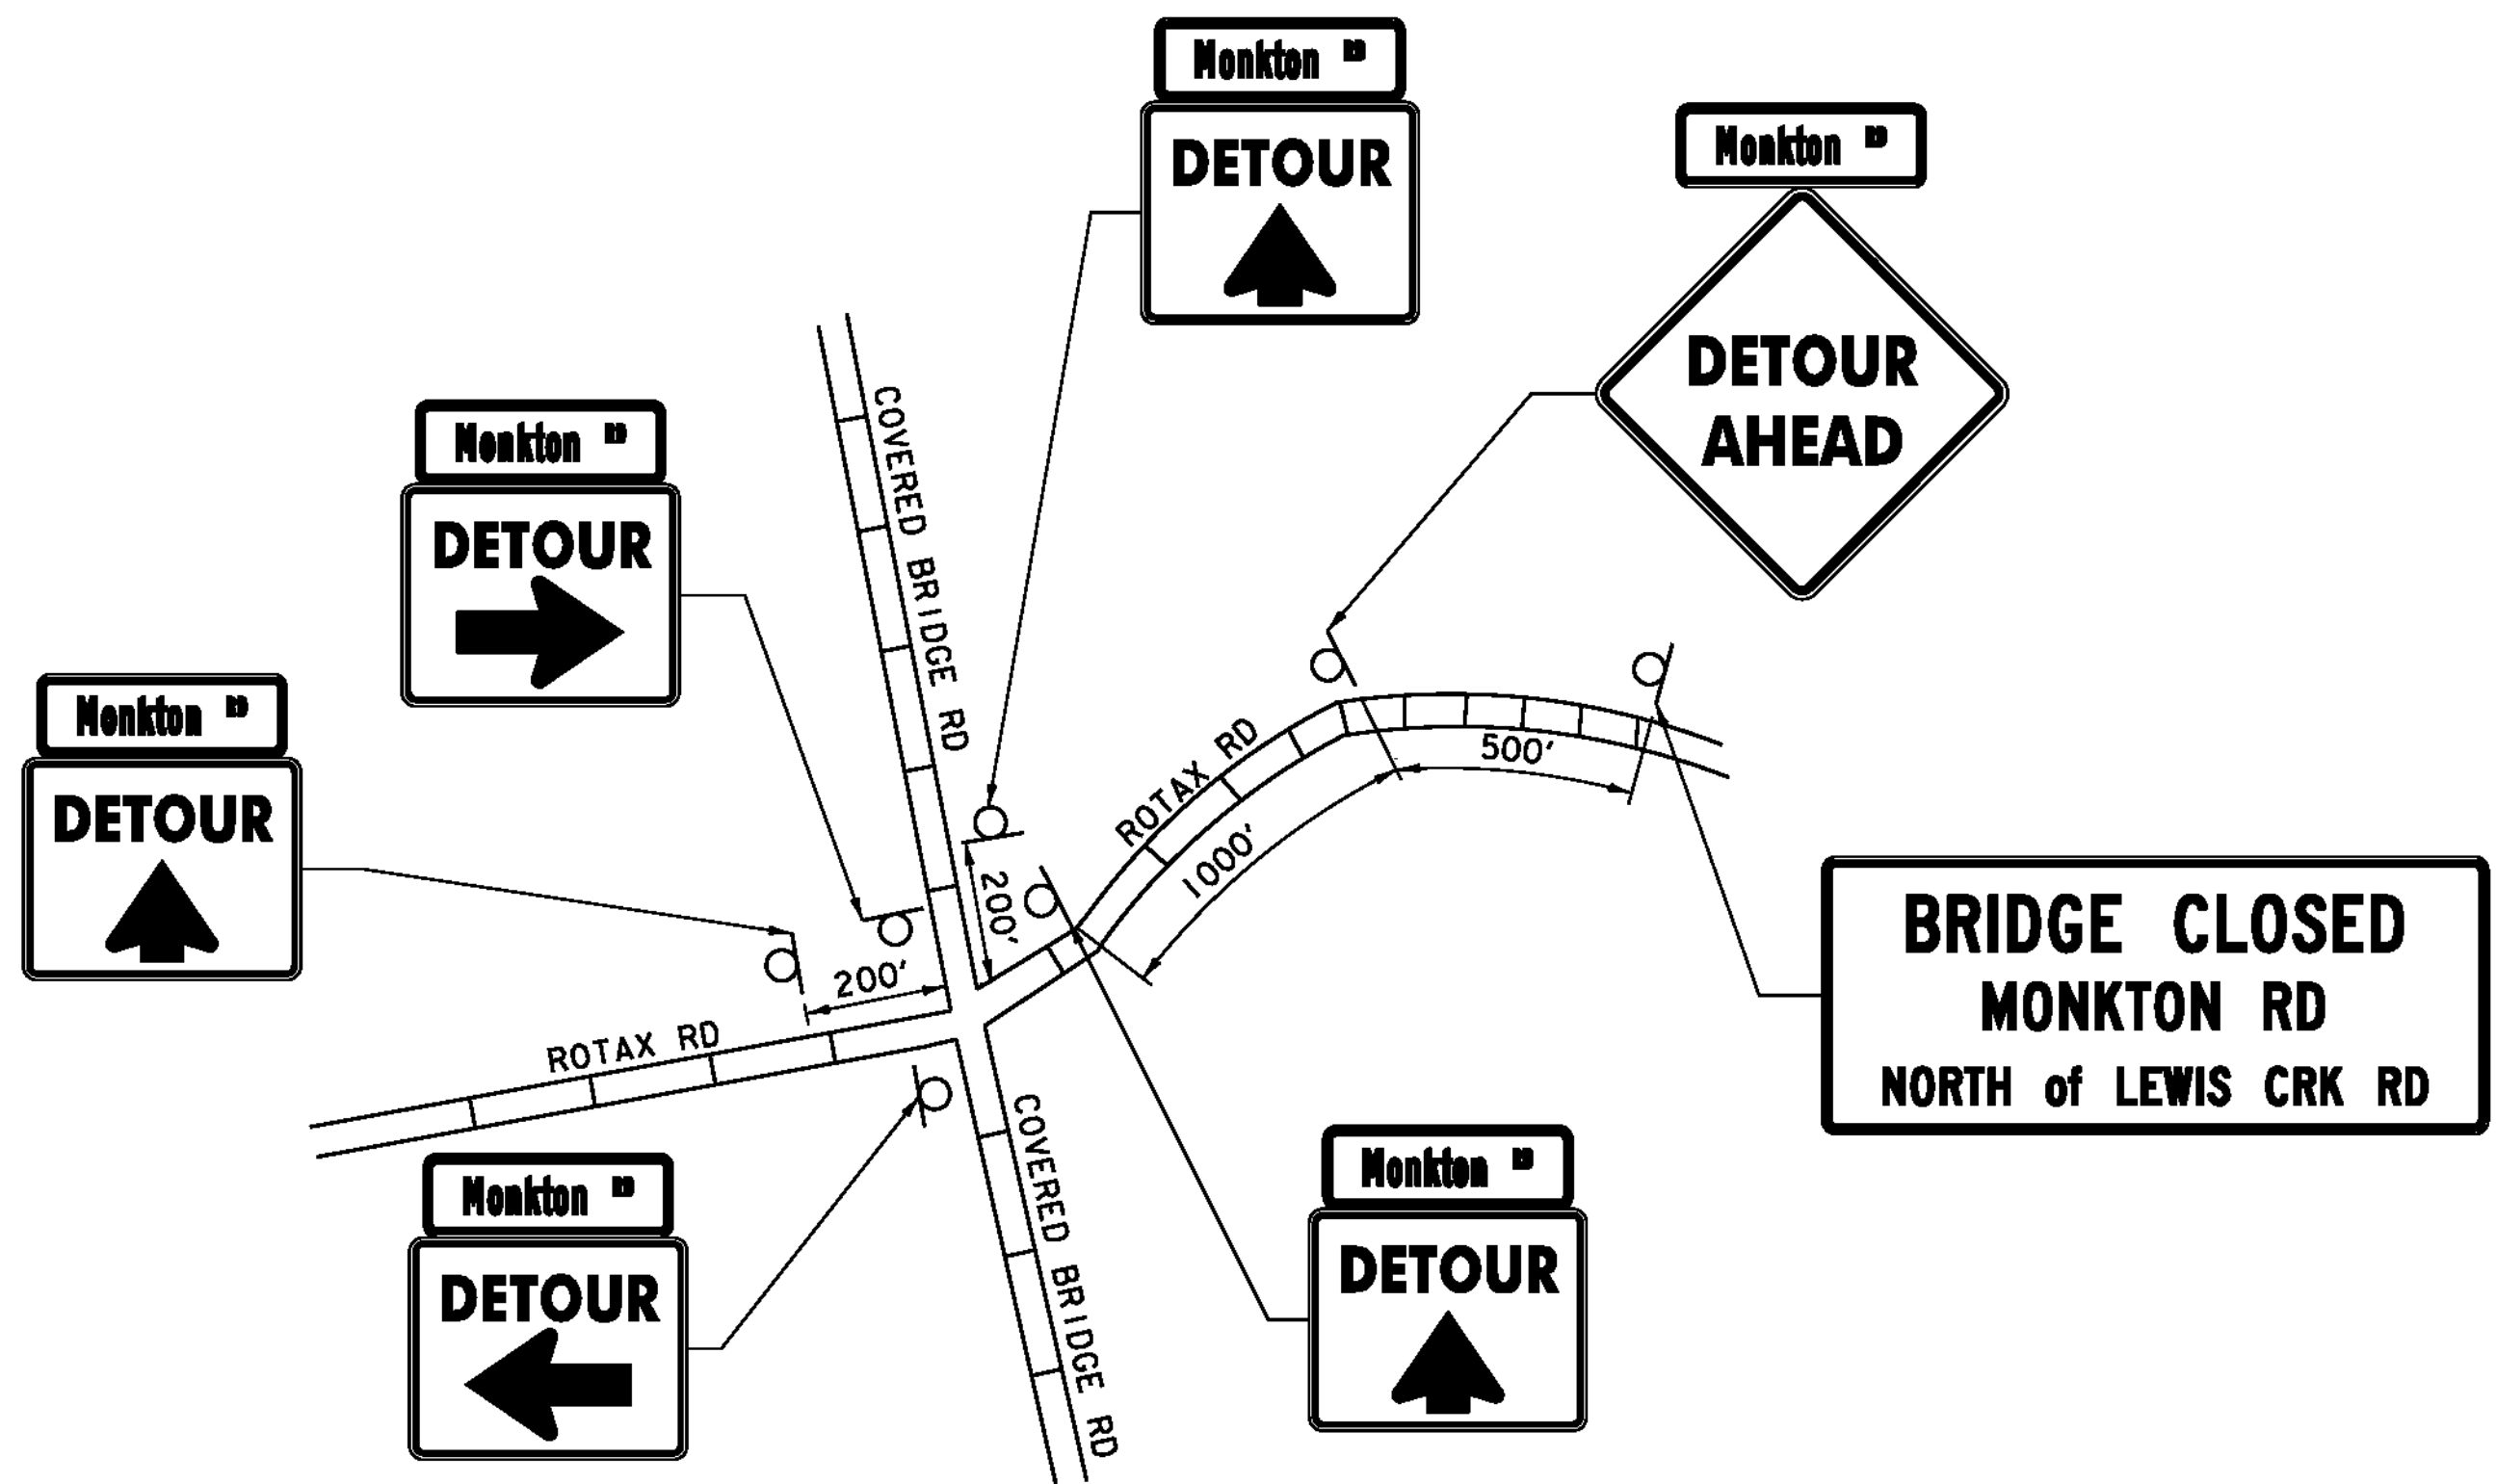

DETAIL G
NOT TO SCALE

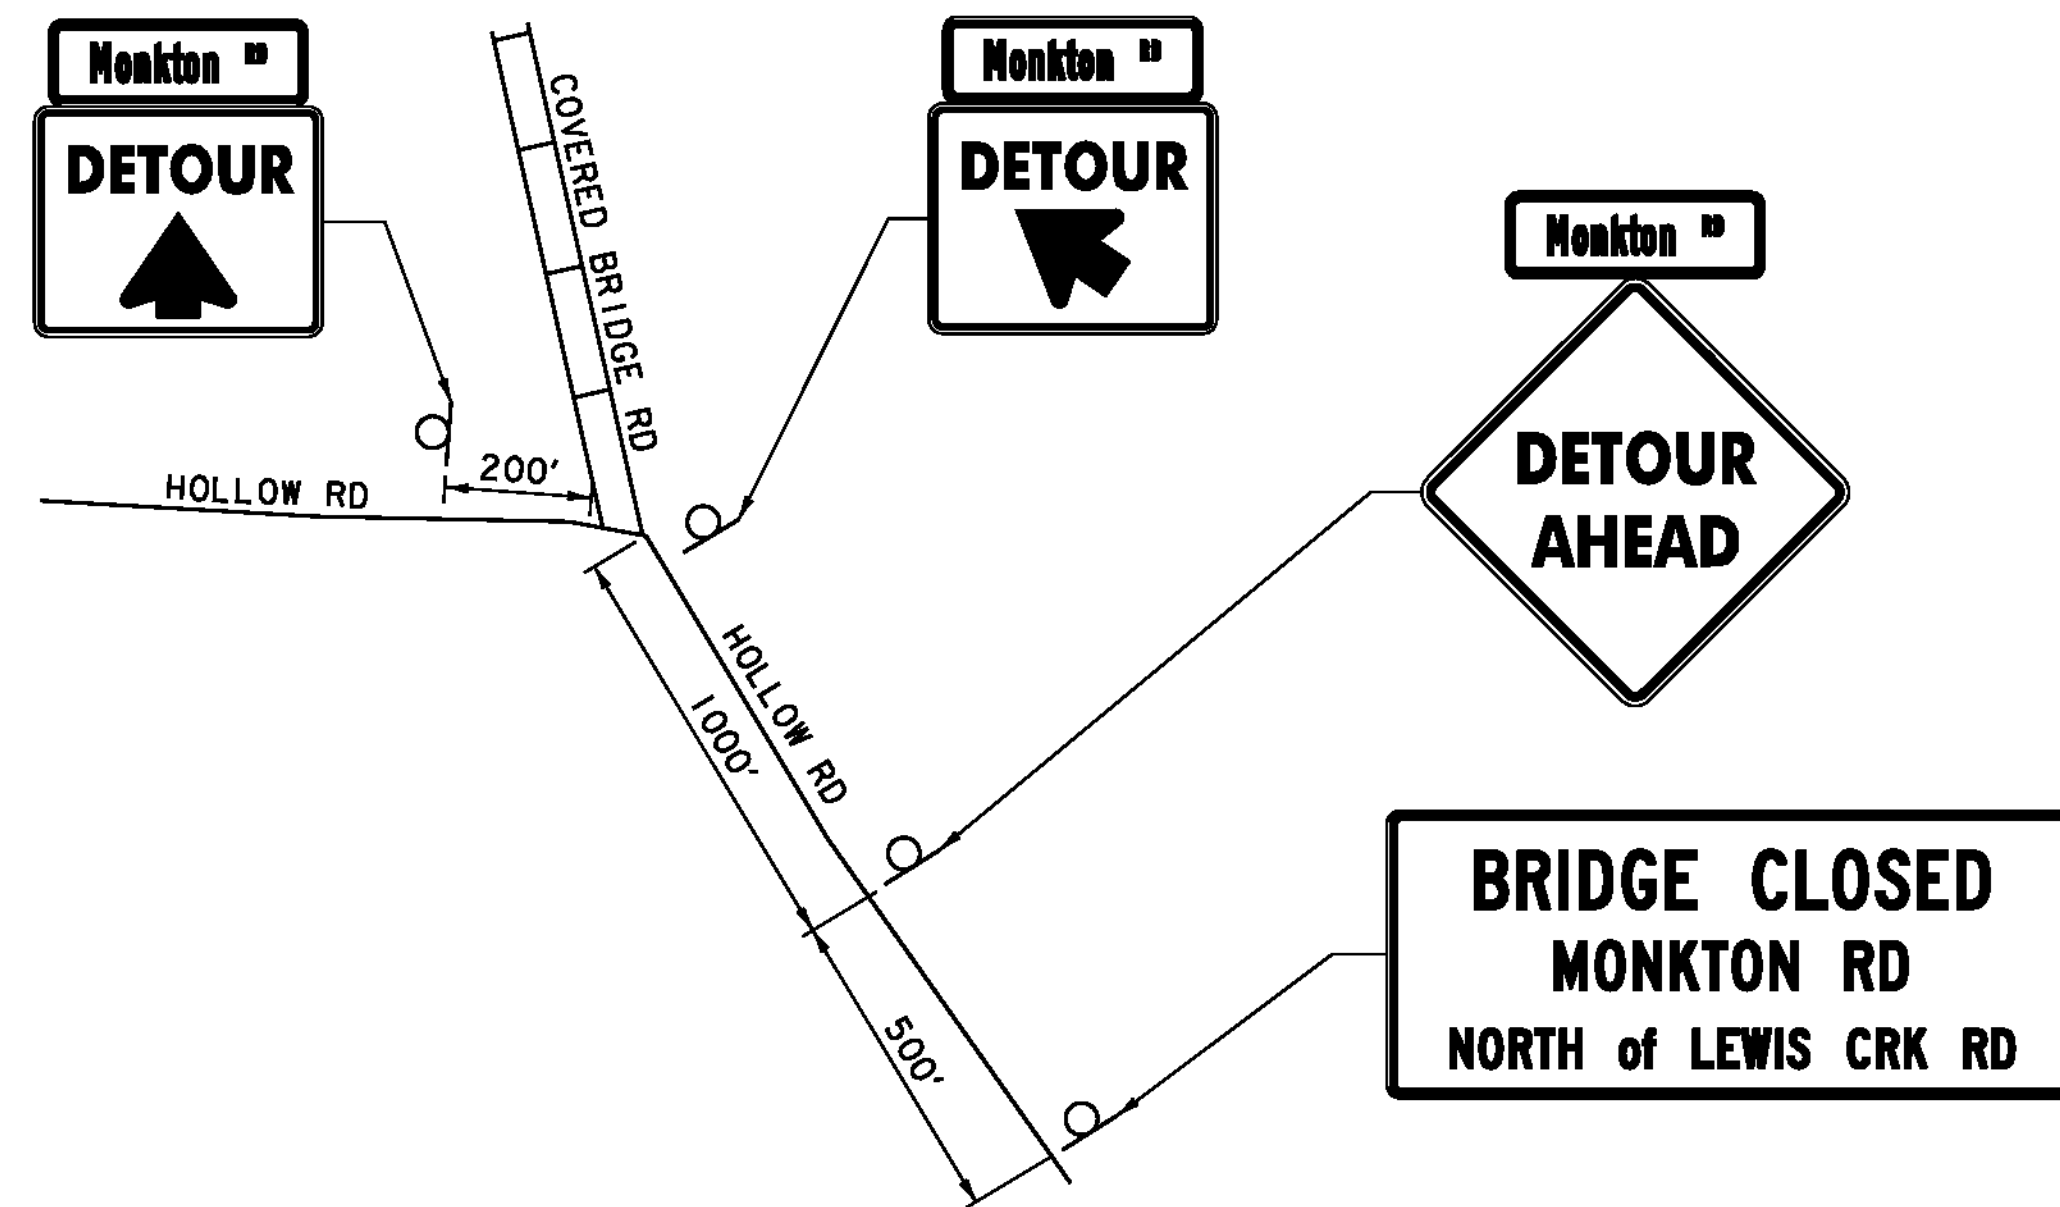

DETAIL F
NOT TO SCALE

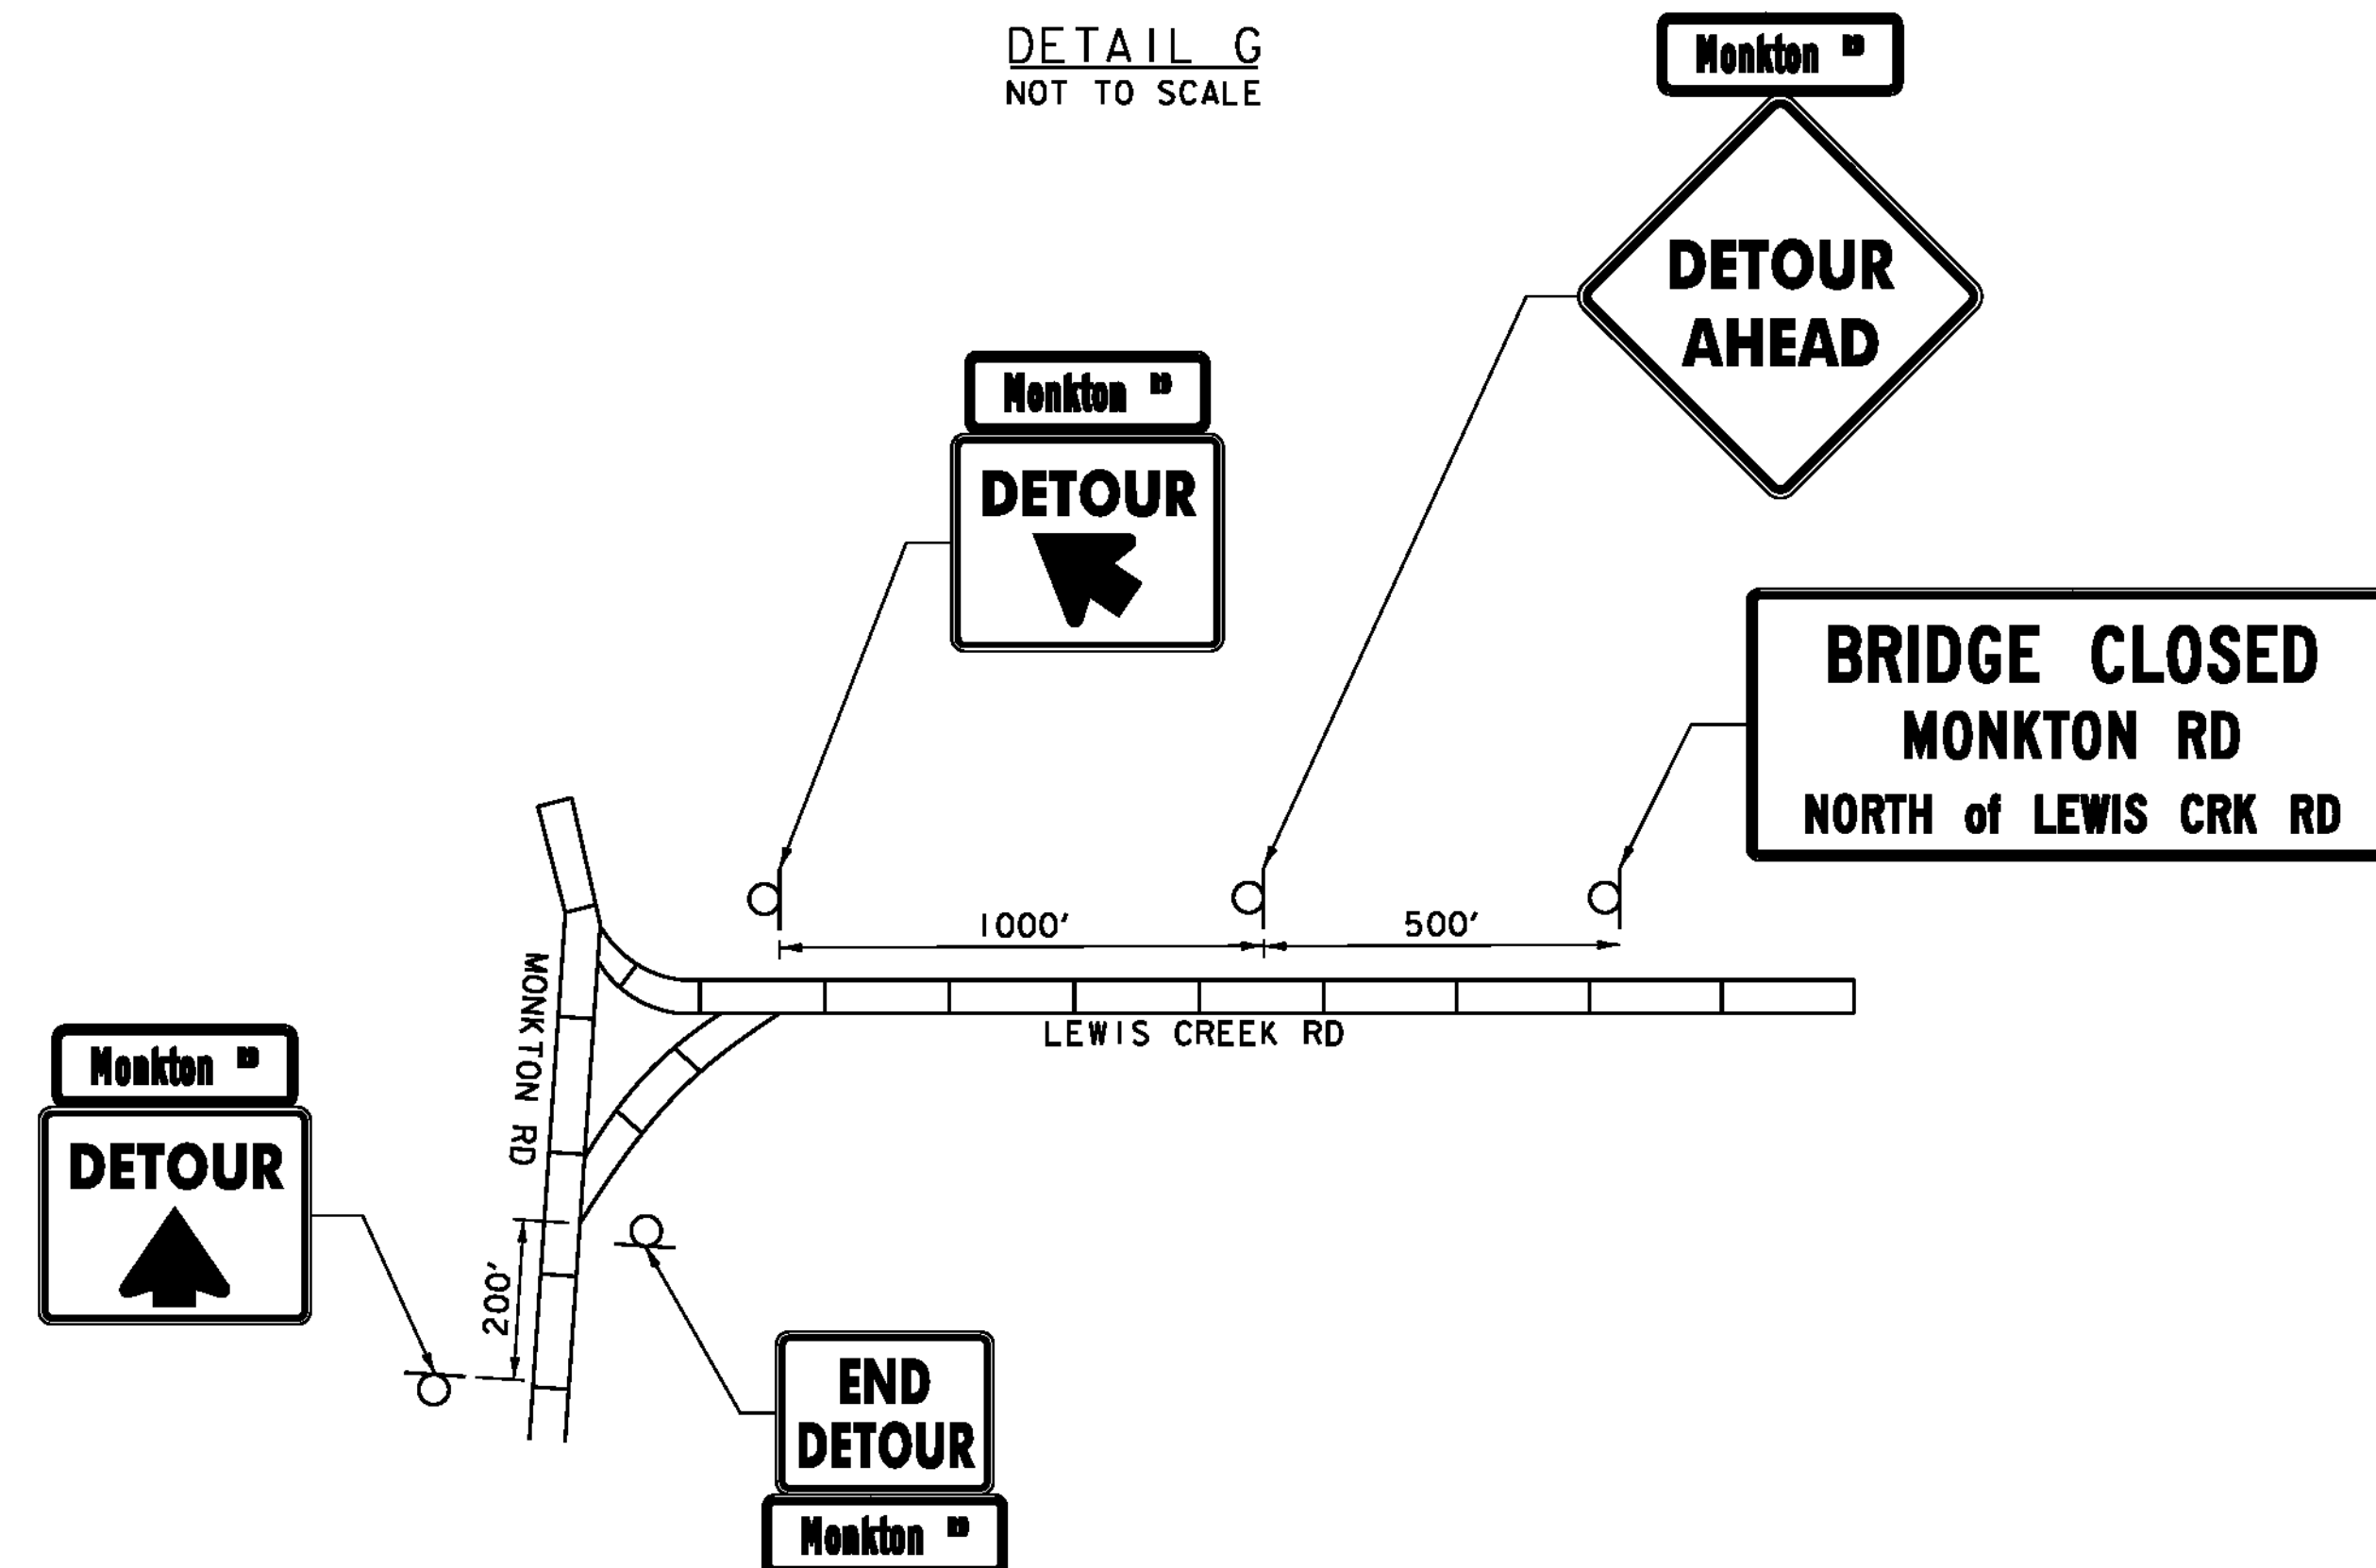

DETAIL H
NOT TO SCALE

DETOUR SIGNING IS RESPONSIBILITY OF THE TOWN. PROPOSED DETOUR ROUTE AND SIGNAGE SHOWN NOT INCLUDED IN CONTRACT. USE FOR TOWN REFERENCE ONLY.

PROJECT NAME: CHARLOTTE
PROJECT NUMBER: BHO 1445(34)

FILE NAME: z06j088details detour.dgn
PROJECT LEADER: M.A. COLGAN
DESIGNED BY: J.W. GOLEK
TRAFFIC CONTROL SHEET (3 OF 5)

PLOT DATE: 10/4/2012
DRAWN BY: J.W. GOLEK
CHECKED BY: B.O. CRONIN
SHEET 17 OF 55