


12+25
END APPROACH



12+00
END PROJECT
STA. 11+94.59
END BRIDGE
STA. 11+92.59

ROADWAY CROSS SECTIONS
SCALE 1" = 10'-0"
STA. 12+00 - STA. 12+25

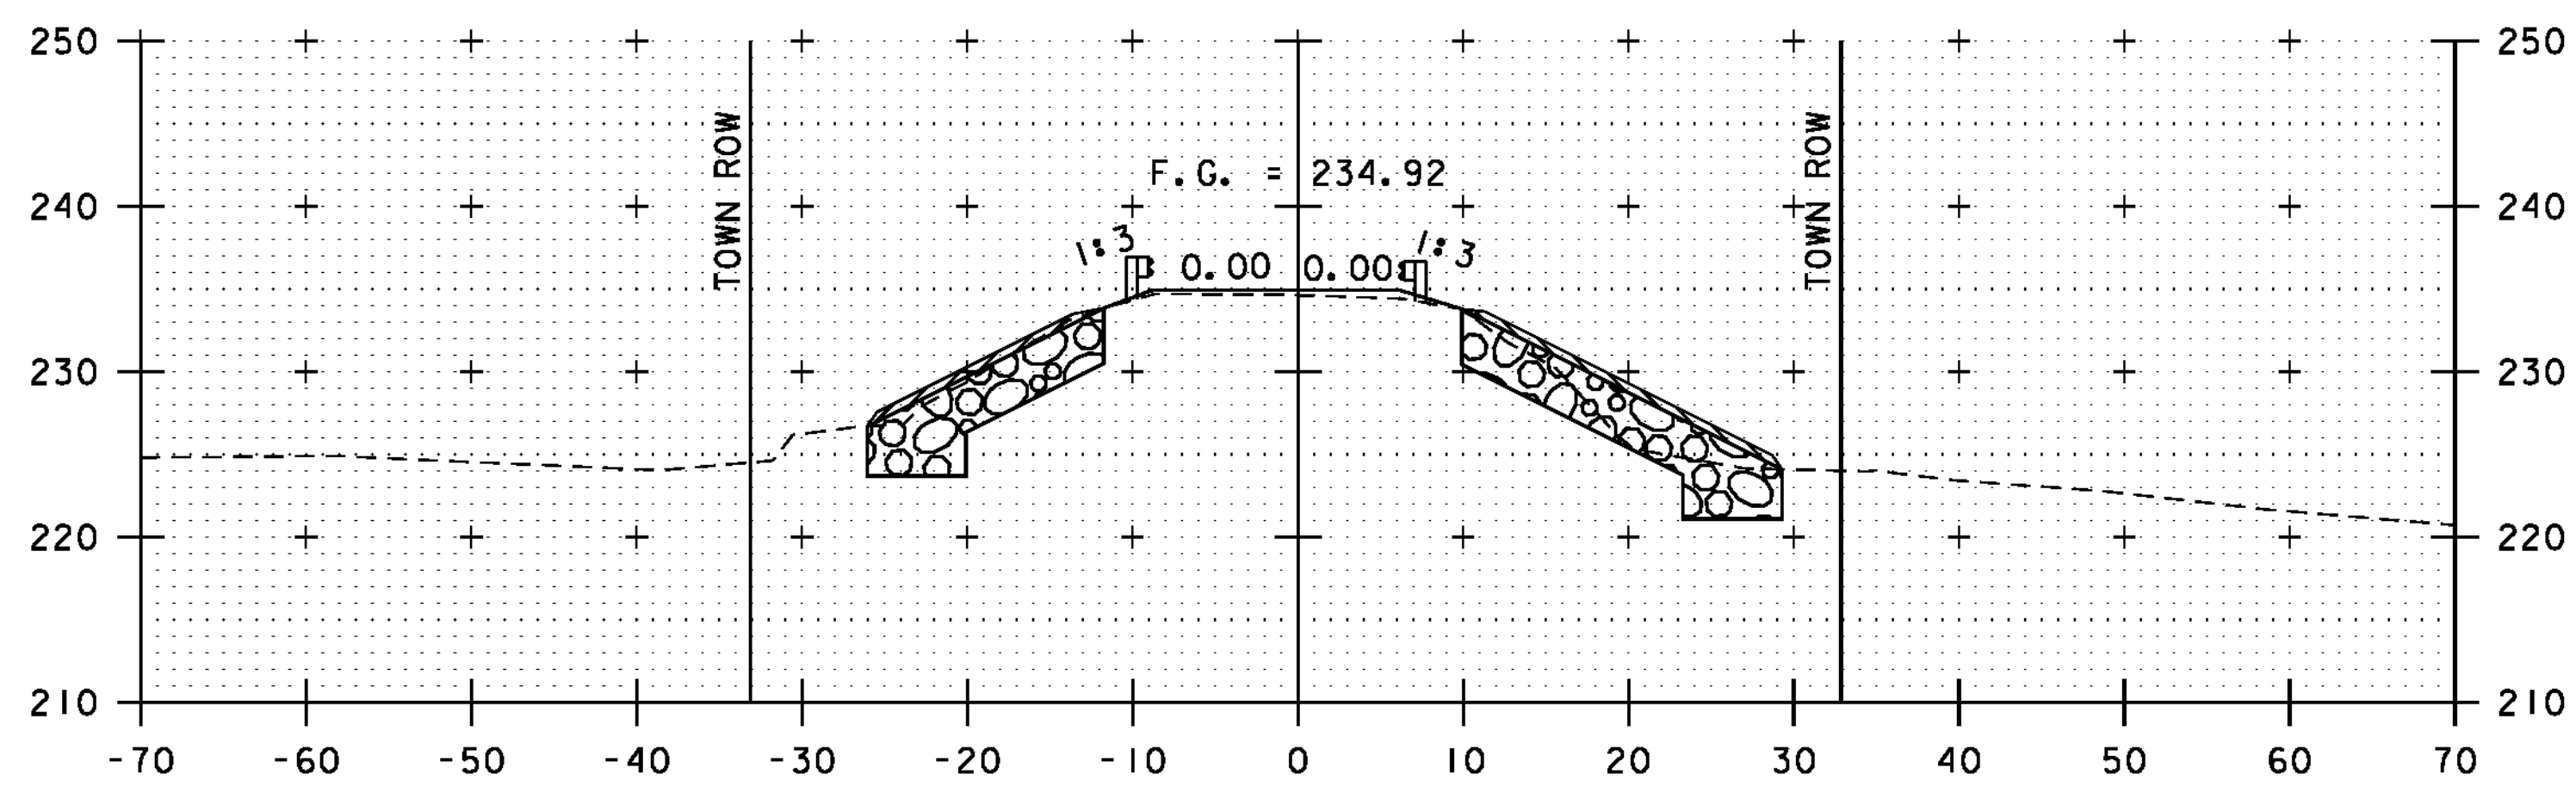

PROJECT NAME: CHARLOTTE
PROJECT NUMBER: BHO 1445(34)

FILE NAME: z06j088xs.dgn
PROJECT LEADER: M.A. COLGAN
DESIGNED BY: B.O. CRONIN
ROADWAY CROSS SECTIONS (2 OF 2)

PLOT DATE: 10/4/2012
DRAWN BY: E.A. FIALA
CHECKED BY: S.E. BURBANK
SHEET 52 OF 55