




50+50

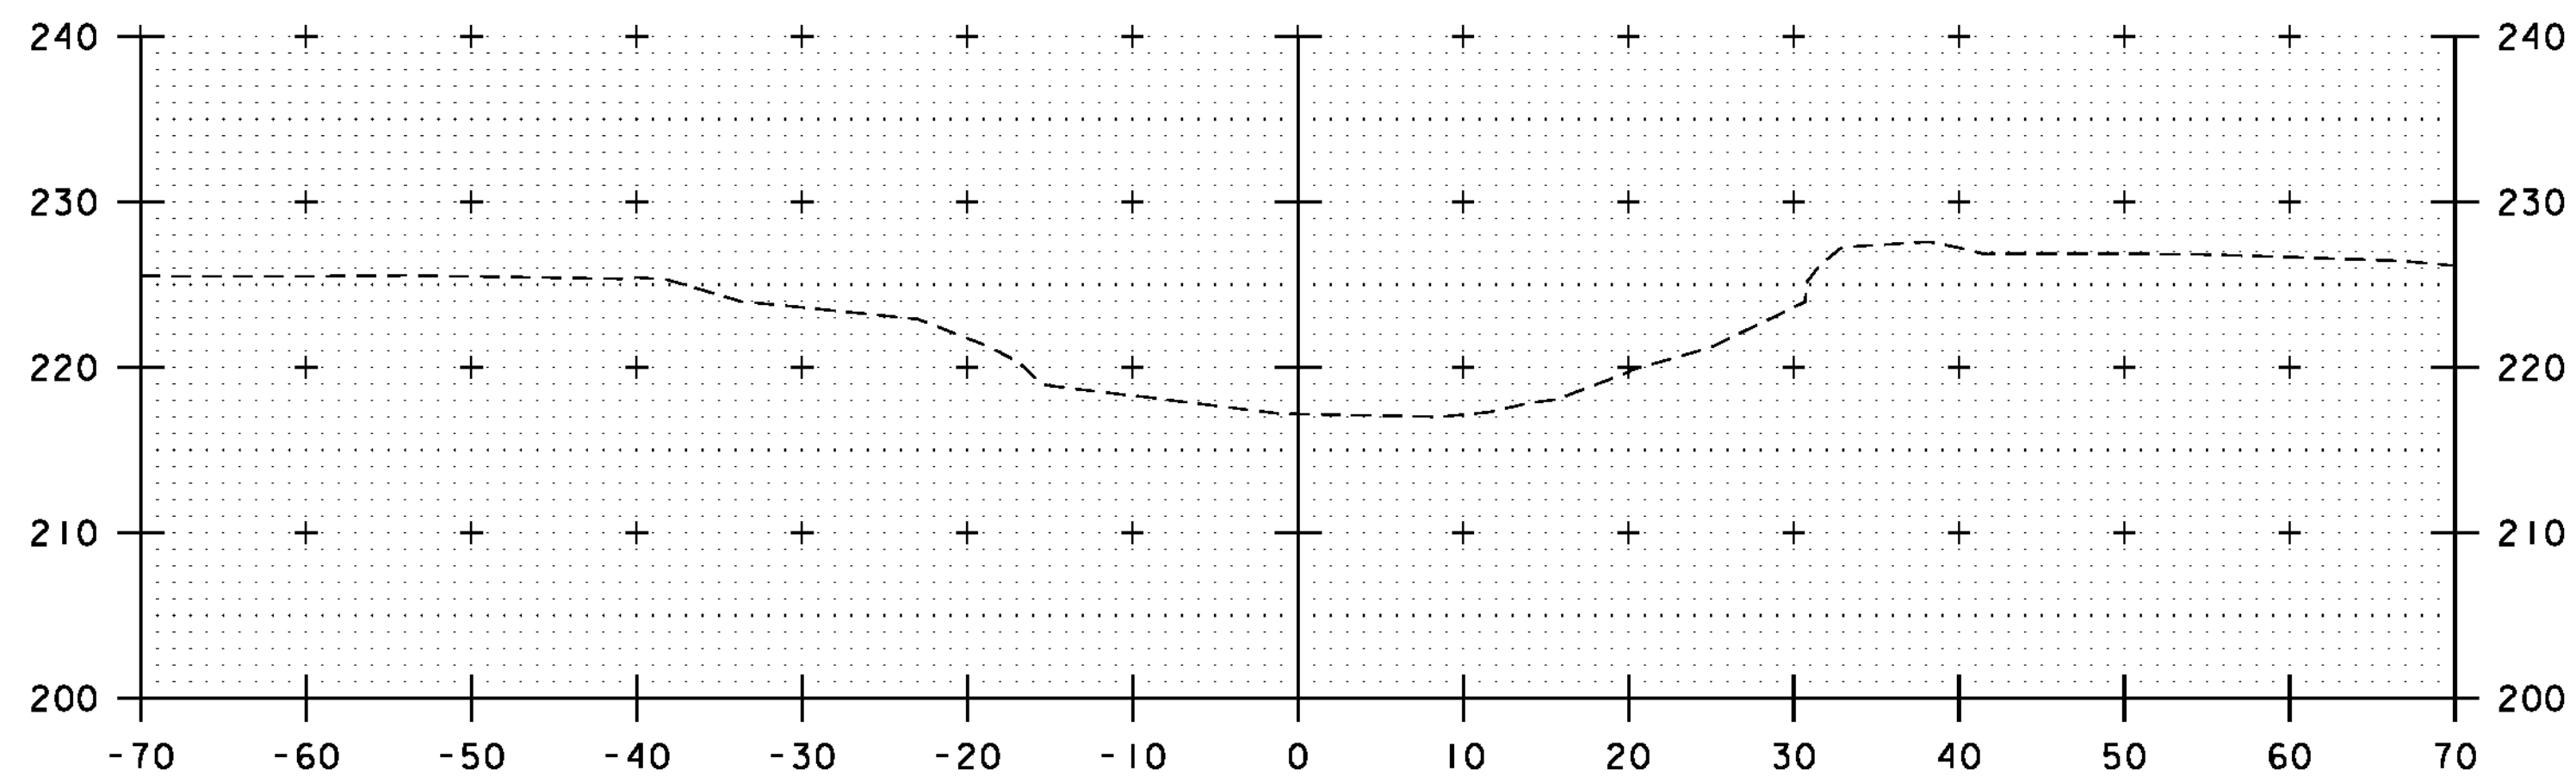


50+25

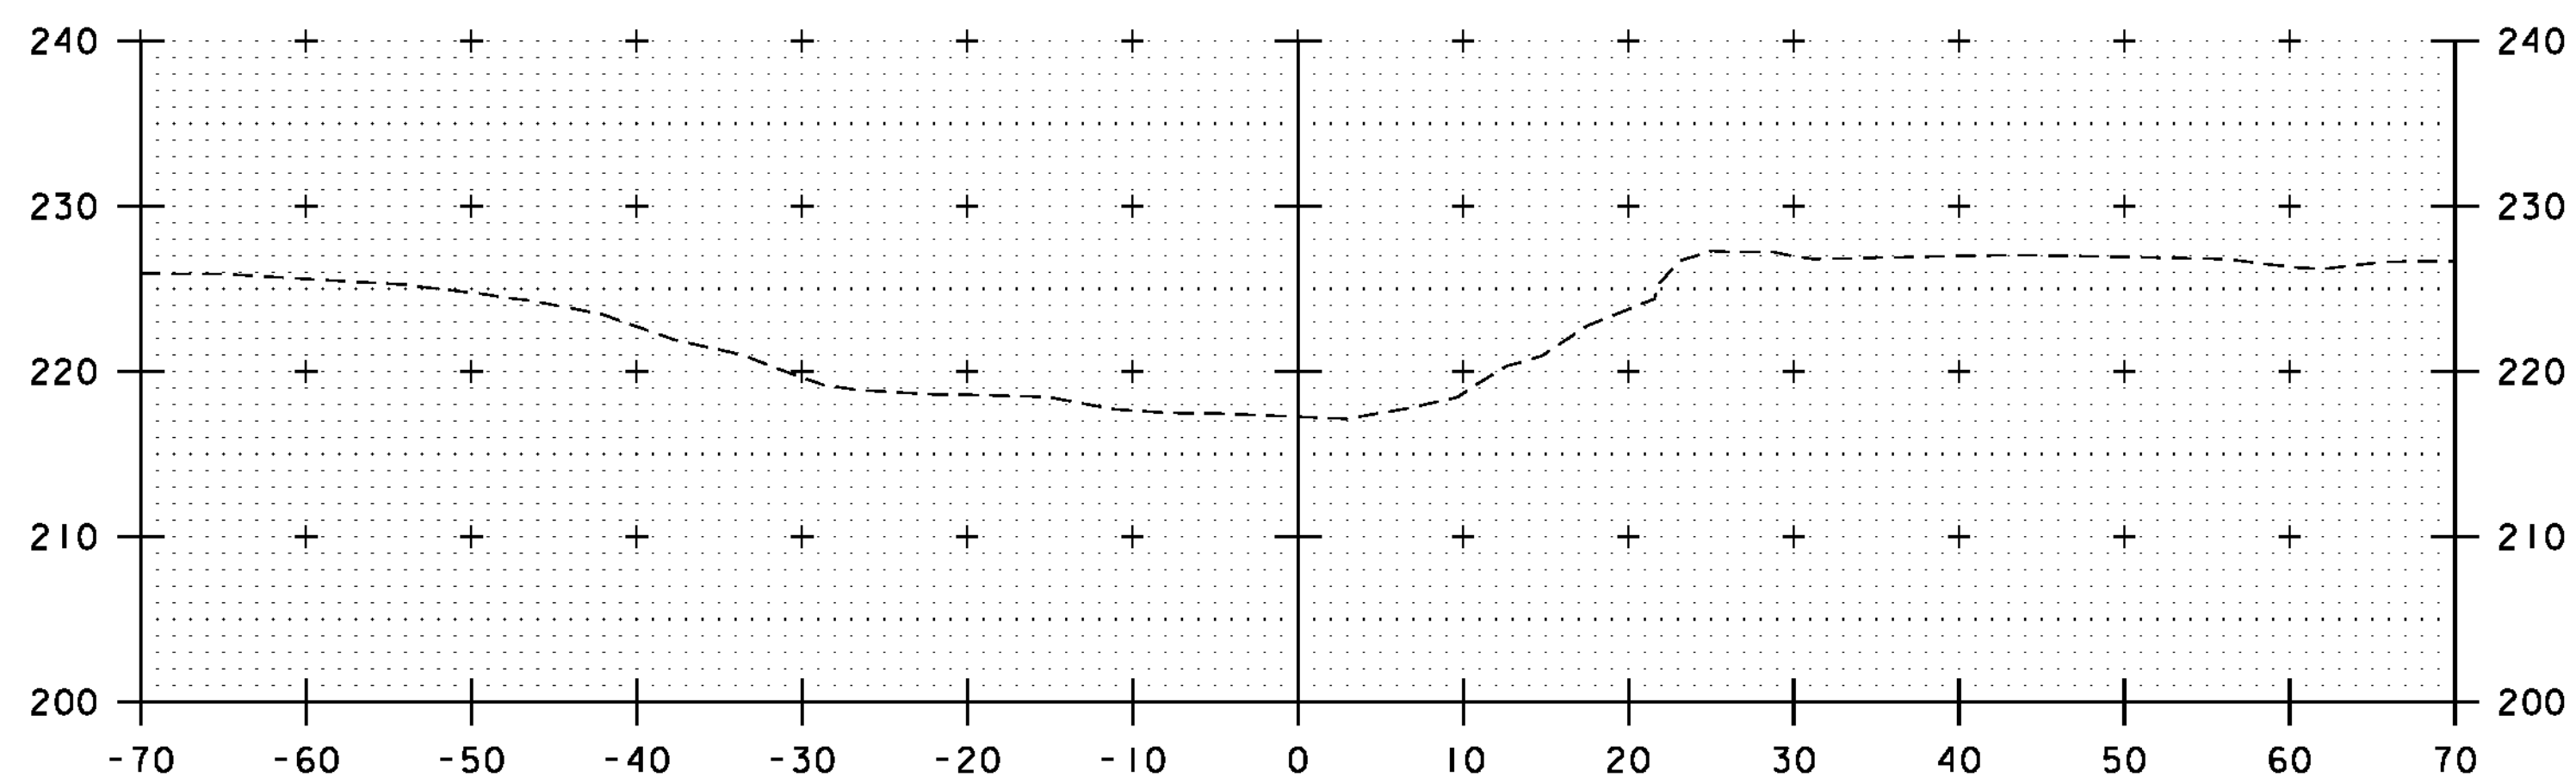

50+00

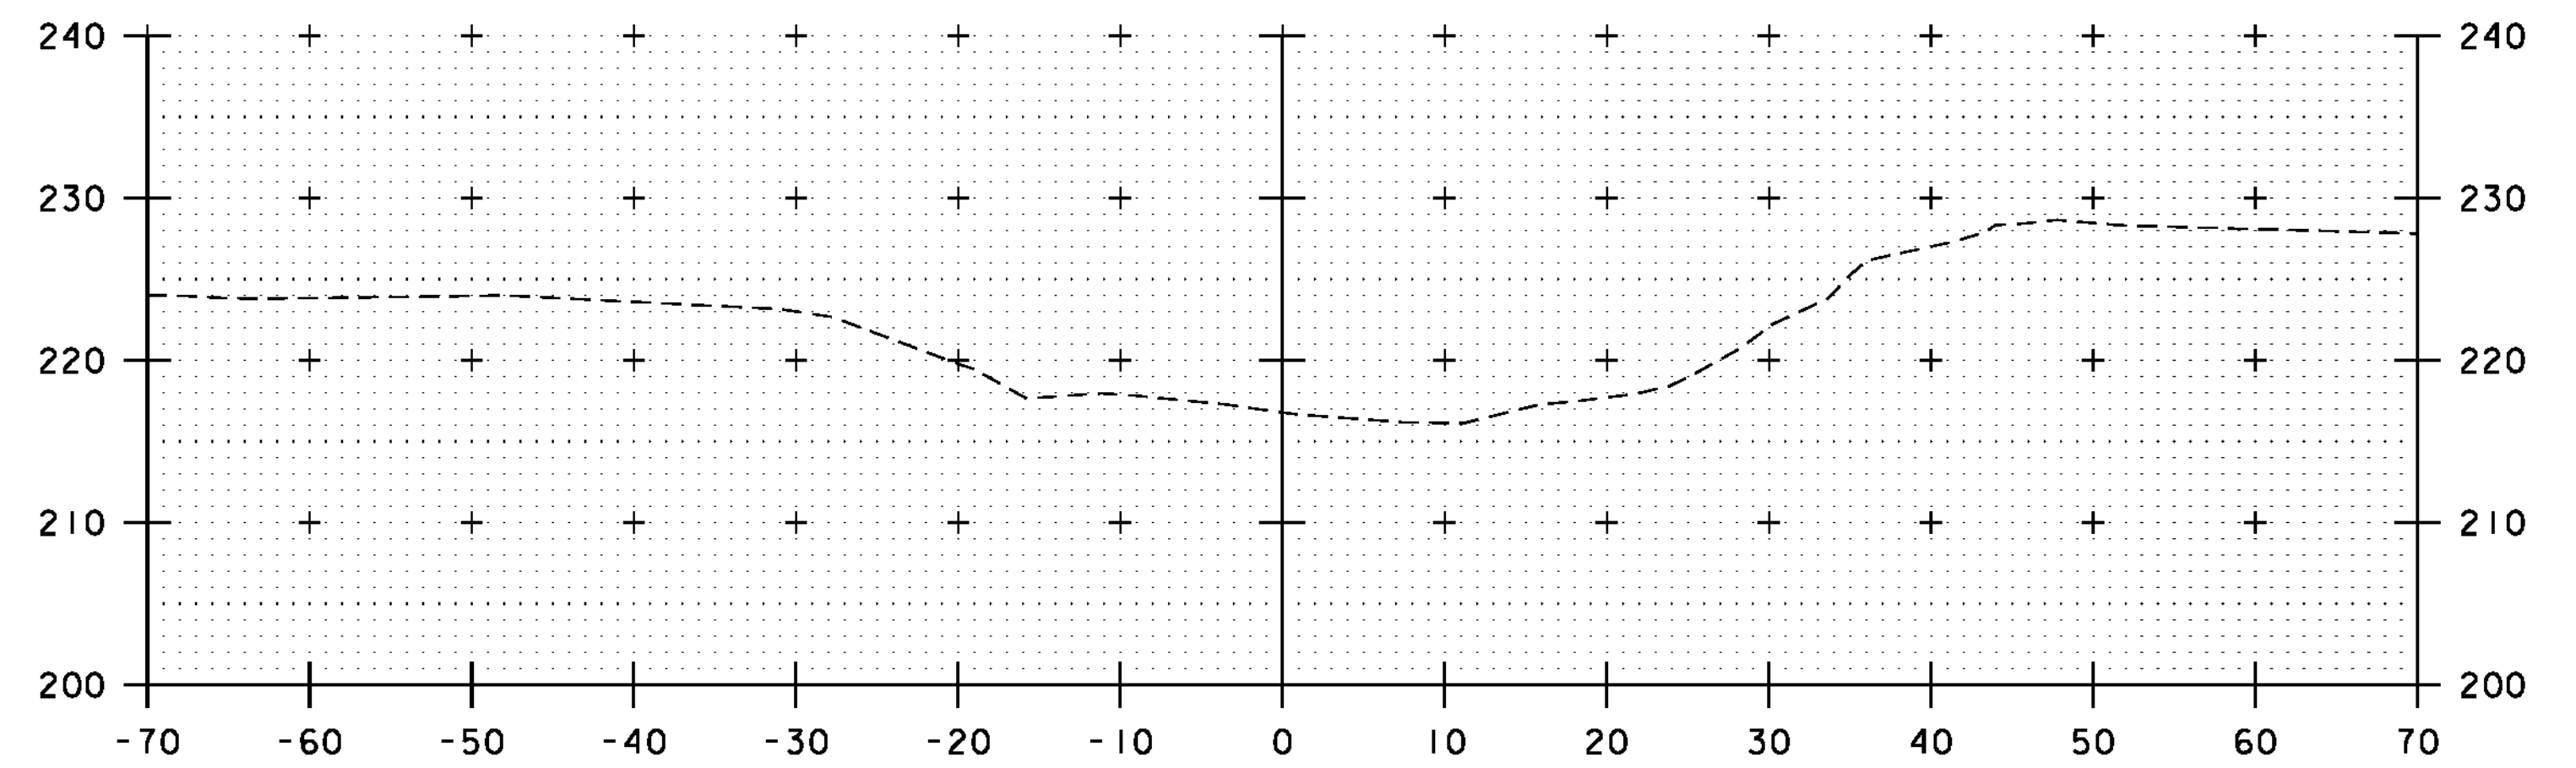

51+00

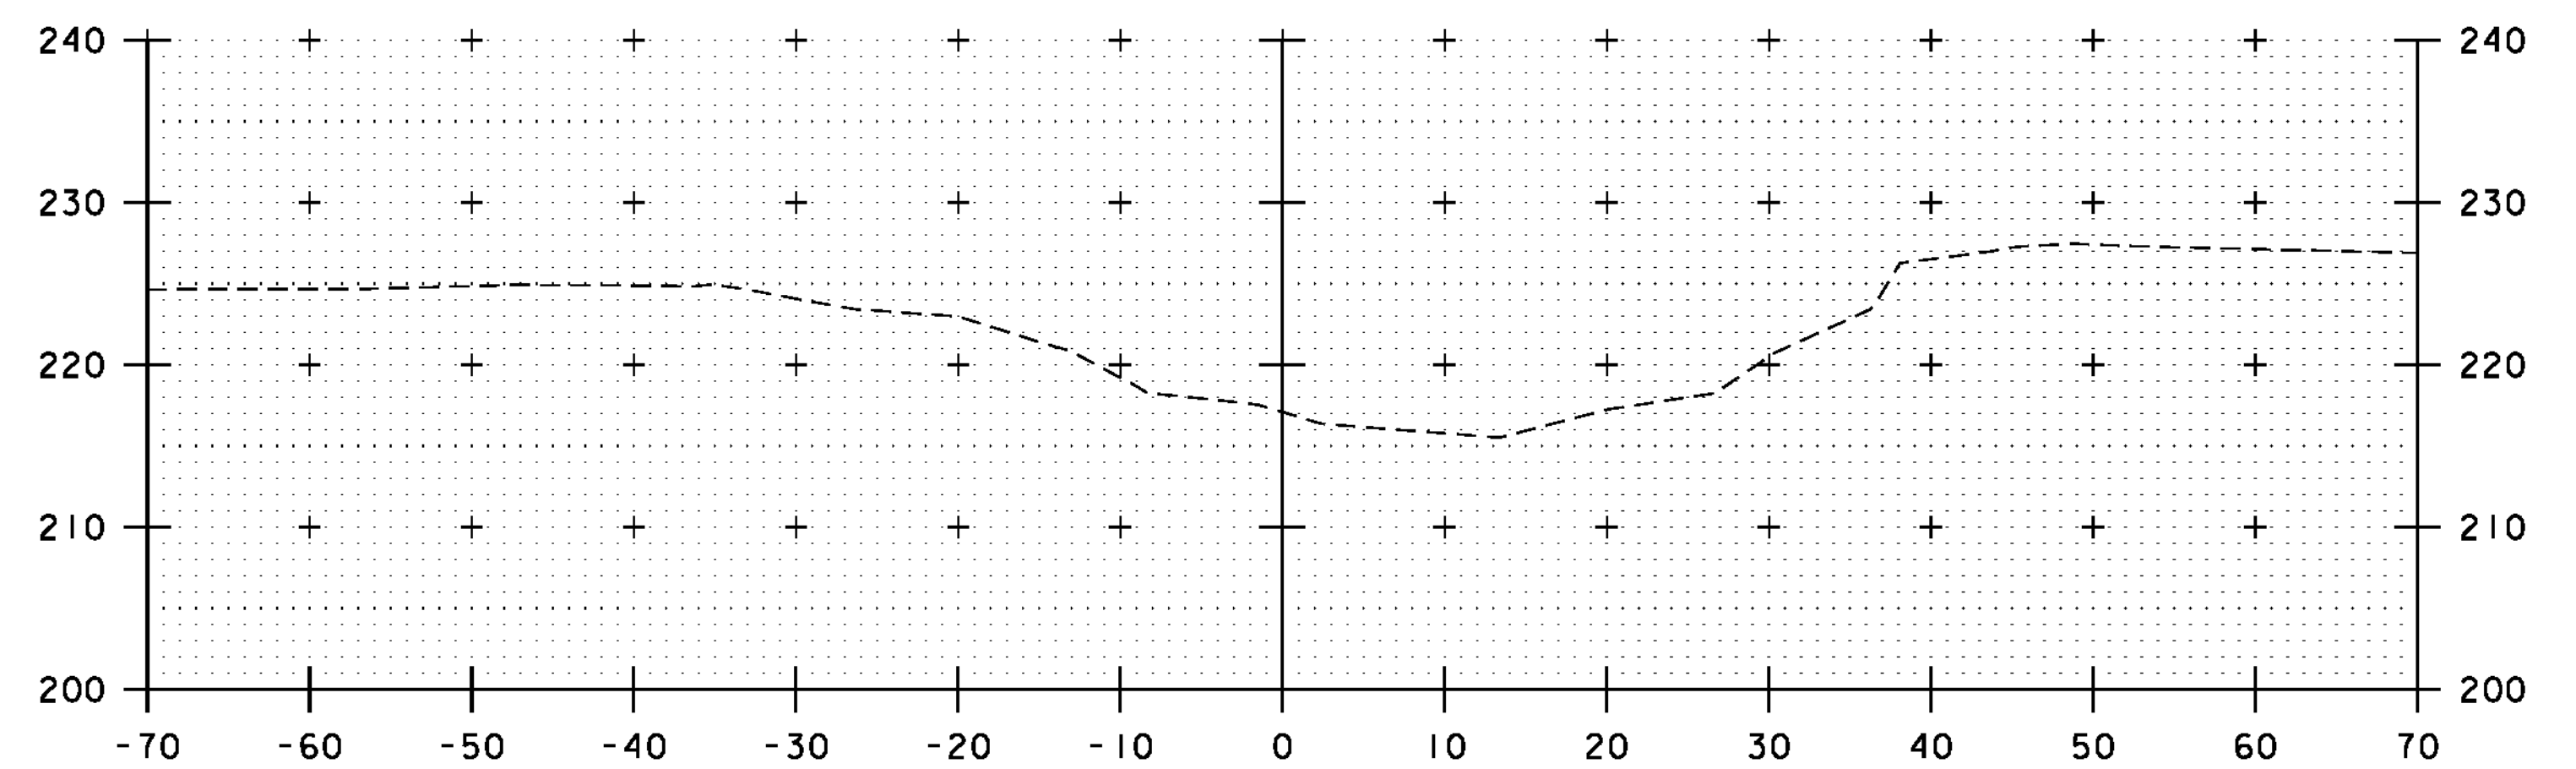

50+75

CHANNEL CROSS SECTIONS
 SCALE 1" = 10'-0"
 STA. 50+00 - STA. 51+00



| | |
|---------------------------------|-------------------------|
| PROJECT NAME: CHARLOTTE | PLOT DATE: 10/4/2012 |
| PROJECT NUMBER: BHO 1445(34) | DRAWN BY: E.A. FIALA |
| FILE NAME: z06j088xs.dgn | CHECKED BY: B.O. CRONIN |
| PROJECT LEADER: MA.A. COLGAN | SHEET 53 OF 55 |
| DESIGNED BY: E.A. FIALA | |
| CHANNEL CROSS SECTIONS (1 OF 3) | |