



STA. 51+60.24 - 51+70.52 LT
 BEGIN/END STONE FILL, TYPE III
 UNCLASSIFIED CHANNEL EXCAVATION
 GEOTEXTILE UNDER STONE FILL
 GRUBBING MATERIAL

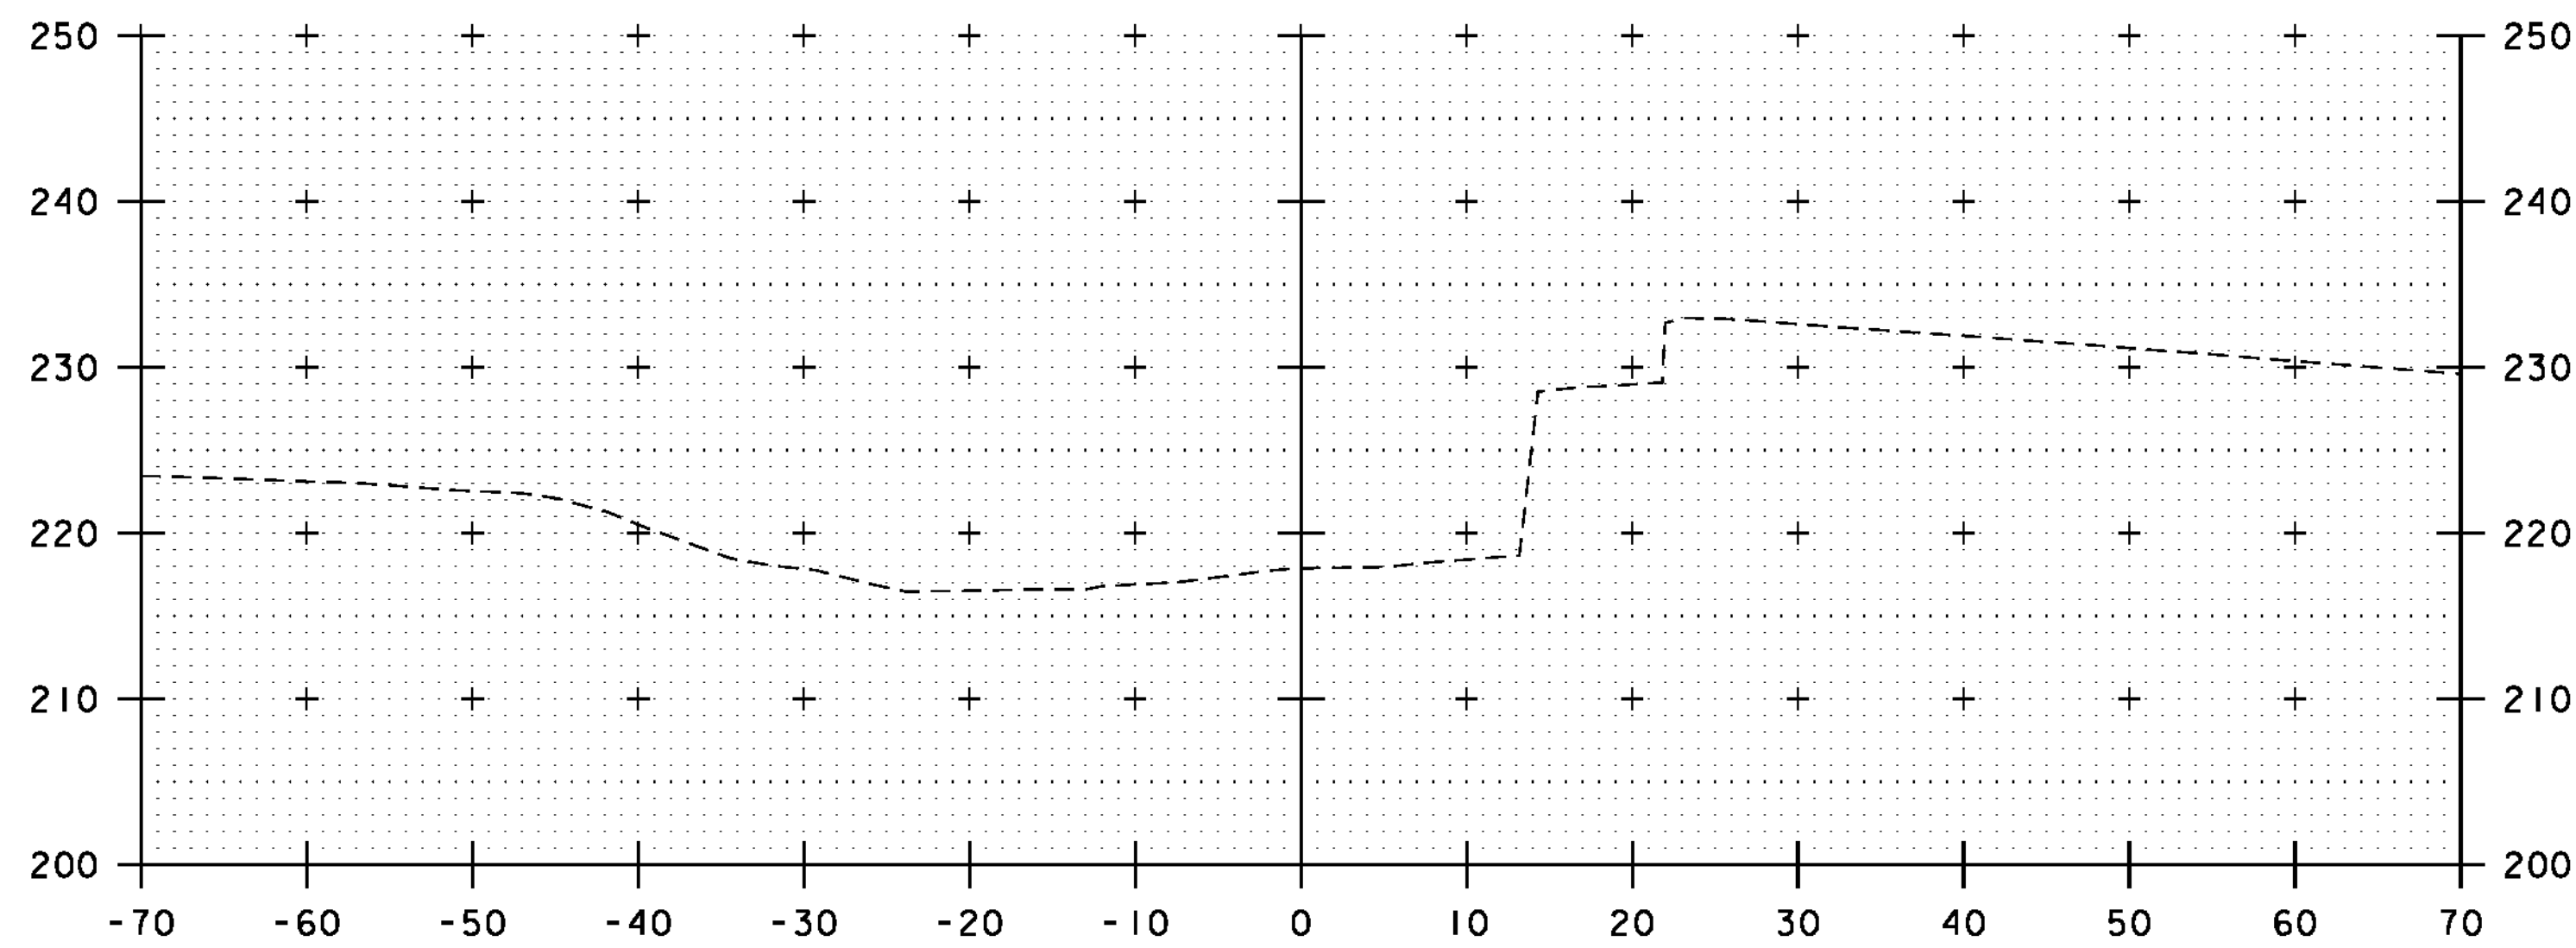

51+50


STA. 51+48.79 RT
 END STONE FILL, TYPE I
 UNCLASSIFIED CHANNEL EXCAVATION
 GEOTEXTILE UNDER STONE FILL
 GRUBBING MATERIAL

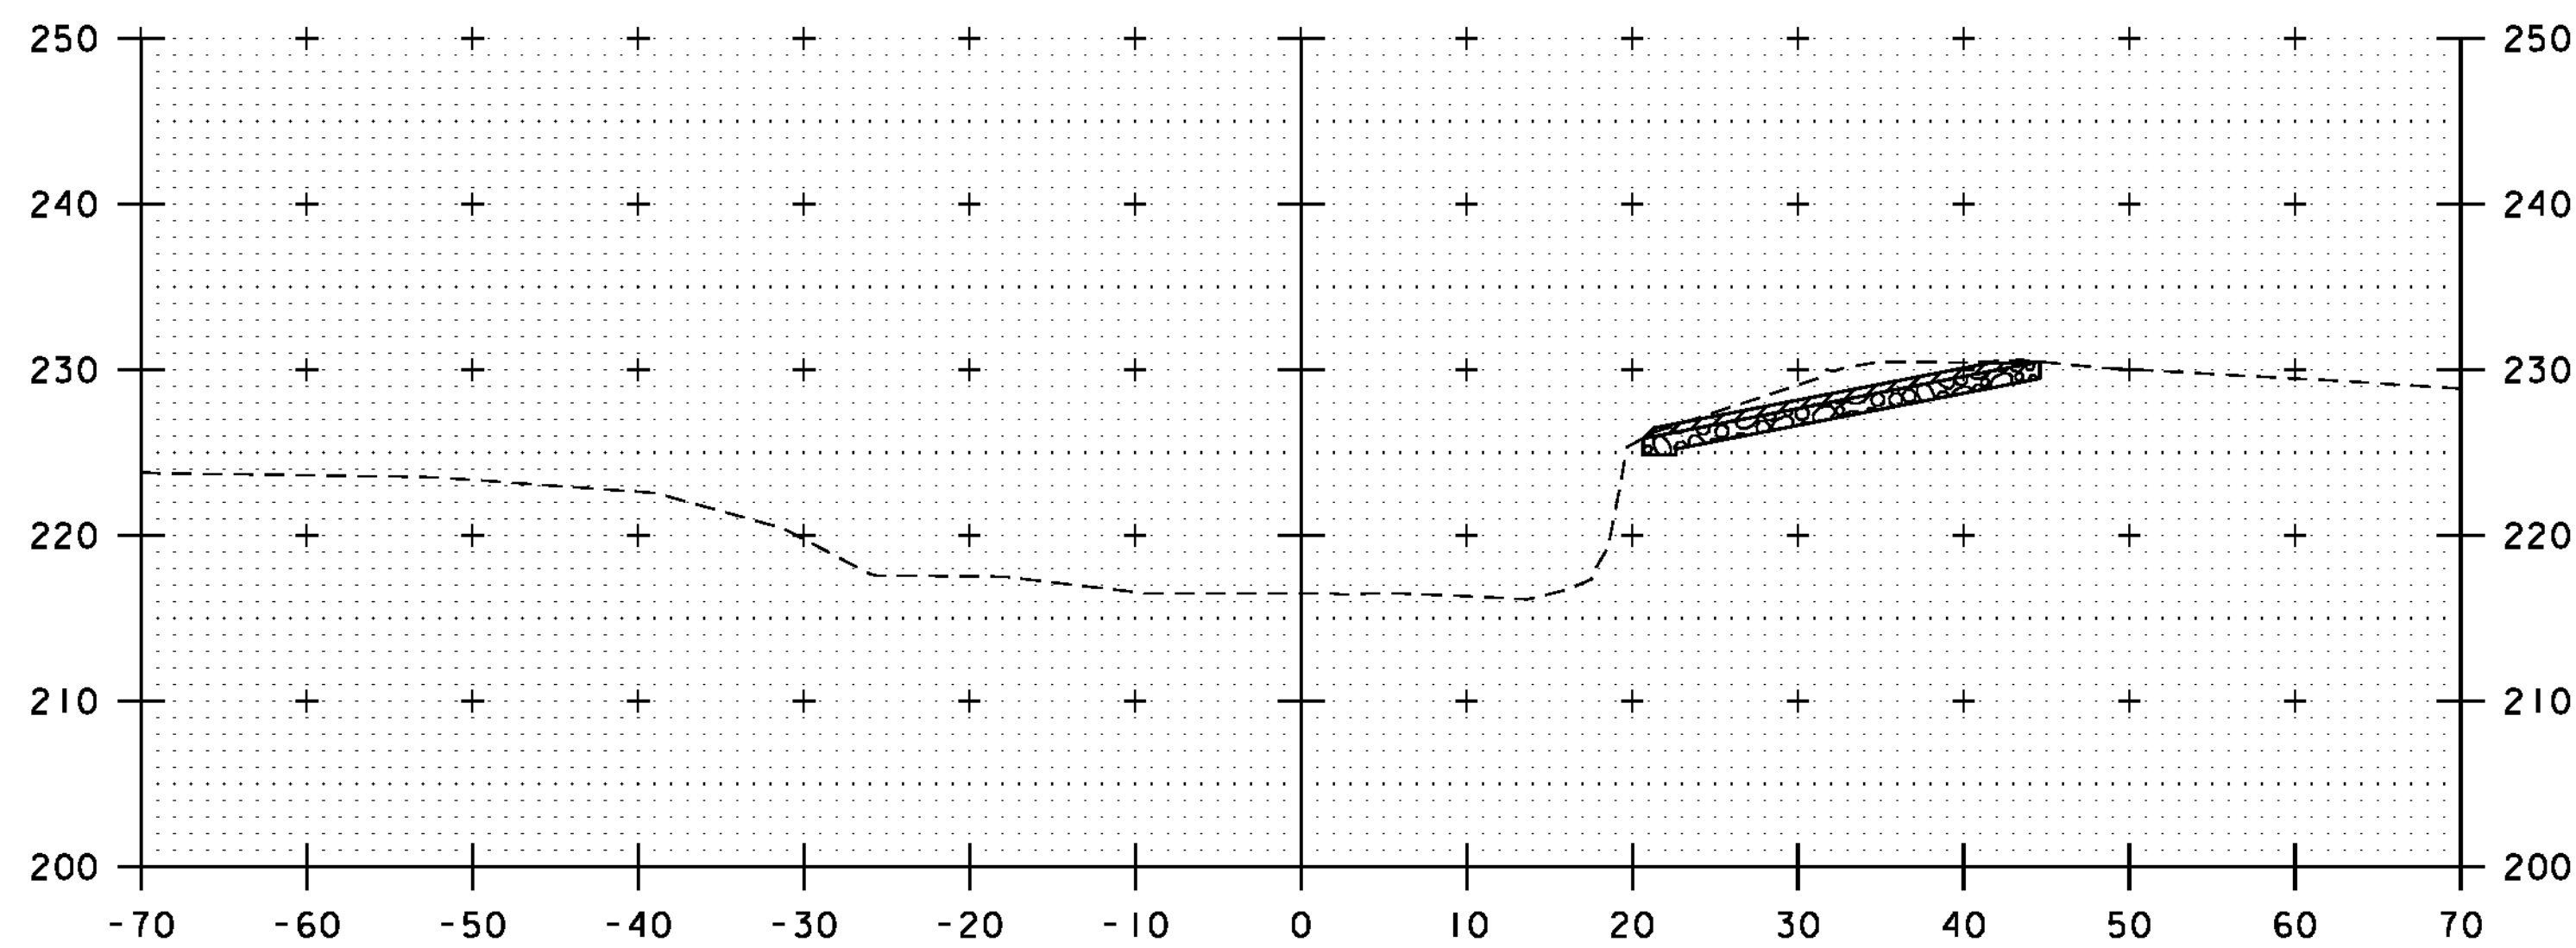

51+25


STA. 51+14.67 RT
 BEGIN STONE FILL, TYPE I
 UNCLASSIFIED CHANNEL EXCAVATION
 GEOTEXTILE UNDER STONE FILL
 GRUBBING MATERIAL

STA. 52+13.47 LT
 END STONE FILL, TYPE III
 UNCLASSIFIED CHANNEL EXCAVATION
 GEOTEXTILE UNDER STONE FILL
 GRUBBING MATERIAL

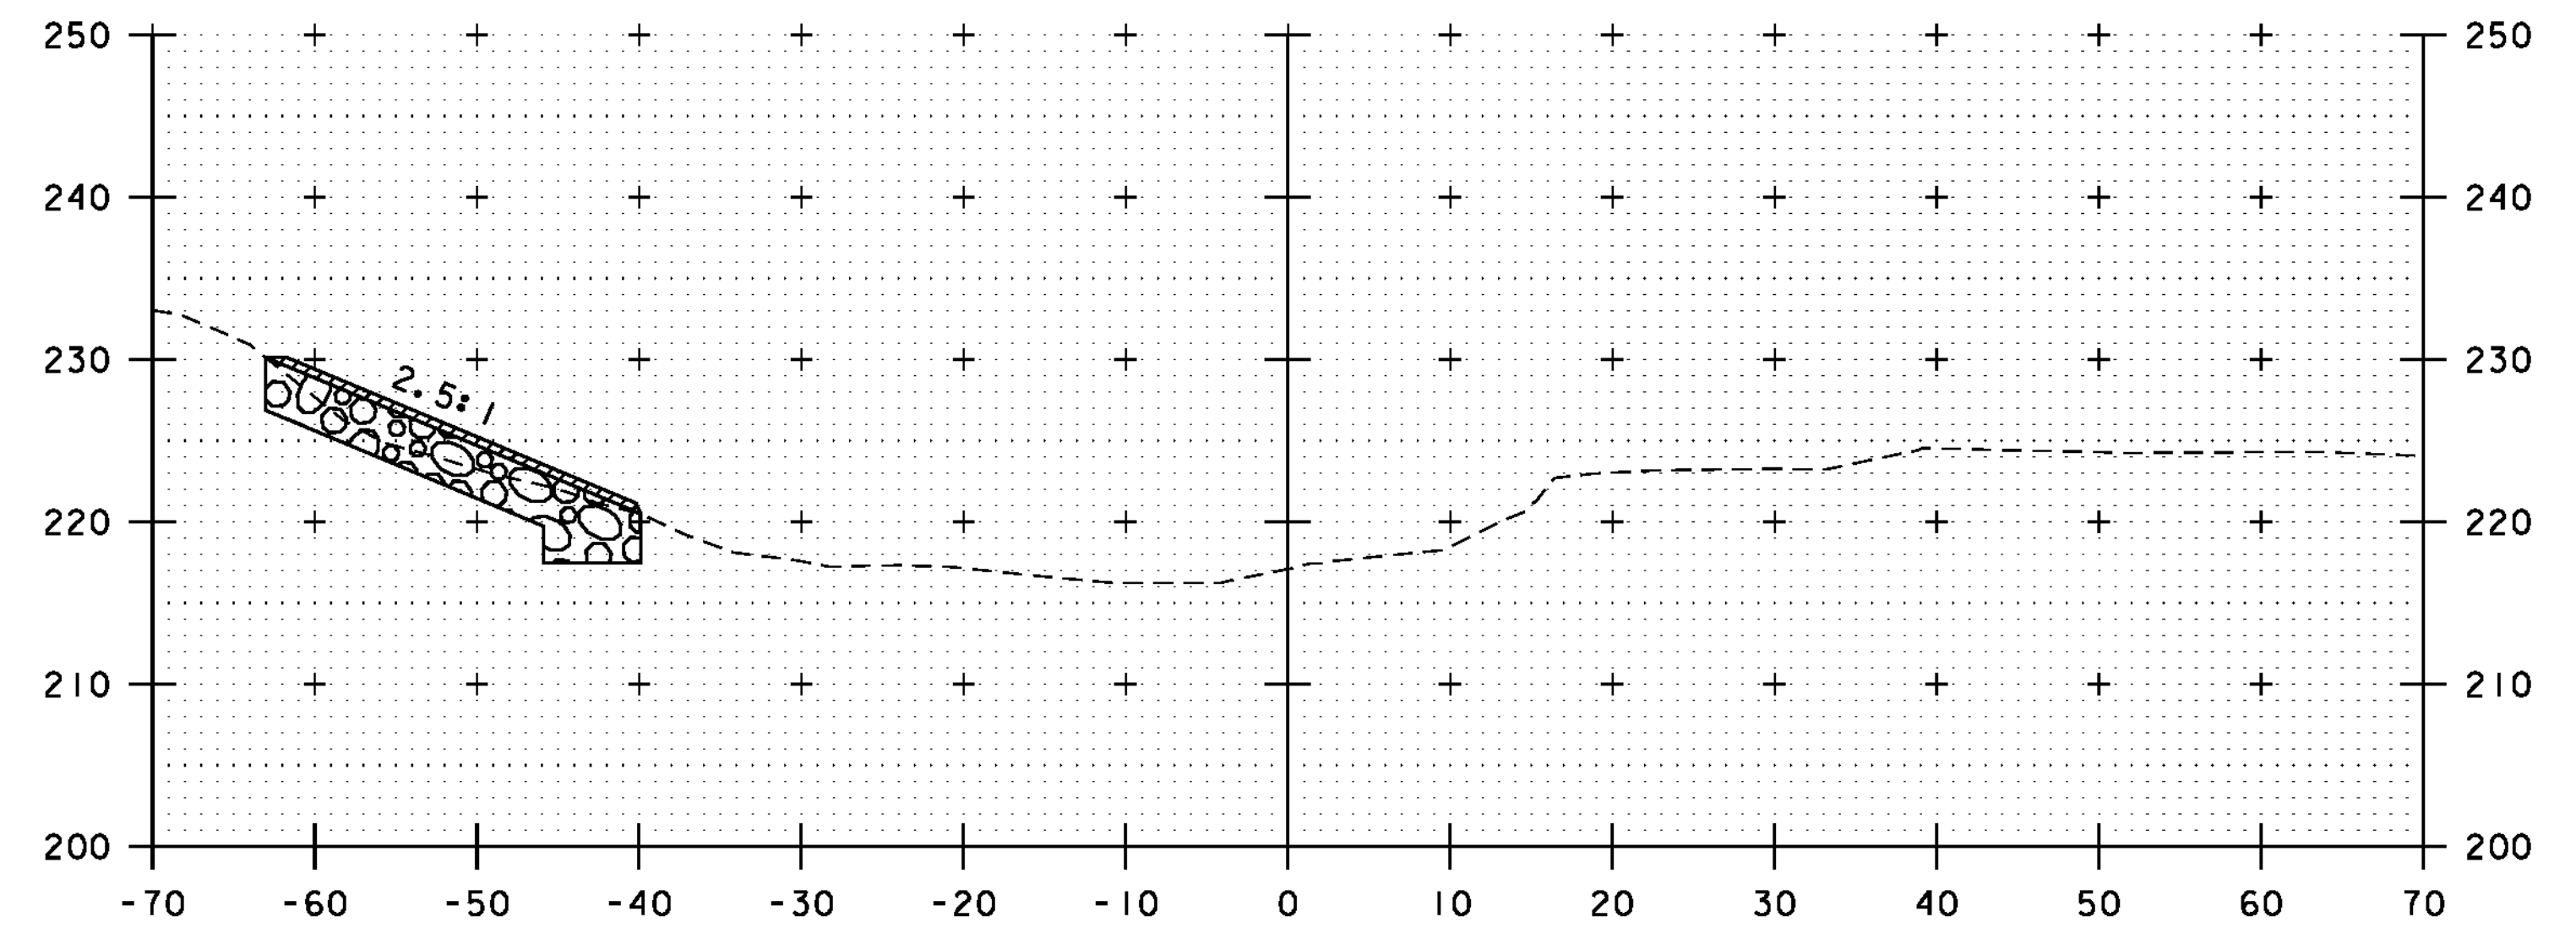

52+00

STA. 51+82.60 LT
 BEGIN STONE FILL, TYPE III
 UNCLASSIFIED CHANNEL EXCAVATION
 GEOTEXTILE UNDER STONE FILL
 GRUBBING MATERIAL

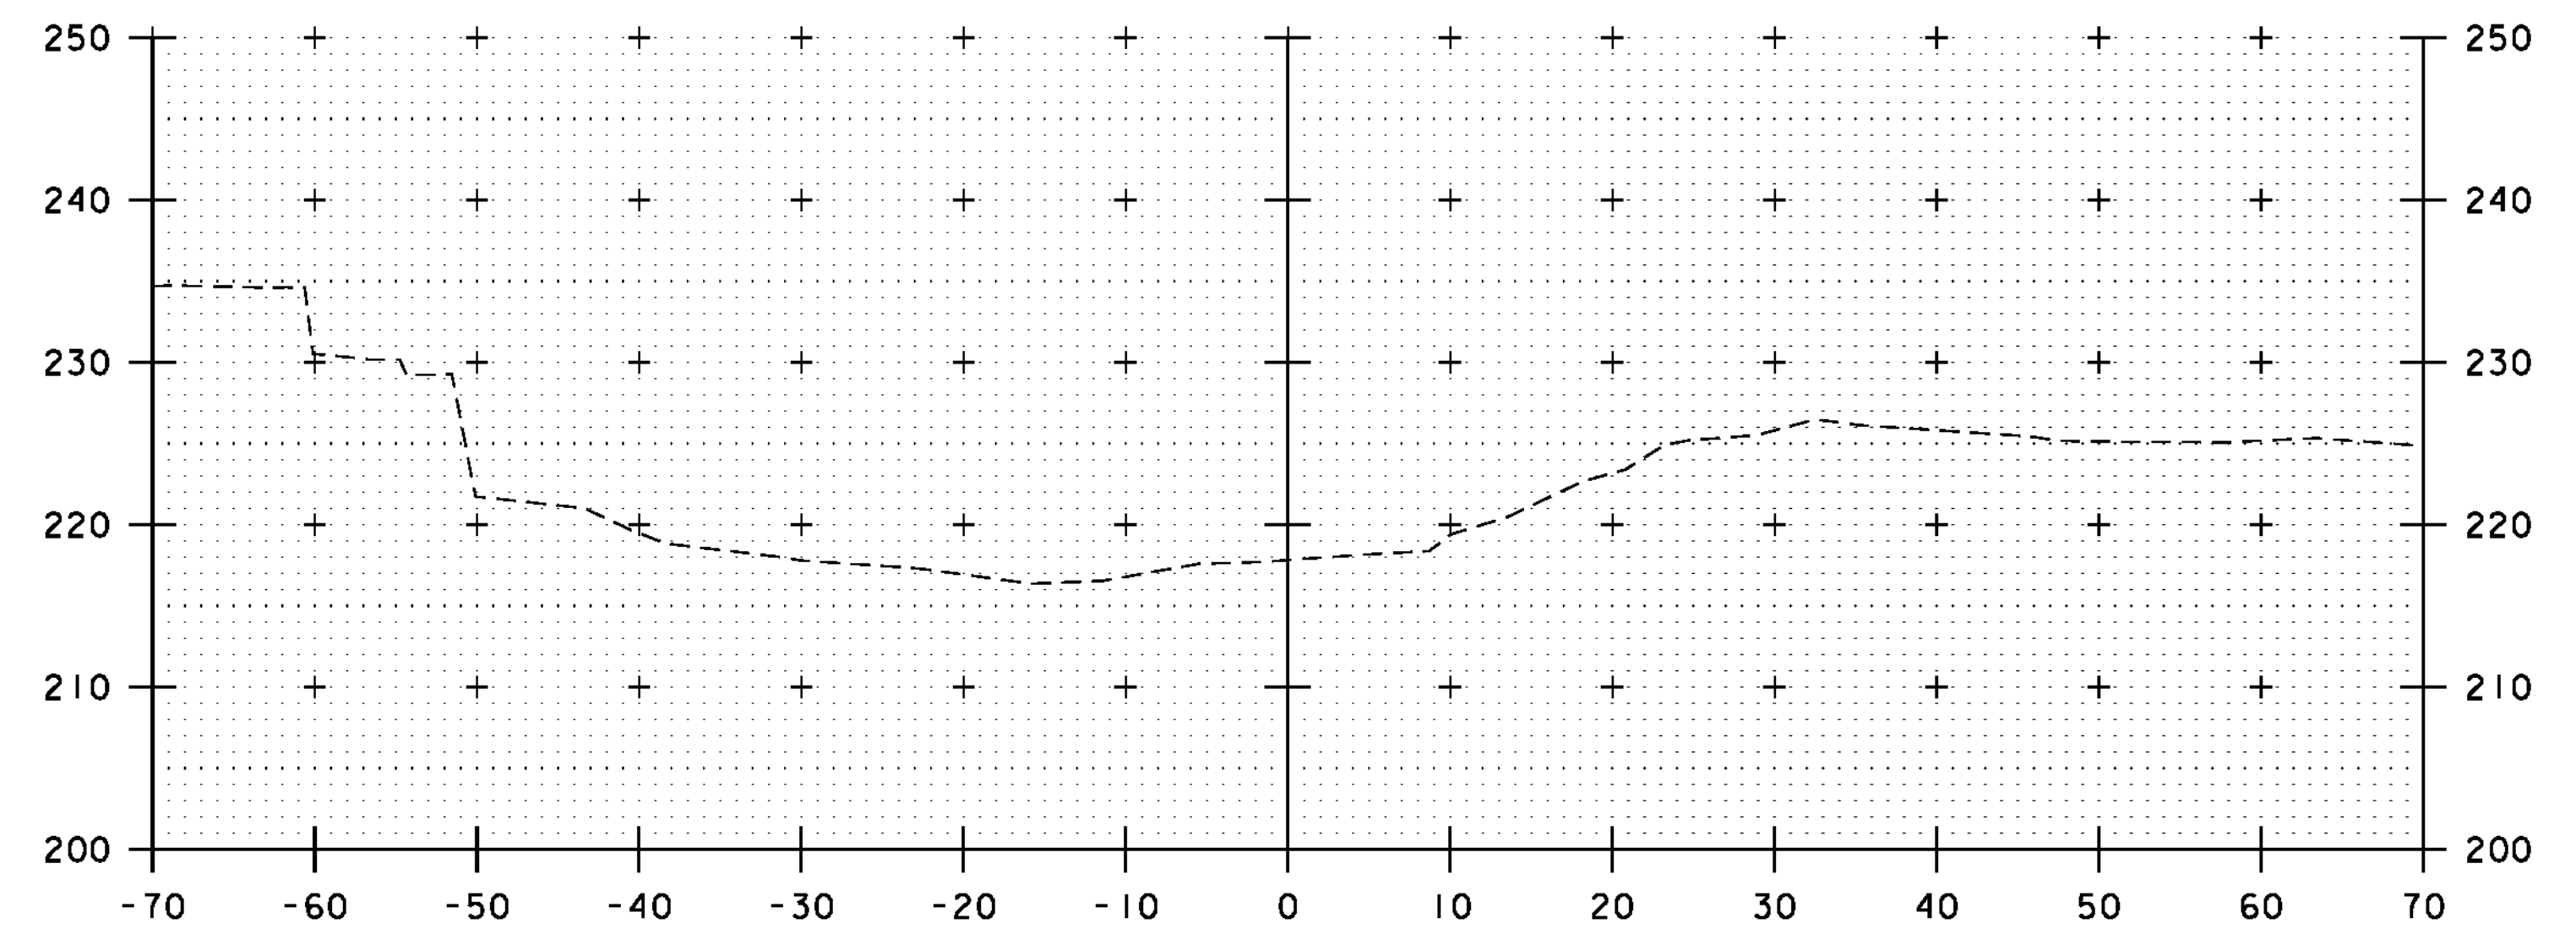

51+75

CHANNEL CROSS SECTIONS
 SCALE 1" = 10'-0"
 STA. 51+25 - STA. 52+00



PROJECT NAME: CHARLOTTE
 PROJECT NUMBER: BHO 1445(24)

FILE NAME: z06j088xs.dgn
 PROJECT LEADER: M.A. COLGAN
 DESIGNED BY: E.A. FIALA
 CHANNEL CROSS SECTIONS (2 OF 3)

PLOT DATE: 10/4/2012
 DRAWN BY: E.A. FIALA
 CHECKED BY: B.O. CRONIN
 SHEET 54 OF 55