


Worrel Covered Bridge  
Fire detection lower span

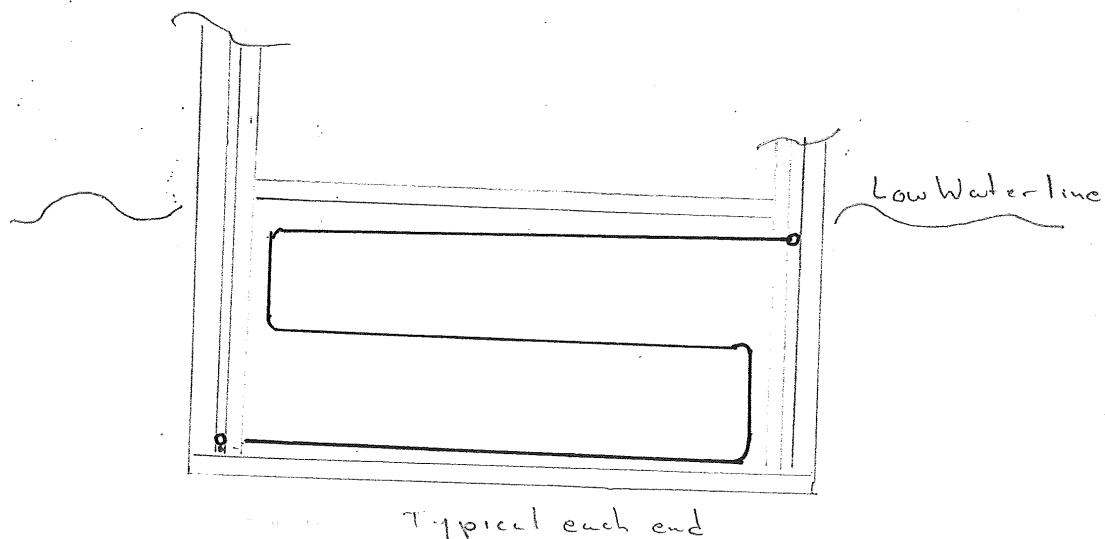

Proposed linear fire protection wire  
location for under side of the Worrel covered bridge

Watts Up Electric  
Ascutney, VT

Worrel Covered Bridge  
Rockingham VT

We are proposing a deviation from contract drawing 3 of 30. Drawing 3 shows 3 horizontal runs of detection wire on the bottom of the deck.

We are proposing a loop of wire at each abutment end extending out to the low water line of the river. There are two primary reasons for the request 1. If the detection loops are installed on the bottom over the river future maintenance will be extremely difficult and expensive. 2. The chance of a fire being started on the underside of the bridge over the water is almost impossible.