



SIDE ELEVATION

SCALE: 1" = 10'-0"

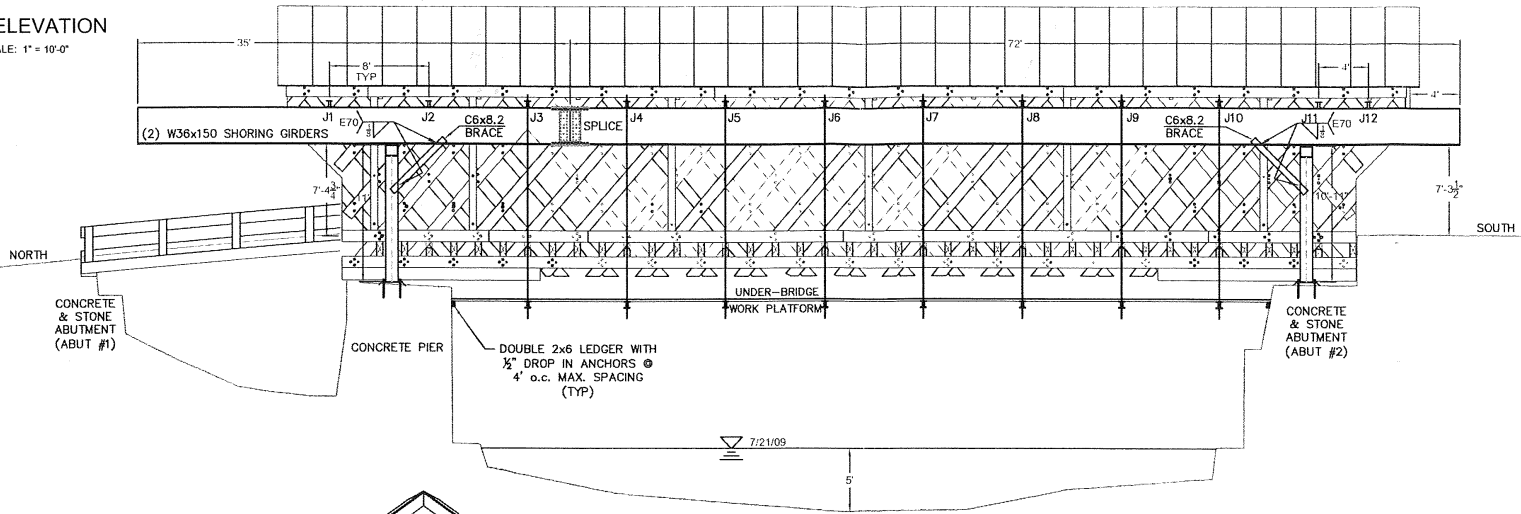

FRONT ELEVATION

SCALE: 1" = 4'-0"

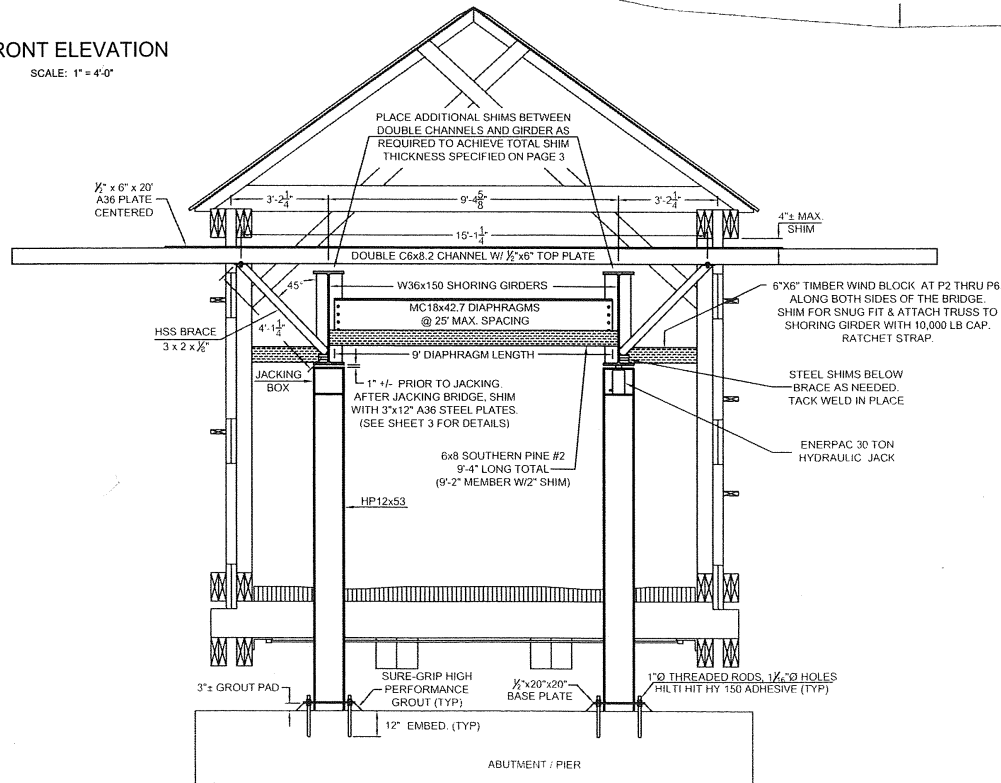

WORRALL COVERED BRIDGE
(BRIDGE #40)
WILLIAMS ROAD
SHORING, STAGING &
REHABILITATION PLAN

SHORING PLAN	
SCALE	AS NOTED
DATE	DECEMBER 1, 2009
JOB NUMBER	BHO 1442 (34)
FILE	BR40.dwg
SHEET	3 OF 9
DRAWING NUMBER	SHORE-1



DRAFTED BY

CHECKED BY

DESIGNED BY