


DeStefano & Chamberlain
Incorporated

Structural and Architectural Engineering

50 Thorpe Street
Fairfield, CT
06824-5725
Tel. 203 254-7131
Fax 203 254-0263
www.dcstructural.com

SEAL

E-02

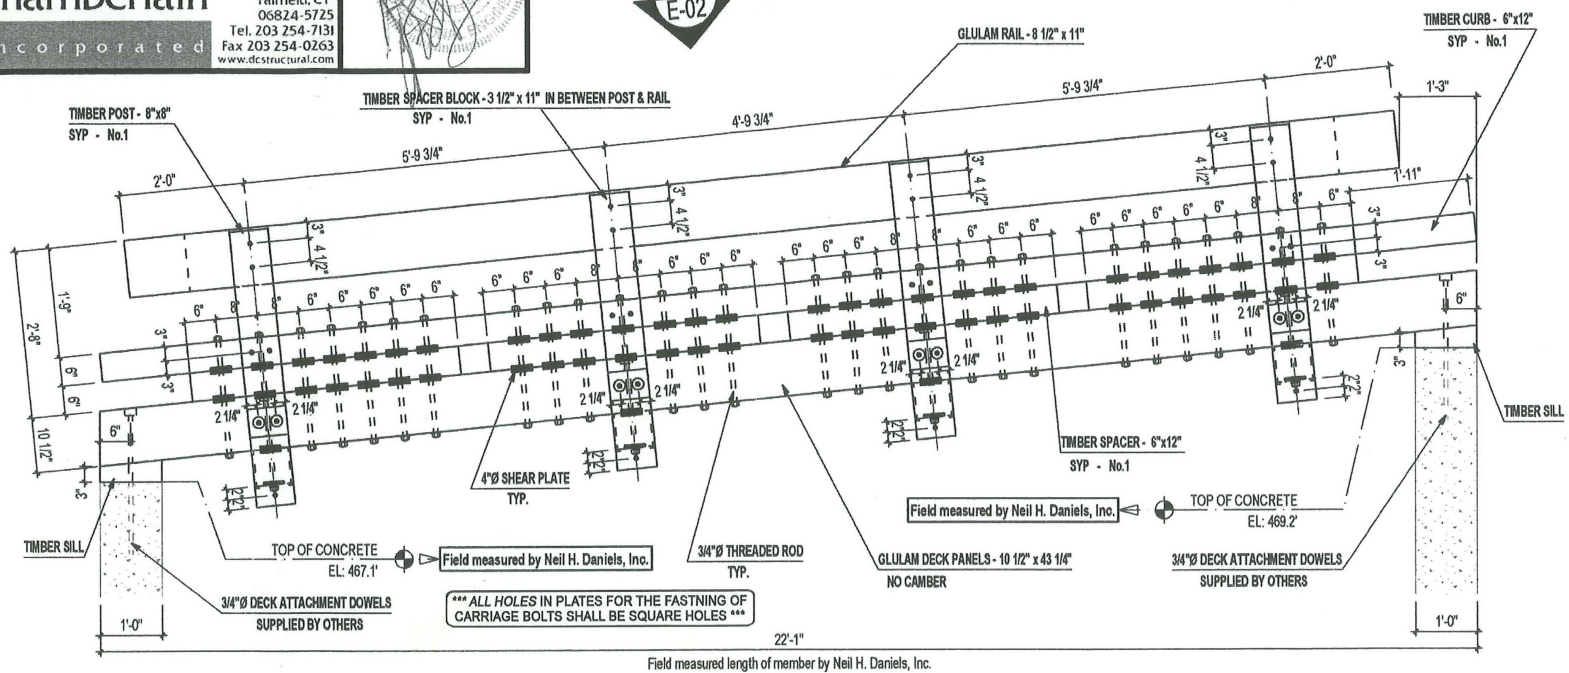

THIS DRAWING MUST BE READ IN CONJUNCTION WITH SK-1 TO SK-3 PREPARED BY JAMES B. DeSTEFANO P.E.

E-01

BRIDGE ELEVATION VIEW		PRINTED: 13.04.2010	Scale: 1:24	FOR RE-APPROVAL - 14/04/2010	START DATE: 14.01.2010	Goodfellow Distribution inc.
Project/Project: Worrall Covered Bridge - Rockingham, VT		FABRICATION		FOR RE-APPROVAL - 19/03/2010	By: J.M.	
No.: 2009-190-U // G-66639		26-04-2010		FOR RE-APPROVAL - 19/02/2010	Checked: R.D.	368, Pepsi Road Manchester, NH, 03109 Tel: 1-800-361-0625 Fax: 1-877-638-8135
Client / Customer: NEIL H. DANIELS, INC.		DATE: REVISION		FOR APPROVAL - 02/02/2010	Welder:	

Rec'd 7/2/10
RDT