


LONG RECESSES / NOTCHES
SHALL BE CUT AT THE JOBSITE BY
Neil H. Daniels, Inc.

Structural and
Architectural
Engineering

**DeStefano &
Chamberlain**
Incorporated

50 Thorpe Street
Fairfield, CT
06824-5725
Tel. 203 254-7131
Fax 203 254-0263
www.dcstructural.com

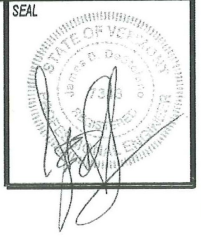

LONG RECESSES / NOTCHES
SHALL BE CUT AT THE JOBSITE BY
Neil H. Daniels, Inc.

THIS DRAWING MUST BE READ IN CONJUNCTION WITH SK-1 TO SK-3 PREPARED BY JAMES B. DeSTEFANO P.E.

E-02

BRIDGE PLAN VIEW		PRINTED: 13.04.2010	Scale: 1:32	FOR RE-APPROVAL - 14/04/2010	START DATE: 14.01.2010	Goodfellow Distribution inc.
Project/Project: Worrall Covered Bridge - Rockingham, VT		FABRICATION	DATE: REVISION	FOR RE-APPROVAL - 19/03/2010	By: J.M.	
No.: 2009-190-U // G-65639		26-04-2010		FOR RE-APPROVAL - 19/02/2010	Check: R.D.	
Client / Customer: NEIL H. DANIELS, INC.				FOR APPROVAL - 02/02/2010	Welder:	

*Rec'd 7/2/10
DJA*