


TREATMENT AFTER FAB. WITH 0.6 TYPE A PENTACHOLROPHENOL

FINISH 4 SIDES

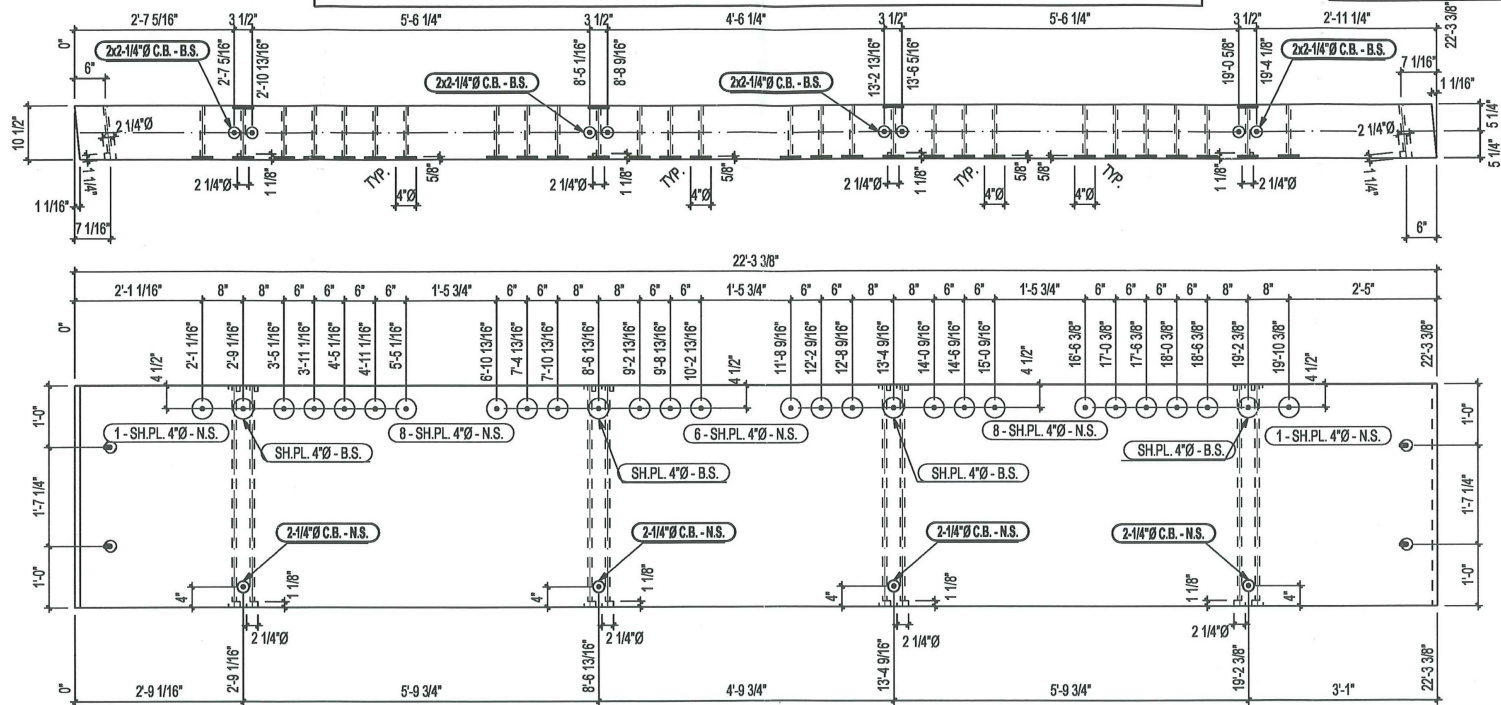

FINISH 4 SIDES

FOR RE-APPROVAL - 14/04/2010

FOR RE-APPROVAL - 19/03/2010

FOR RE-APPROVAL - 19/02/2010

FOR APPROVAL - 02/02/2010

Prod: B3

Deck Panel

PRINTED: 14.08.2010

TROU/HOLE TYP. 21mmØ 13/16"Ø Qté/Qty: 1

Echelle/Scale: 1:24

14.01.2010

Goodfellow Distribution inc.

Project/Project: Worrall Covered Bridge - Rockingham, VT
 No.: 2009-190-U // G-65639
 Client / Customer: NEIL H. DANIELS, INC.

FABRICATION
 26/04/2010

DATE: REVISION

Stress Grade: Comb. 47
 App. Grade: Industrial

X-section: 10 1/2" / 3"-7 1/4"
 Longueur/Length: 22'-3 3/8"
 Materiel/Material: Southern Pine

By: J.M.
 Checked: R.D.
 Visiter:

368, Pepsil Road
 Manchester, NH, 03109
 Tel.: 1-800-361-0625
 Fax: 1-977-638-8135

Handwritten signature and date: Neil 7/2/10