


TREATMENT AFTER FAB. WITH 0.6 TYPE A PENTACHOLROPHENOL

BILLET - NO FABRICATION

NO CAMBER

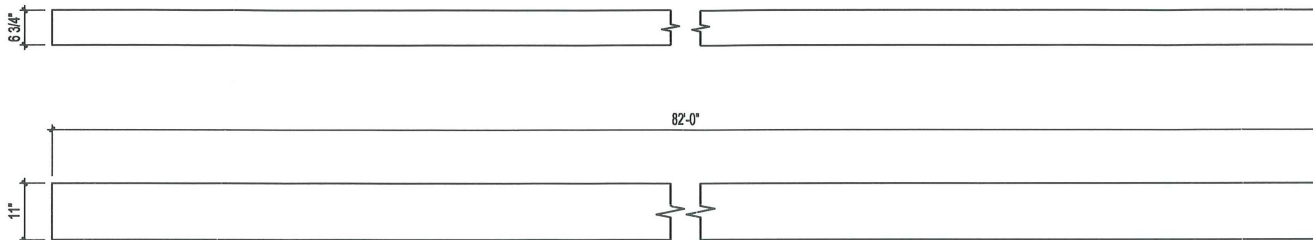

NOTES:

1. Field measured length of member = 82'-0" (by Neil H. Daniels, Inc.)
2. Materials shall be fabricated & treated at Quebec manufacturing facility.
3. Tunnel holes and Tie Rod holes shall be field drilled in members. Field drilled holes shall be treated in accordance with VAOT Specification 726.04.
4. Applicable Material Certifications shall be provided after fabrication.

FOR RE-APPROVAL - 14/04/2010

FOR RE-APPROVAL - 19/03/2010

FOR RE-APPROVAL - 19/02/2010

FOR APPROVAL - 02/02/2010

Prod: B7

PRIMARY LOWER CHORDS		PRINTED: 14.06.2010	Qté/Qty: 4	Echelle/Scale: 1:24	14.01.2010	Goodfellow Distribution inc.
Proj/Project: Worrall Covered Bridge - Rockingham, VT No.: 2009-190-U // G-65639 Client / Customer: NEIL H. DANIELS, INC.	FABRICATION 26-03-2010	DATE: REVISION	Stress Grade: 16F-V2 App. Grade: Industrial	X-section: 6 3/4"x11" Longueur/Length: 82'-0" Materiel/Material: Southern Pine	By: J.M. Checked: R.D. 368, Pepsi Road Manchester, NH, 03109	

*Rec'd 7/2/10
MHA*