

INDEX OF SHEETS

1. TITLE SHEET
2. TYPICAL SECTIONS, NOTES, AND QUANTITIES
3. TIE SHEET
4. PLAN SHEET
5. PROFILE SHEET
6. RESOURCE SHEET
- 7.-11. EROSION PREVENTION & SEDIMENT CONTROL (ESPC) SHEETS
12. TEMPORARY BRIDGE DETAILS SHEET
13. CONSTRUCTION DETAILS SHEET
14. BORING LAYOUT SHEET
- 15.-16. BORING LOG SHEETS
17. TRAFFIC SIGN SUMMARY SHEET
18. SURVEY BASELINE CROSS-SECTIONS

VAOT STANDARD SHEETS

E - 100A	SIDE ROAD CONSTRUCTION APPROACH SIGNS	- 1/02/04
E - 102	CONSTRUCTION SIGN DETAILS	- 6/30/03
E - 102A	CONSTRUCTION SIGN DETAILS	- 5/01/04
E - 107	DELINEATION, BARRICADES AND DETOURS..	- 6/30/03
E - 107A	BREAKAWAY BARRICADE DETAILS	- 8/08/95
E - 121	STANDARD SIGN PLACEMENT-CONVENTIONAL ROAD	- 8/08/95
E - 146	REGULATORY SIGN DETAILS	- 9/20/95
E - 155	WARNING SIGN DETAILS	- 5/01/04
E - 160	FLANGED CHANNEL SIGN POST	- 5/20/99
G - 1	STEEL BEAM GUARDRAIL (50 MPH & OVER)	- 1/03/00
G - 1d	STEEL BEAM GUARDRAIL (40 MPH & LESS)	- 1/03/00

STATE OF VERMONT AGENCY OF TRANSPORTATION



PROPOSED IMPROVEMENT BRIDGE PROJECT


TOWN OF: RANDOLPH
COUNTY OF: ORANGE

ROUTE NO: TH 64, CL 3 BRIDGE NO: 38

PROJECT LOCATION: BEGINNING APPROXIMATELY 0.1 MILE WEST OF THE INTERSECTION OF TH 64 AND VT14 AND CONTINUING 214' EASTERLY ALONG TH 64.

PROJECT DESCRIPTION: REMOVAL OF A COVERED BRIDGE SUPERSTRUCTURE AND CONSTRUCTION OF A TEMPORARY BRIDGE AND APPROACHES

LENGTH OF STRUCTURE: 83.0 FEET
LENGTH OF PROJECT: 214 FEET

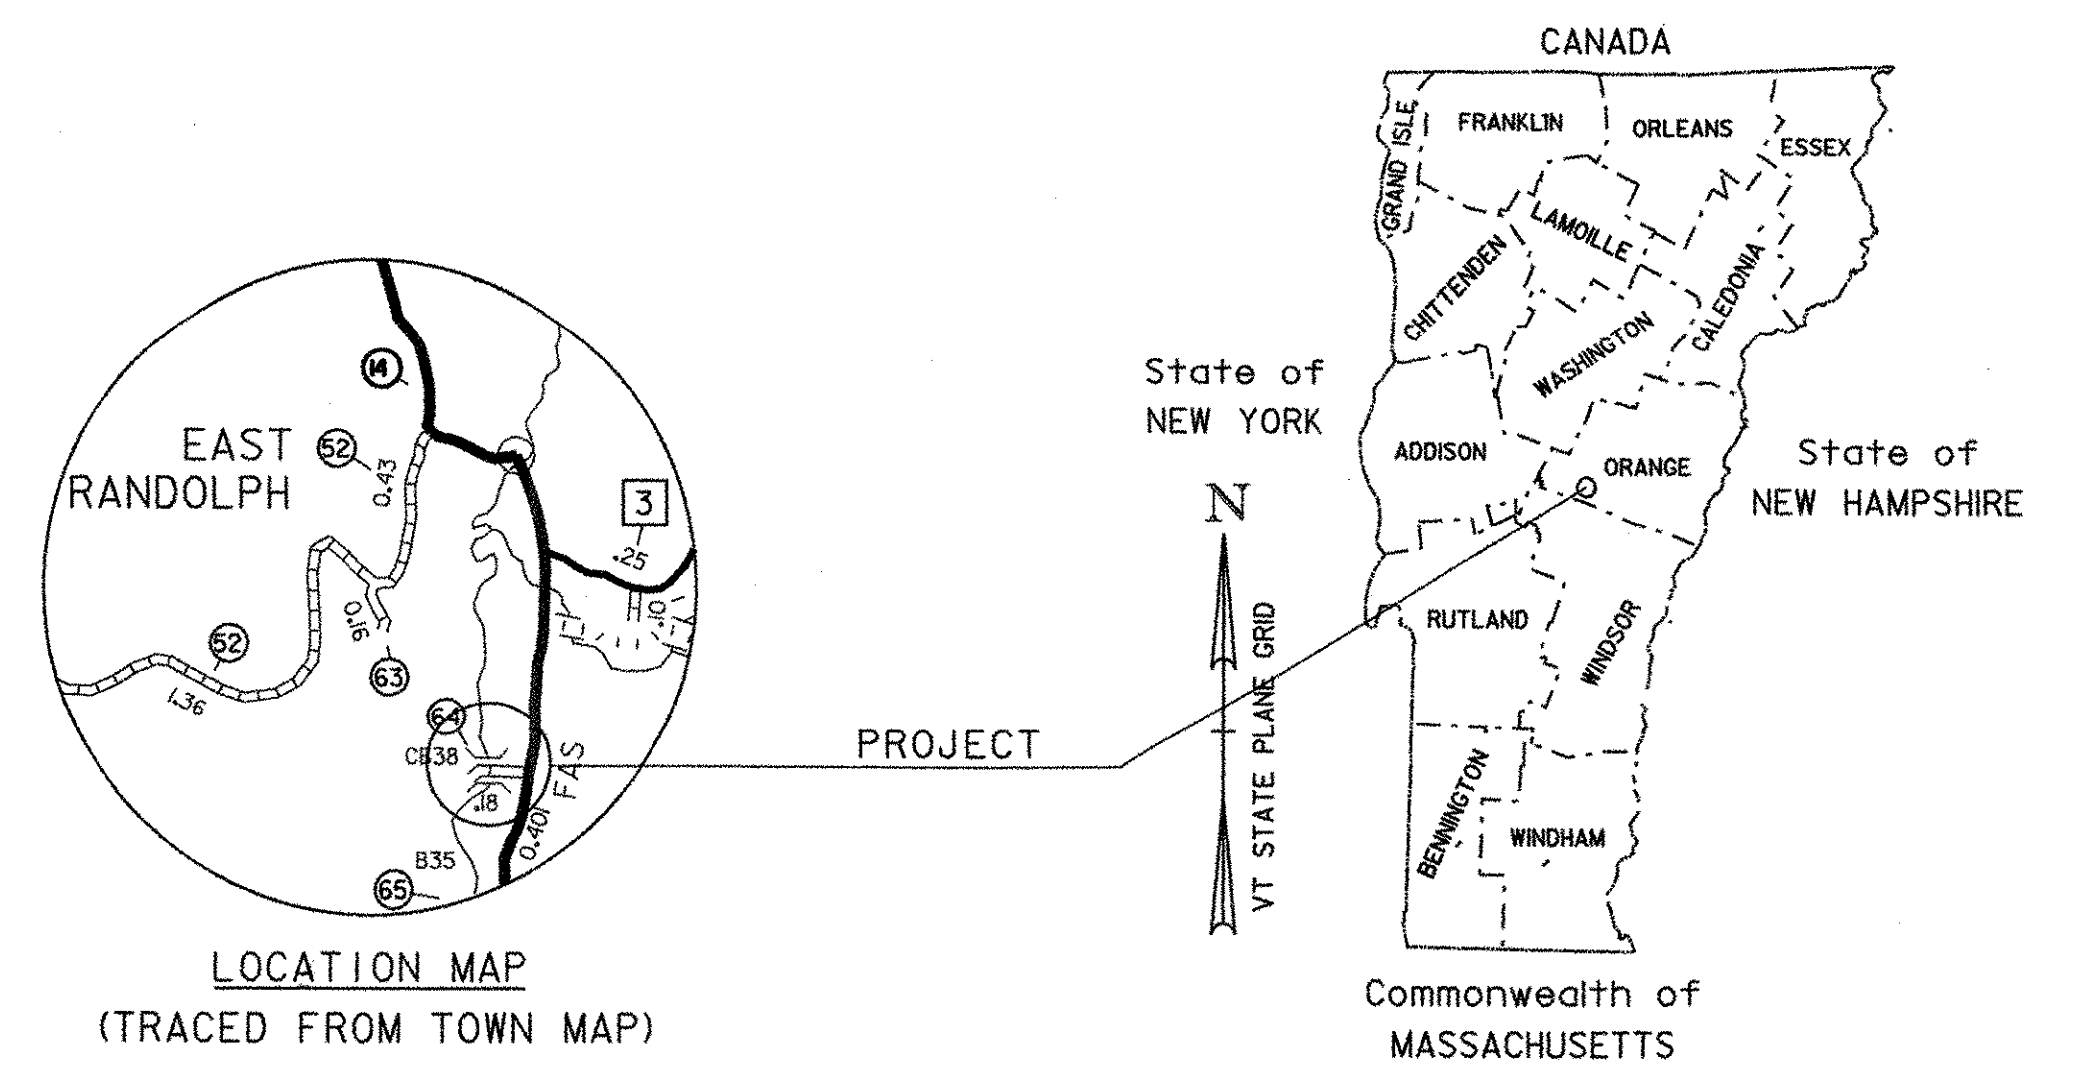


RECORD PLANS	
CONTRACTOR:	MILLER CONSTRUCTION INC. - WINDSOR, VT
RESIDENT ENGINEER:	TOM CHASE
CONSTRUCTION BEGAN:	APRIL 18, 2007
CONSTRUCTION COMPLETE:	JUNE 14, 2007
RECORD PLANS BY:	TOM CHASE
I HEREBY CERTIFY THAT ALL THE CONSTRUCTION REQUIRED BY THIS SET OF DRAWINGS HAS BEEN ACCOMPLISHED AS INDICATED HEREIN.	
BY <u>Thomas A. Chase</u>	RESIDENT ENGINEER
DATE <u>10/01/08</u>	
NOTE: Any further information concerning final quantities, amounts or other details relative to this project may be found at Central Files in the electronic archives.	

CONVENTIONAL SYMBOLS	
COUNTY LINE	
TOWN LINE	
LIMITS OF ACCESS	
POINT OF ACCESS	
FENCE LINE	
STONE WALL	
TRAVELED WAY	
GUARD RAIL	
RAILROAD	
SURVEY LINE	
CULVERT	
POWER POLE	
TELEPHONE POLE	
TREES	
CONTROL OF ACCESS	
PROPERTY LINE	
R.O.W. TAKING LINE	
SLOPE RIGHTS	
TOP OF CUT	
TOE OF SLOPE	

SURVEYED BY : R. Gilman
SURVEYED DATE : 12/19/2005

DATUM
VERTICAL: NAVD88
HORIZONTAL: NAD 83(96)

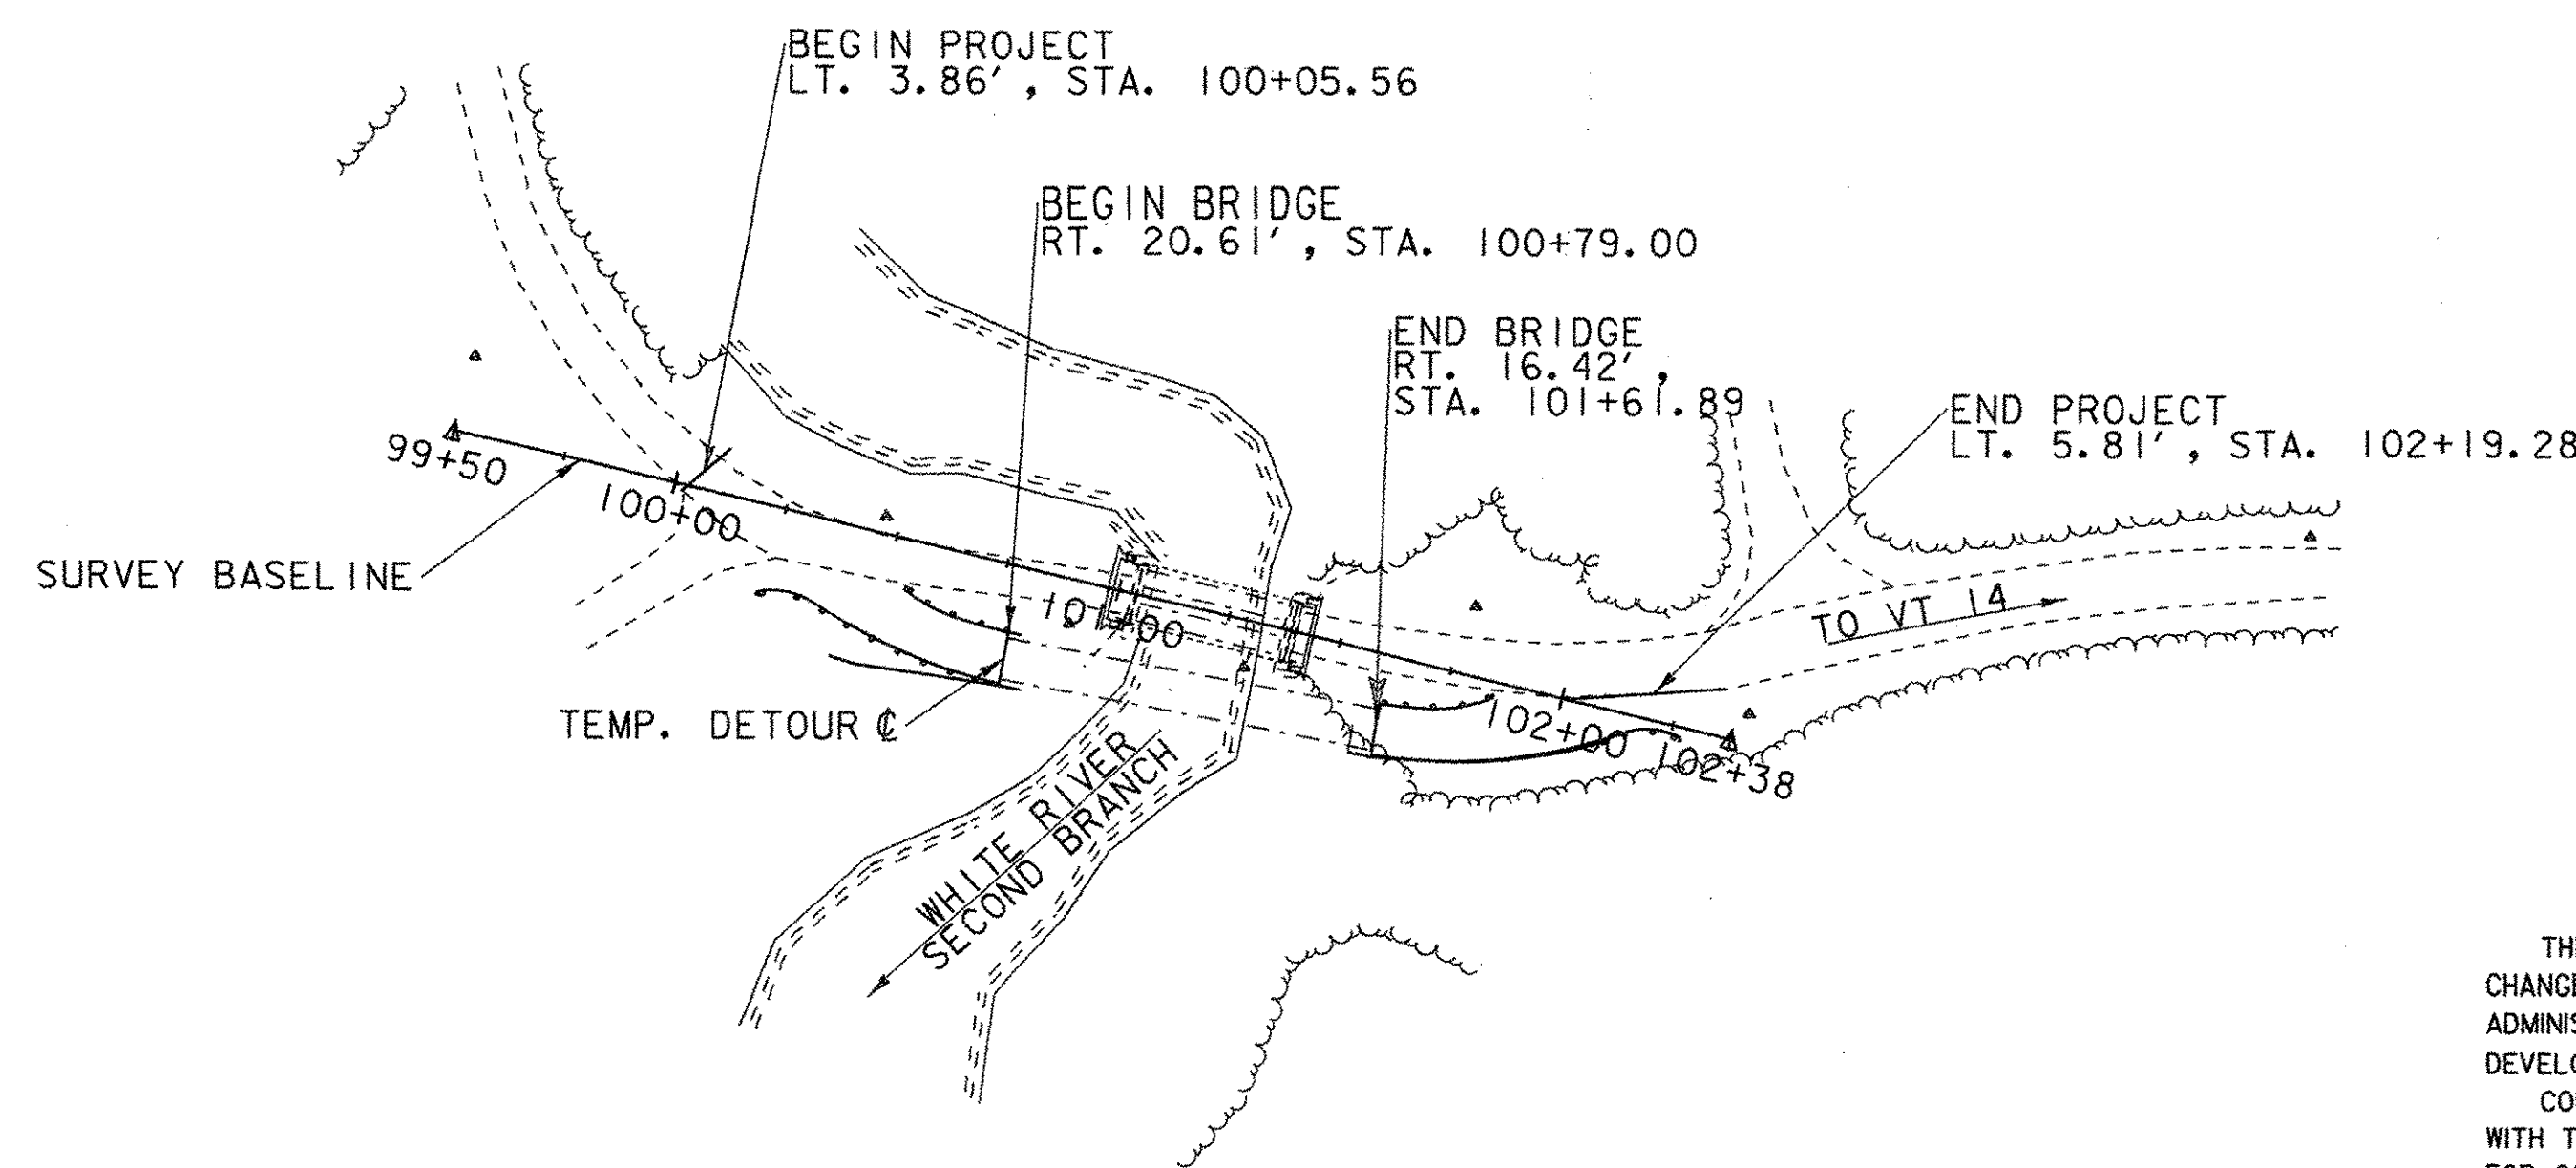

PLAN
SCALE: 1" = 40'

THESE PLANS ARE SUBJECT TO SUCH ENGINEERING CHANGES AS MAY BE REQUIRED BY THE FEDERAL HIGHWAY ADMINISTRATION OR THE DIRECTOR OF PROGRAM DEVELOPMENT.

CONSTRUCTION IS TO BE CARRIED ON IN ACCORDANCE WITH THESE PLANS AND THE STANDARD SPECIFICATIONS FOR CONSTRUCTION DATED 2001, AS APPROVED BY THE FEDERAL HIGHWAY ADMINISTRATION ON JANUARY 4, 2001 FOR USE ON THIS PROJECT, INCLUDING ALL SUBSEQUENT REVISIONS AND SUCH REVISED SPECIFICATIONS AND SPECIAL PROVISIONS AS ARE INCORPORATED IN THESE PLANS.

BUILT AS DESIGNED

DEPARTMENT OF TRANSPORTATION FEDERAL HIGHWAY ADMINISTRATOR
APPROVED <u>Paul Kendall</u> DATE <u>1-18-07</u>
DIRECTOR OF PROGRAM DEVELOPMENT
APPROVED <u>Rudolf Johnson</u> DATE <u>12-20-06</u>
PROJECT MANAGER : J. WEAVER
PROJECT NAME : RANDOLPH BHO 1444 (50)
SHEET 1 OF 18 SHEETS