


\* BOTTOM OF SHEETS ELEV. VARIES,  
SHALL BE 9'-6" BELOW EXIST. GROUND LINE.

**PROFILE @ FACE OF STEEL SHEETING  
(PERMANENT STEEL SHEET PILING)**

HORIZ. SCALE: 20' = 1"  
VERT. SCALE: 10' = 1"

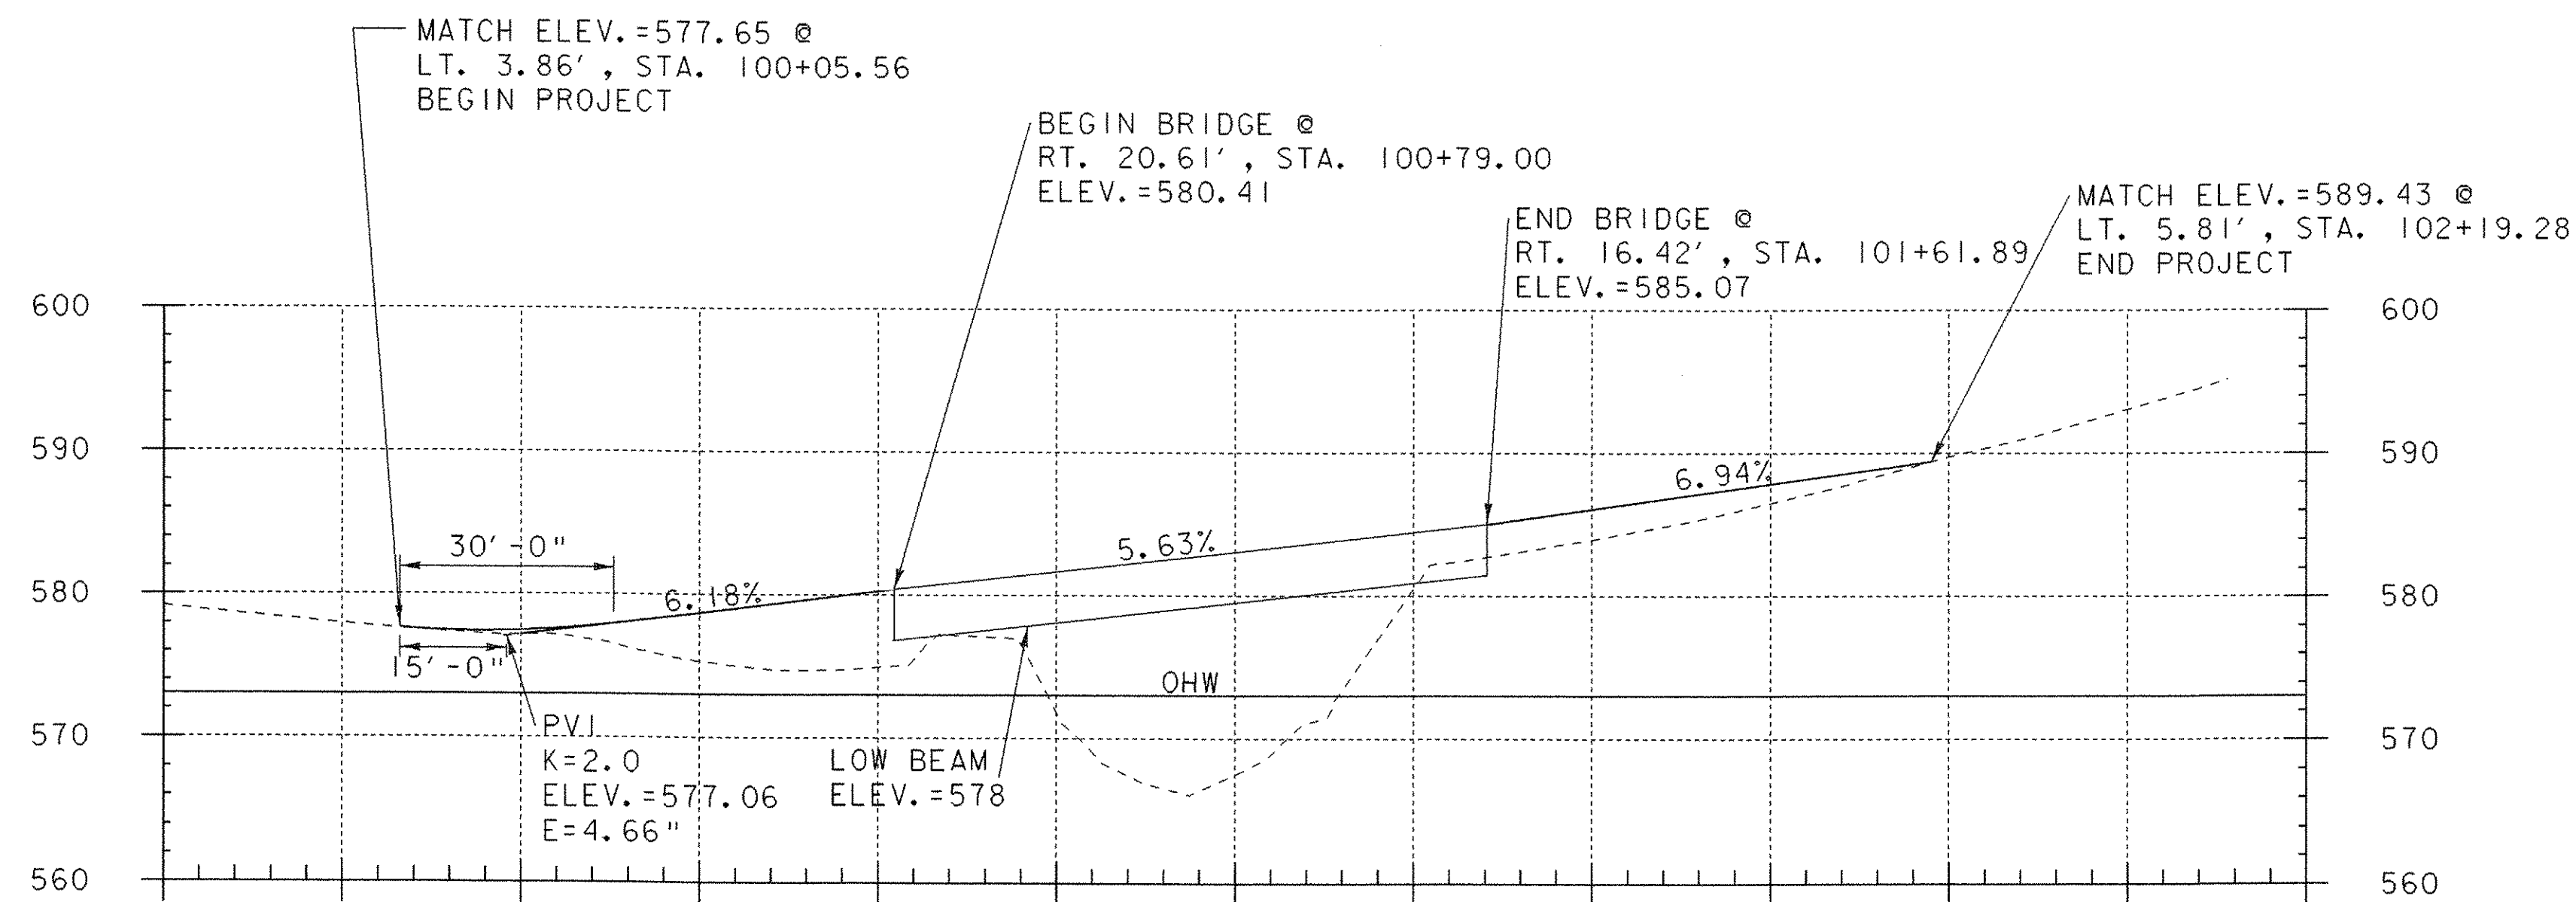

**PROFILE @ TEMP. DETOUR CL**

HORIZ. SCALE: 20' = 1"  
VERT. SCALE: 10' = 1"

PROJECT NAME:	RANDOLPH
PROJECT NUMBER:	BHO_1444(50)
FILE NAME: s061094xs	PLOT DATE: 17-JAN-2007
PROJECT LEADER: J. WEAVER	DRAWN BY: J. IBEI
DESIGNED BY: J. IBEI	CHECKED BY: J. WEAVER
PROFILE SHEET	SHEET 5 OF 18