







PROPERTY LINES ARE UNAVAILABLE

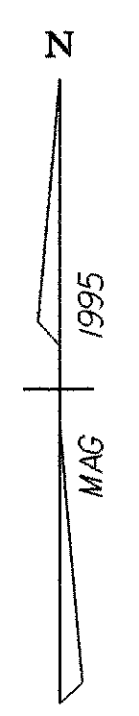

**LEGEND**

-  WETLAND
-  ORDINARY HIGH WATER
-  50' RIPARIAN BUFFER
-  RIGHT OF WAY

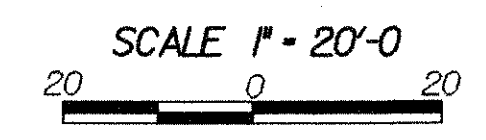

PROJECT NAME: RANDOLPH	PLOT DATE: 3/29/06
PROJECT NUMBER: BHO 1444 (50)	DRAWN BY: J. TREI
FILE NAME: s061094e.dgn	CHECKED BY: J. WEAVER
PROJECT LEADER: J. WEAVER	SHEET 8 OF 18
DESIGNED BY: J. TREI	
EPSC SHEET 2 - EXISTING CONDITIONS	