



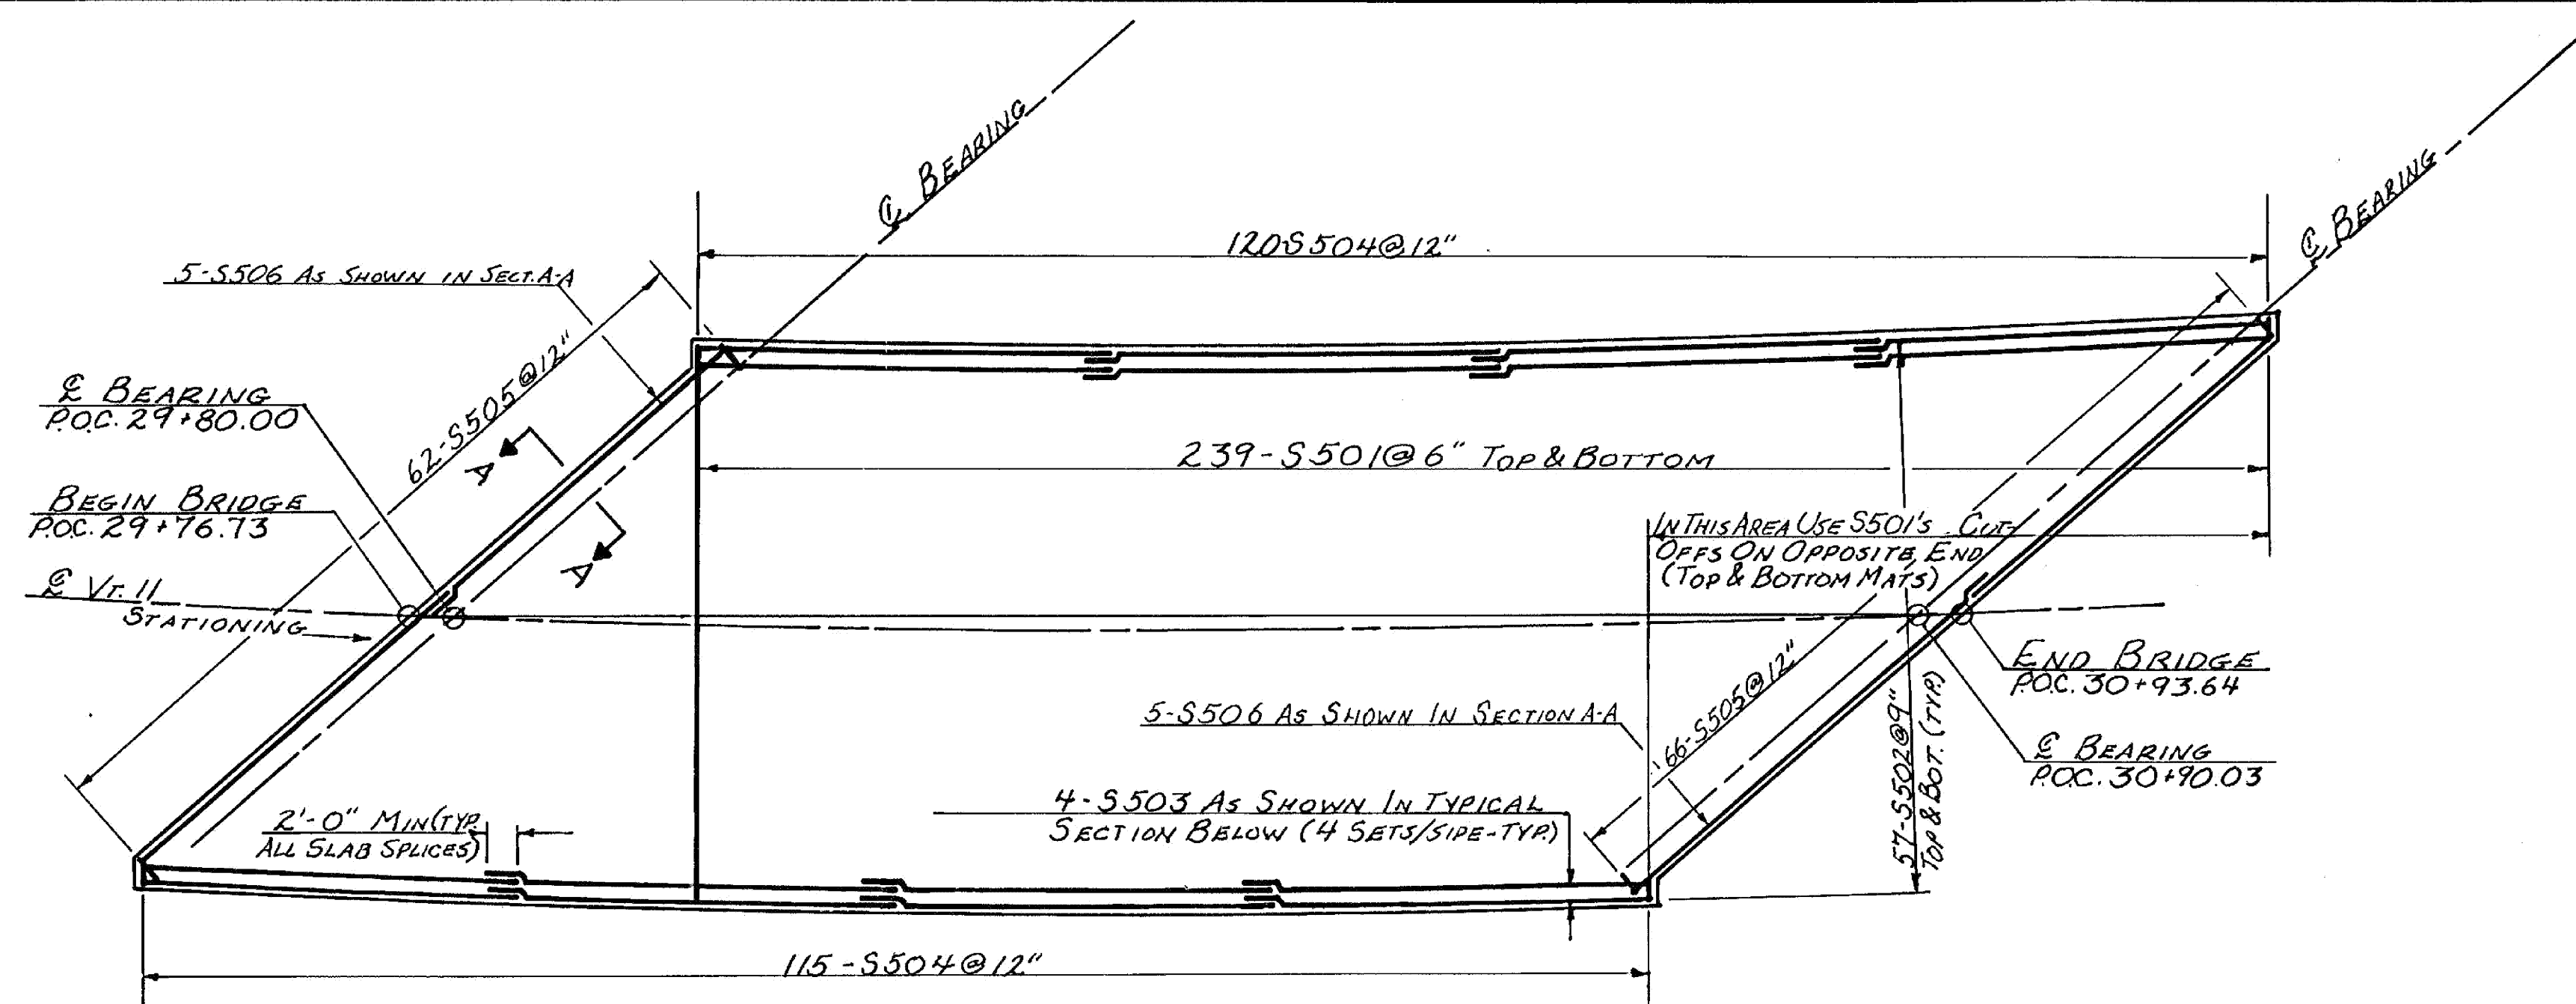


SLAB REINFORCING STEEL PLAN
SCALE: 1" = 10'-0"

NOTE: SEE STANDARD SCB-D4-76 FOR CURB DETAILS

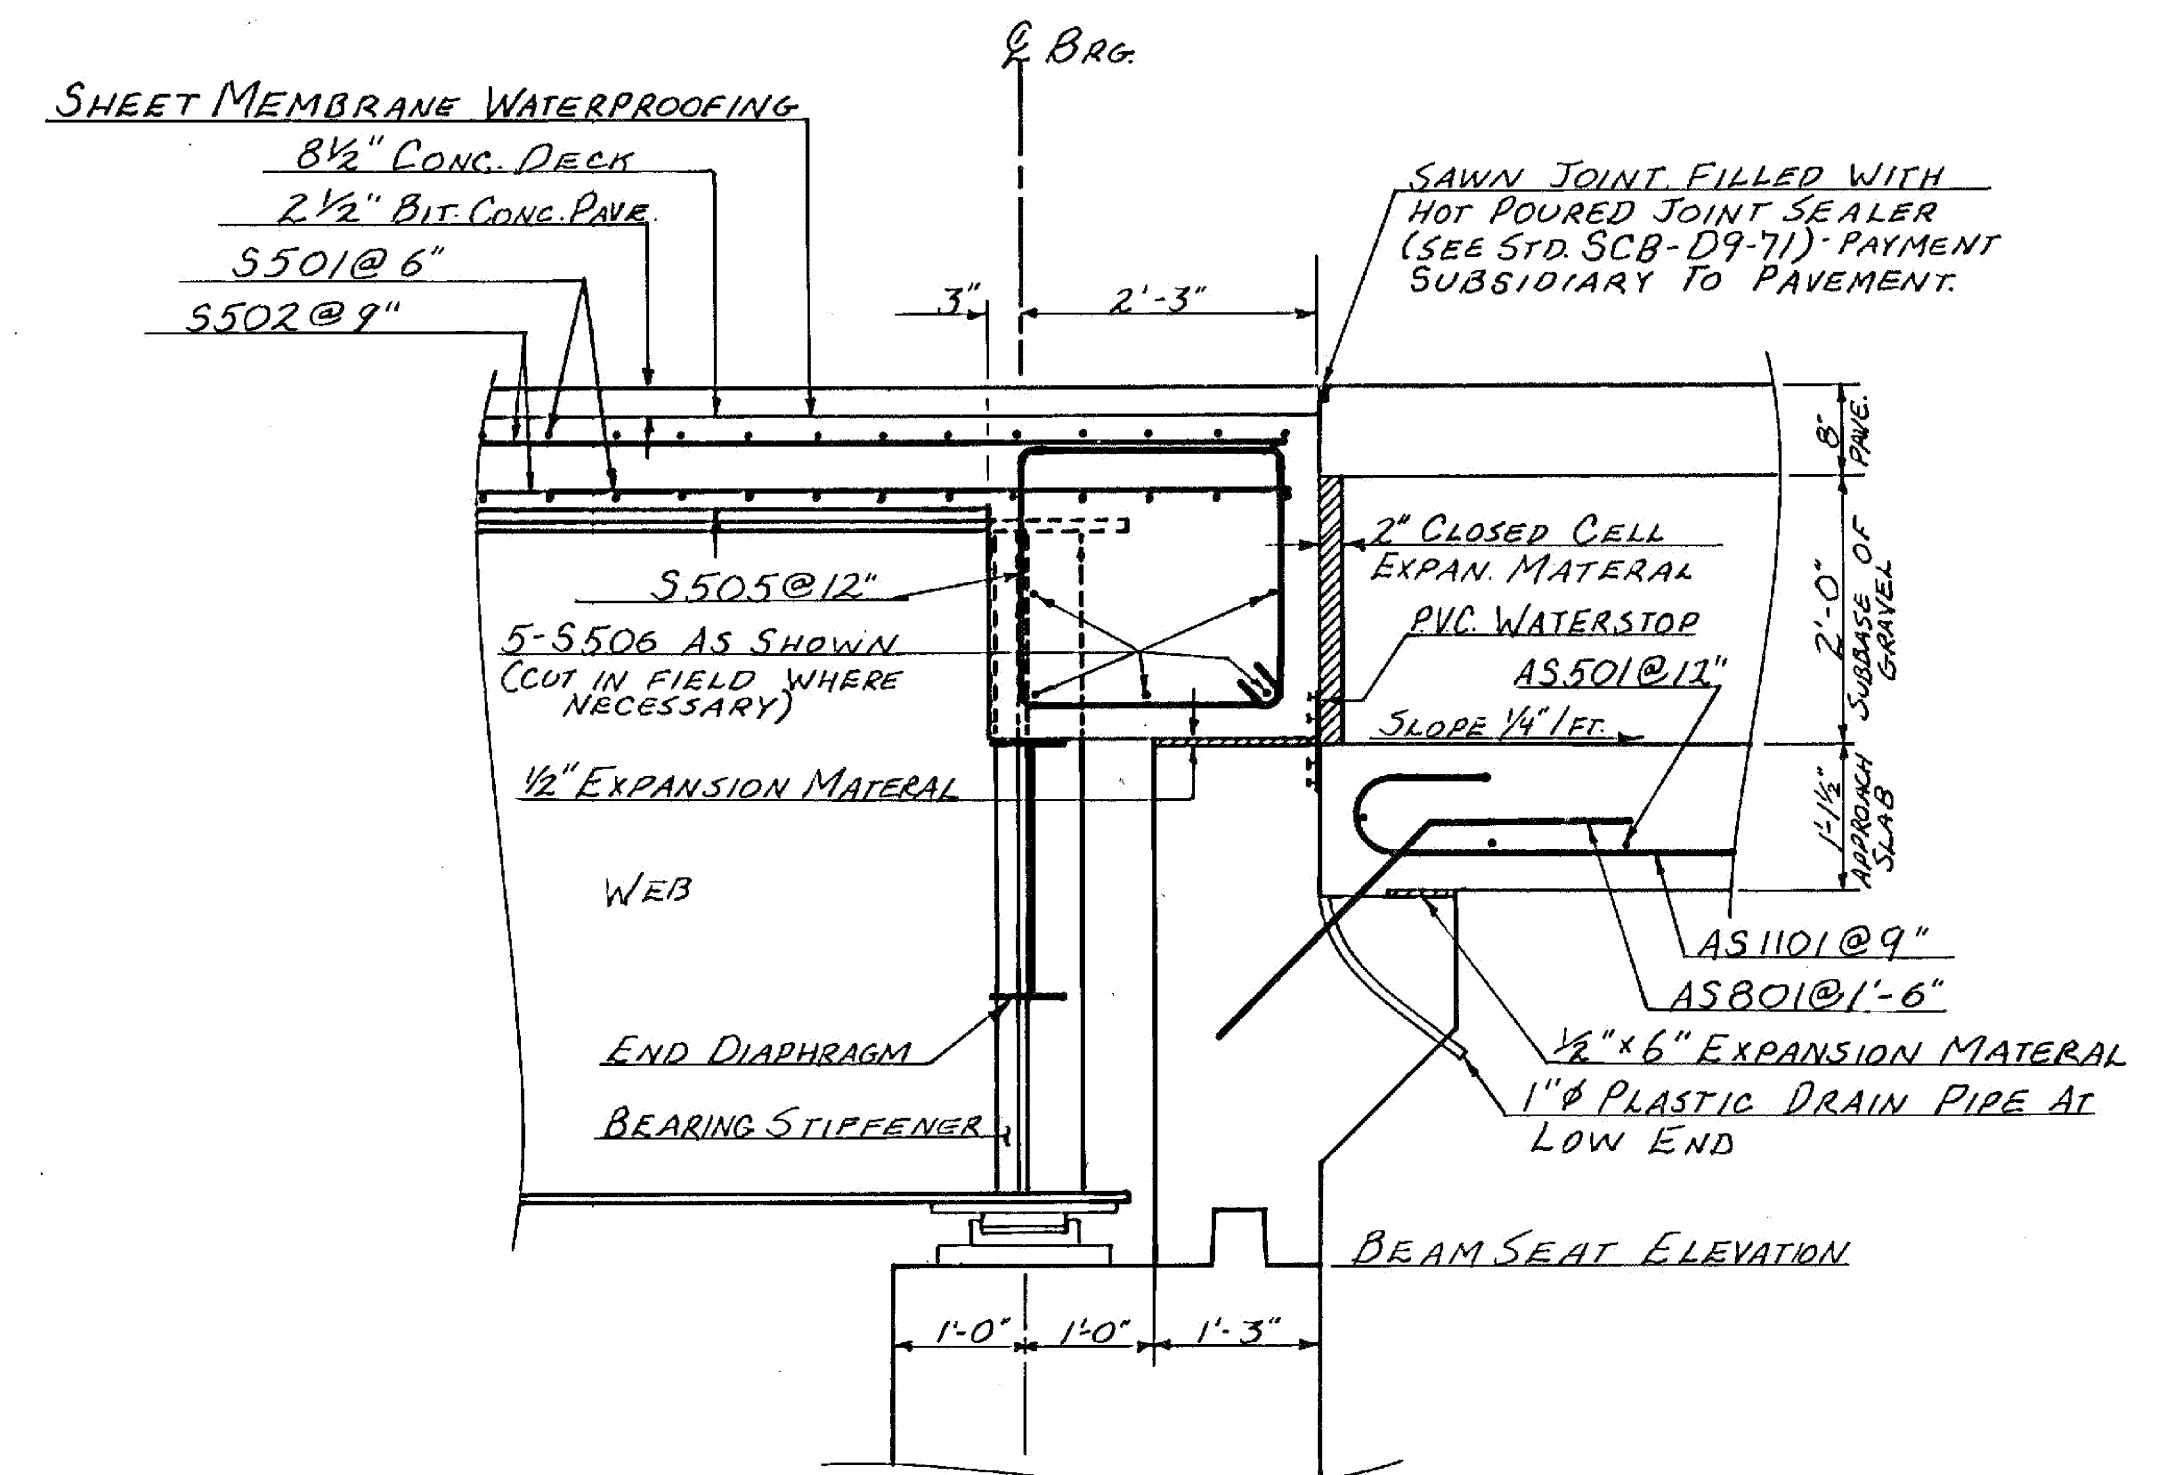

SECTION A-A*
SCALE: 3/4" = 1'-0"

* = TYPICAL EACH END.

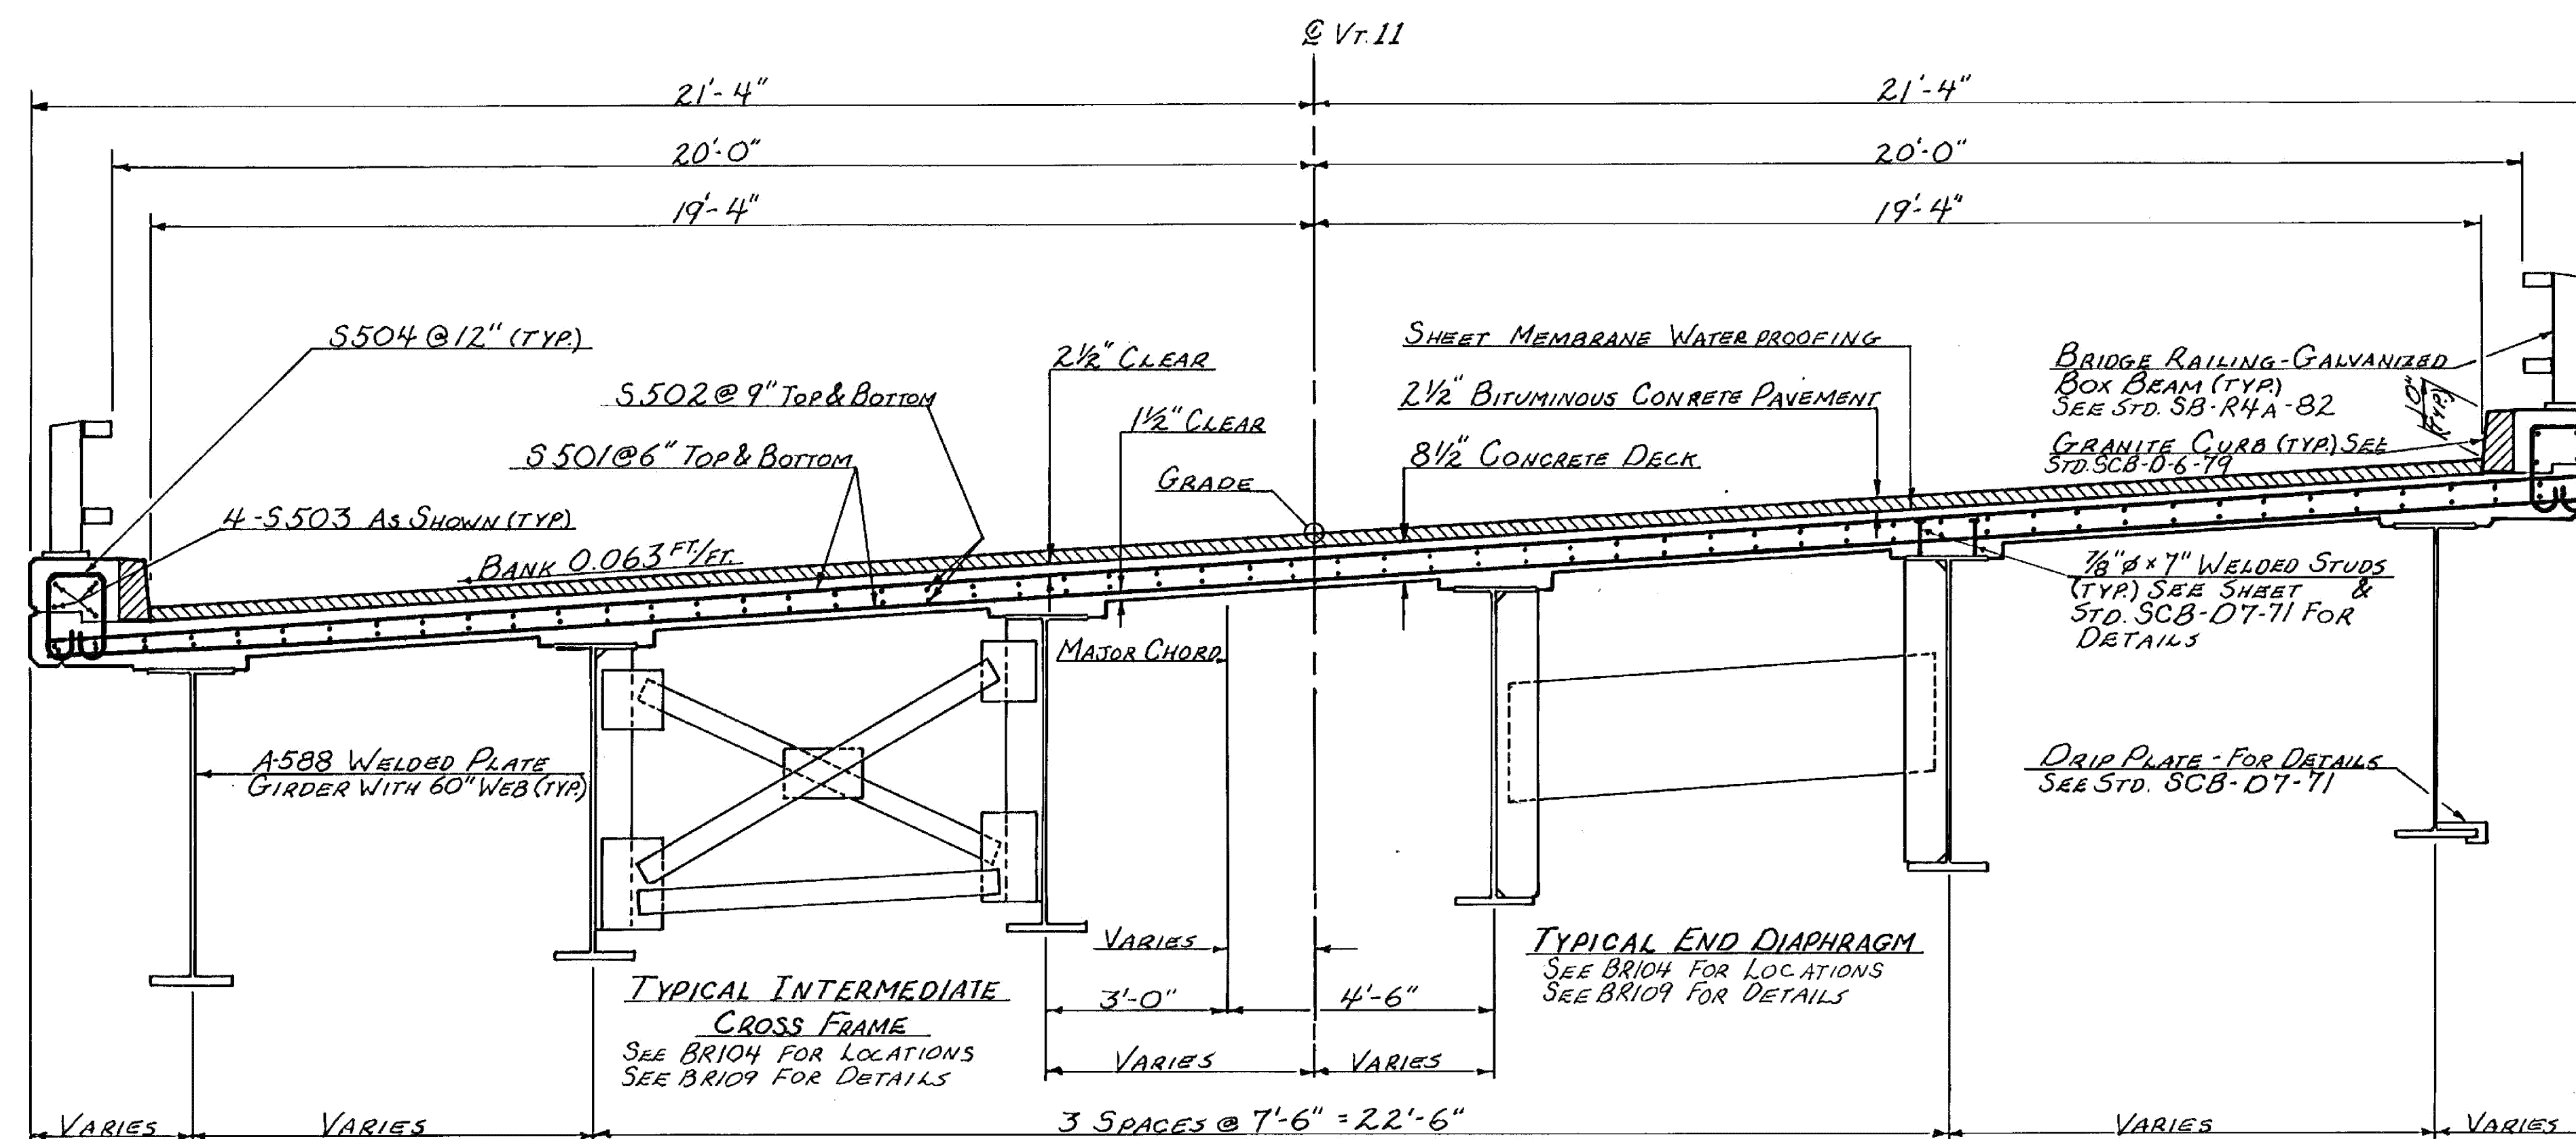

TYPICAL BRIDGE SECTION
SCALE: 1/2" = 1'-0"
BUILT AS DESIGNED

STATEWIDE - SOUTHEAST
REGION
BHF MEMB(21)

SHEET 14 OF 34
BRIDGE 45
FOR REFERENCE ONLY

STATE OF VERMONT AGENCY OF TRANSPORTATION			
TOWN OF	CHESTER	Bridge No.	45
HIGHWAY NO.	Vt. 11	Log Sta.	94+92
		Surv. Sta.	30+00
TYPICAL BRIDGE SECT. & SLAB REINF.			
VT. 11 OVER MIDDLE BRANCH WILLIAMS R.			
Designed by	A. ELWOOD	Drawn by	S. BASCOM
Checked by	D. BURLEY date 6-82	Bridge Design Supervisor	R. S. HAUPT date 6-82
PROJECT	CHESTER	PROJECT NO.	BRF-016-1(6)
Bridge Sheet No. BR103 Sheet 16 of 75			