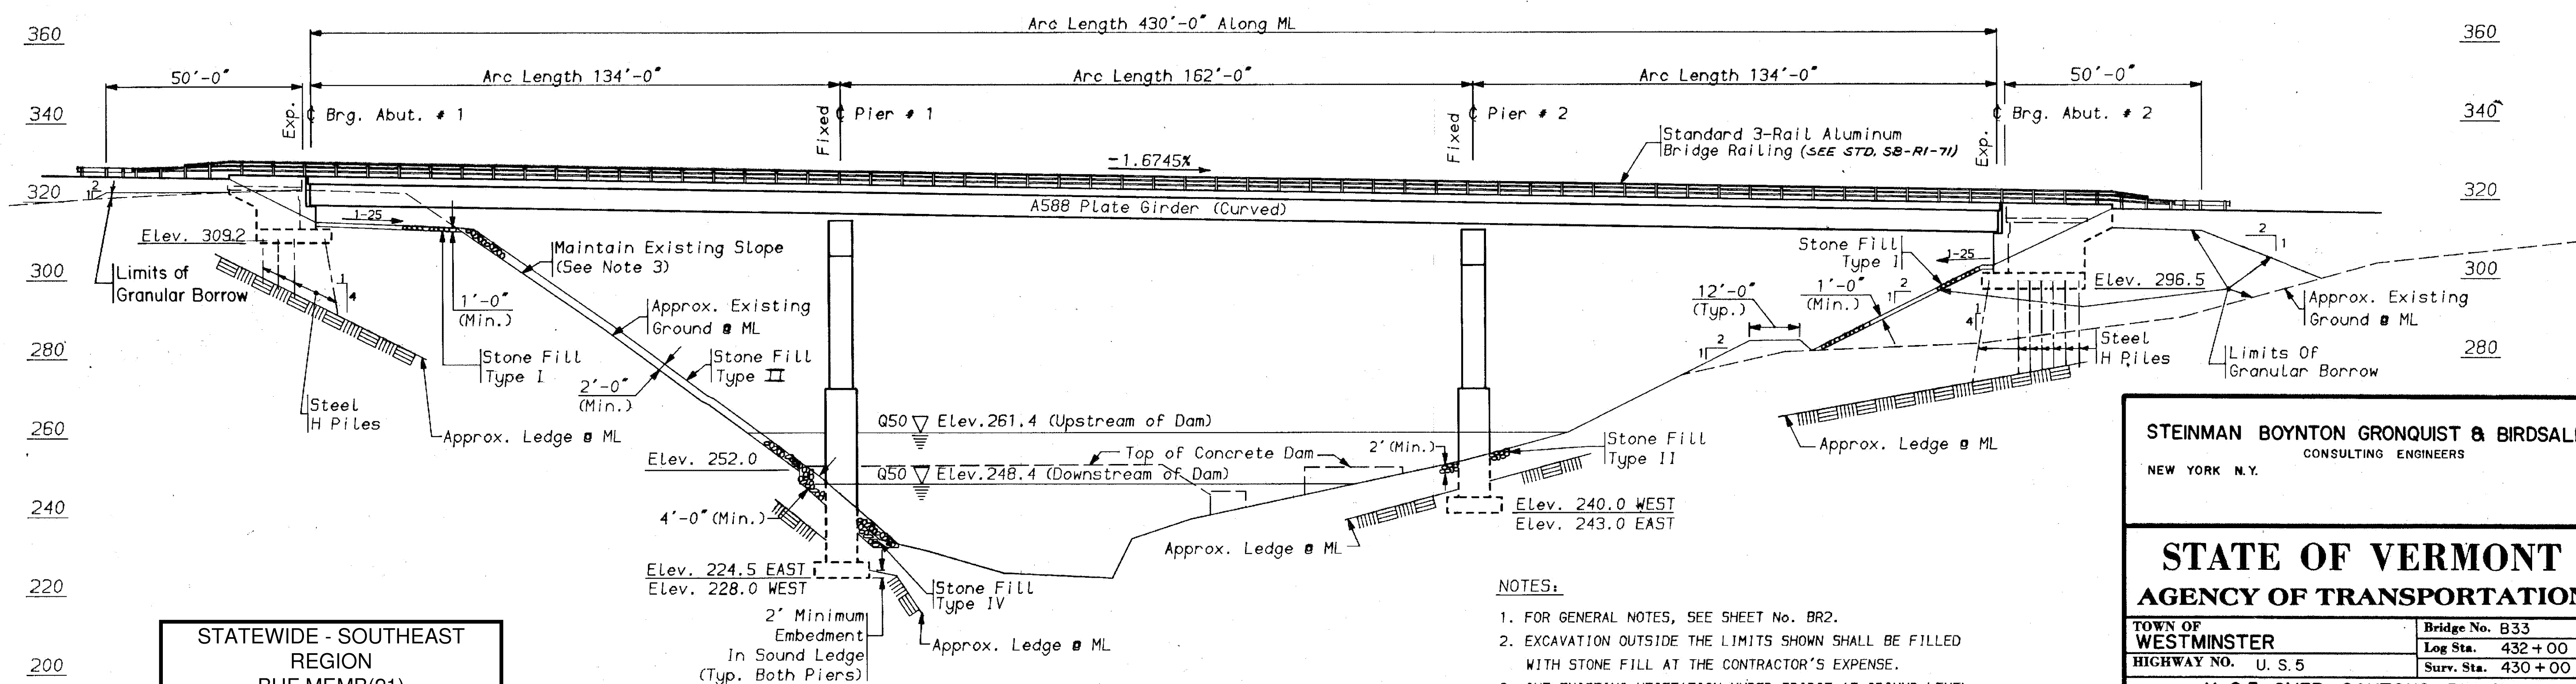
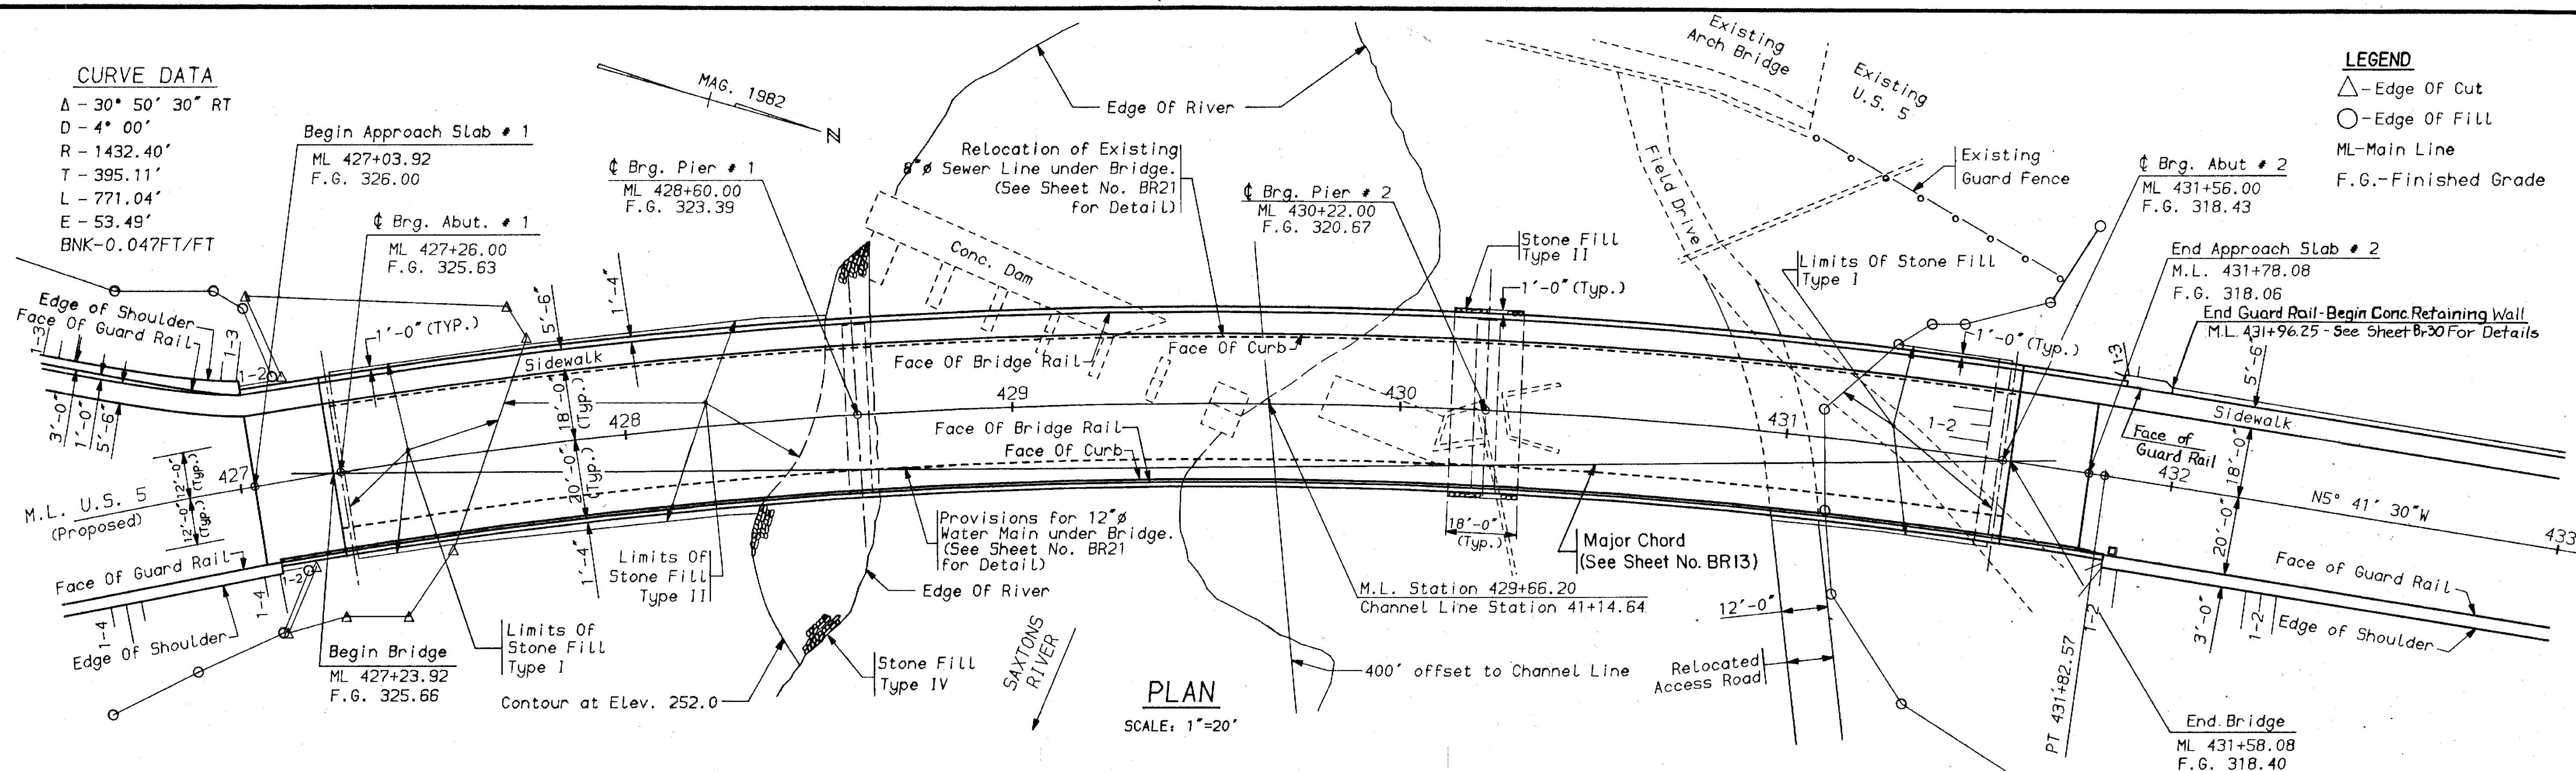


STATEWIDE - SOUTHEAST
REGION
BHF MEMB(21)

SHEET 22 OF 34
BRIDGE 33
FOR REFERENCE ONLY

STEINMAN BOYNTON GRONQUIST & BIRDSALL
CONSULTING ENGINEERS
NEW YORK N.Y.

STATE OF VERMONT AGENCY OF TRANSPORTATION

TOWN OF WESTMINSTER		Bridge No. 833	
HIGHWAY NO. U. S. 5		Log Sta. 432 + 00	
		Surv. Sta. 430 + 00	
U. S. 5 OVER SAXTONS RIVER			
GENERAL PLAN AND ELEVATION			
Designed by P. CHASE		Drawn by E. REIZE	
Checked by J. HANKE date 9/84		Bridge Design Supervisor T. A. FISHER date 10/84	
PROJECT WESTMINSTER-ROCKINGHAM		PROJECT NO. BRS 0113(15)	
Bridge Sheet No. BR 8		Sheet 85 of 262	