


PROFILE - TH10

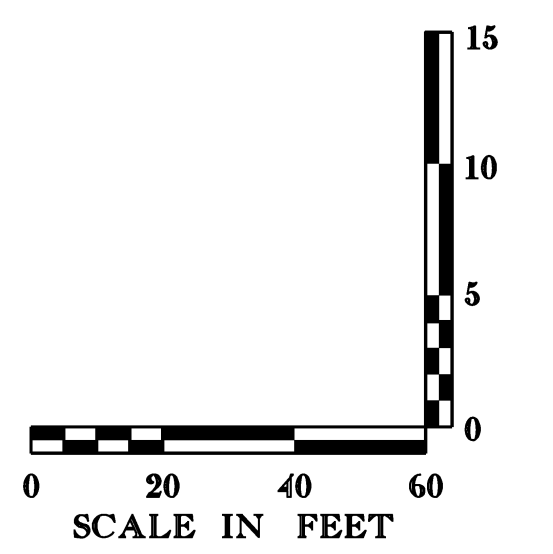

FILE NAME = \$FILE\$
DATE/TIME = \$DATE\$
USER = \$USER\$

DATUM	
VERTICAL	NAVD 88
HORIZONTAL	NAD 83 (92)

NOTE:
1. THE GRADES SHOWN TO THE NEAREST TENTH ARE THE ORIGINAL GROUND ELEVATIONS ALONG CENTERLINE. THE GRADES SHOWN TO THE NEAREST HUNDREDTH ARE THE PROPOSED GRADES ALONG CENTERLINE.



TH 10 PROFILE #1	PROJECT NAME: RUTLAND CITY	PLOT DATE: \$DATE\$
	PROJECT NUMBER: BRF 3000 (19)	DRAWN BY: C. HARDIN
	PROJECT LEADER: M. SARGENT	CHECKED BY: D. GOZALKOWSKI
	DESIGNED BY: C. HARDIN	ROW SHEET 9 OF 20
	DWG. NO.:	