


**PLAN**  
SCALE 1" = 10'-0"

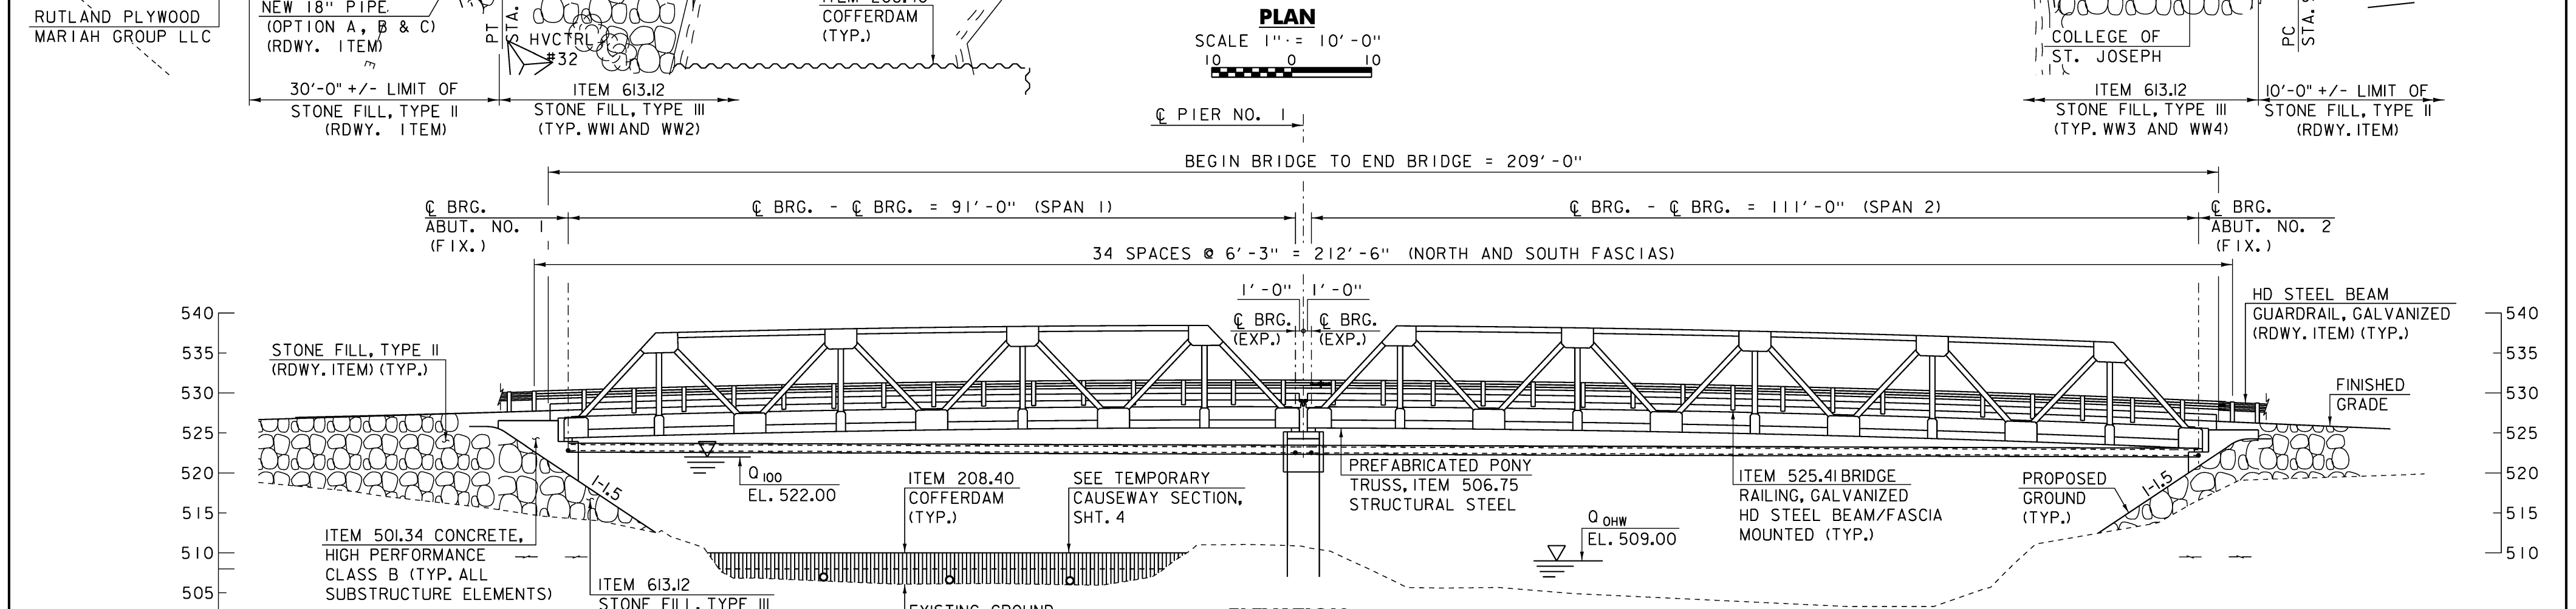

**ELEVATION**  
SCALE 1" = 10'-0"

<b>PLAN AND ELEVATION</b>	PROJECT NAME: RUTLAND CITY	PLOT DATE: \$DATE\$
	PROJECT NUMBER: BRF 3000 (19)	DRAWN BY: D. D'AMATO
	PROJECT LEADER: M. SARGENT	CHECKED BY: P. PERKINS
	DESIGNED BY: D. D'AMATO	ROW SHEET 13 OF 100
DWG. NO.:		



FILE NAME = \$FILES\$  
DATE/TIME = \$DATE\$  
USER = \$USER\$