


MAD RIVER

INSTALL NEW 3" X 5" (TRUE) ROOF RAFTER. SISTER WITH EXISTING 3" X 5" (TRUE). ATTACH WITH 2 - #14 X 4" FLAT HEAD SCREWS AT 1'-6" SPACING.


NEW 3" X 5" RAFTER MOVED TO OPPOSITE SIDE OF EXISTING RAFTER

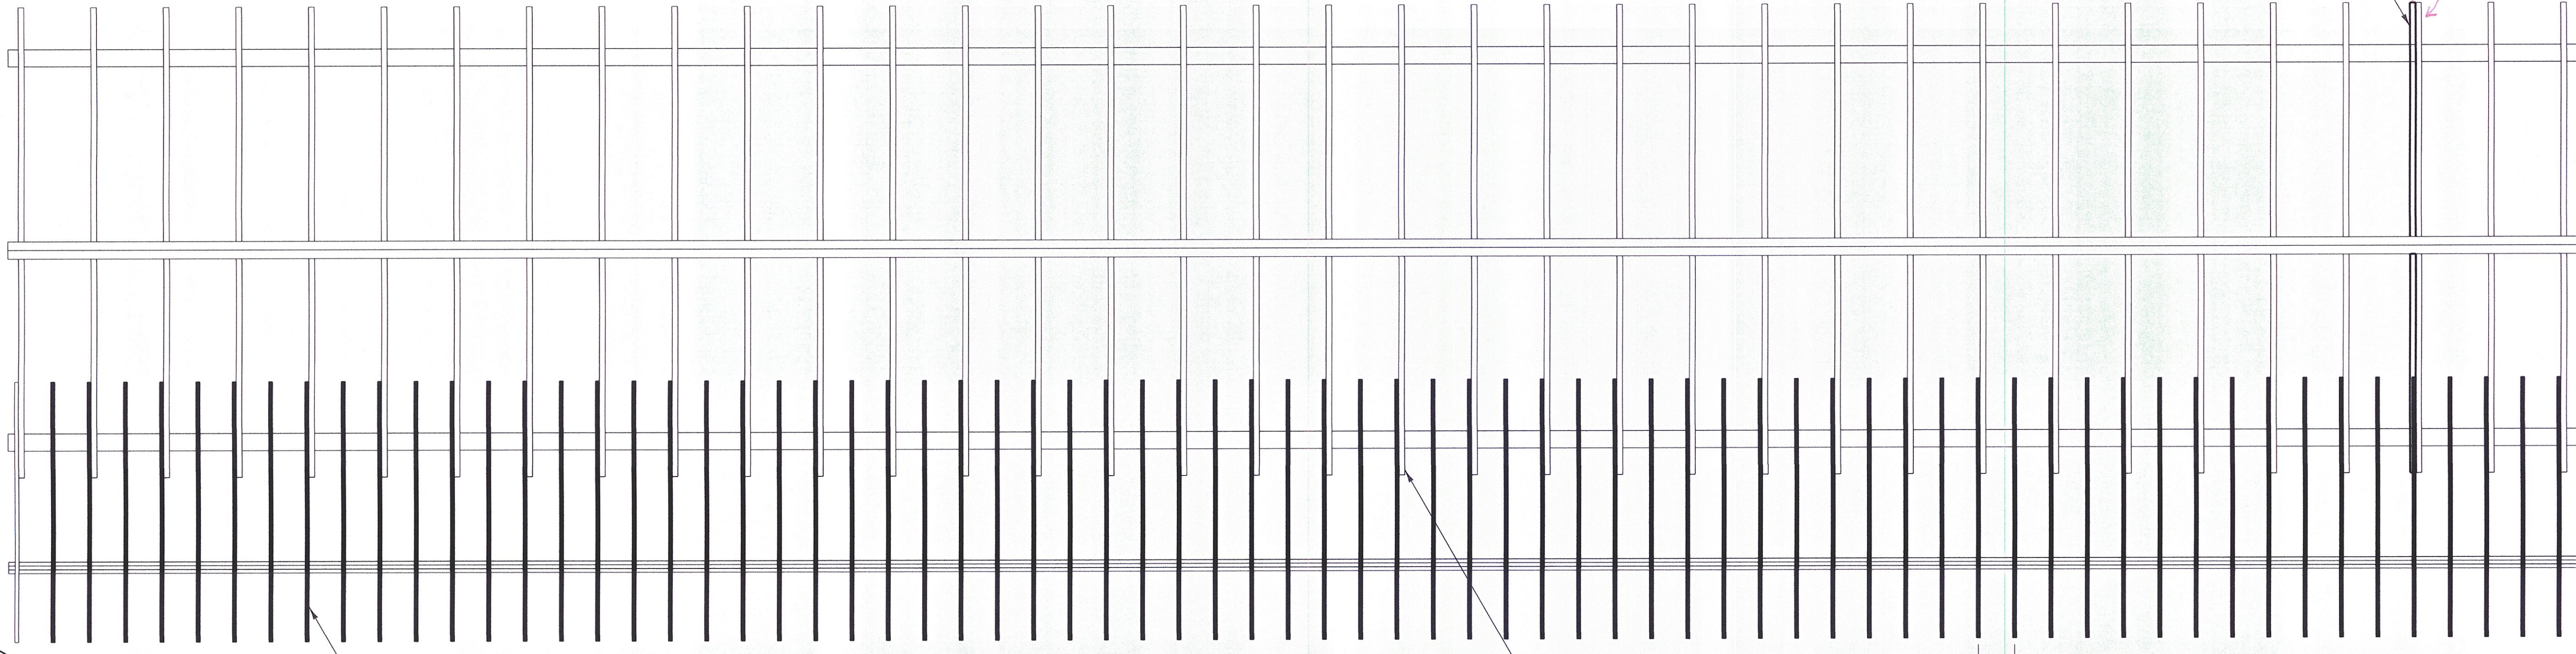

ROOF FRAMING PLAN

SCALE: 1/4" = 1'-0"

SEE ATTACHMENT DETAIL, SHEET 11 (EVERY OTHER RAFTER) (TYP.)

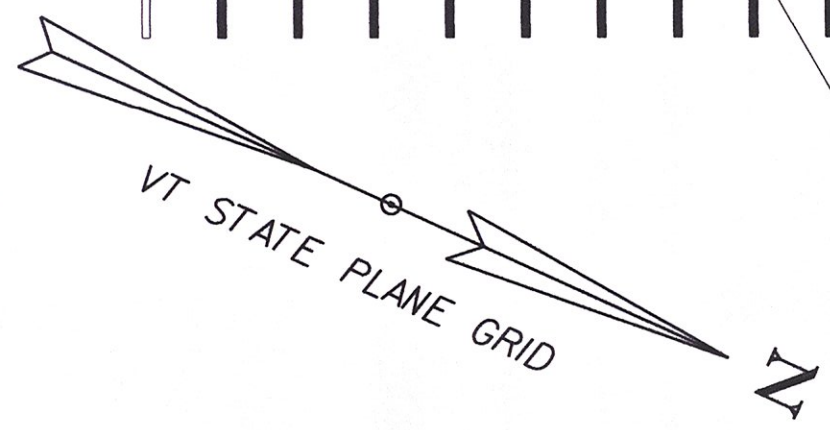


REPLACE 2" X 4" FULL SAWN (TRUE) SIDEWALK ROOF RAFTER (TYP. ALL SIDEWALK ROOF RAFTERS)

REMOVE AND REPLACE 10" X 12" (TRUE) FLOOR BEAM (TYP.)

INCLUDING #4, 31, and 41. REPLACED W/ DOUGLASS FIR PER D&K MEMO. 6-3-15. WORK DIRECTION #3

INSTALL MISSING 12" X 12" (TRUE) FLOOR BEAM

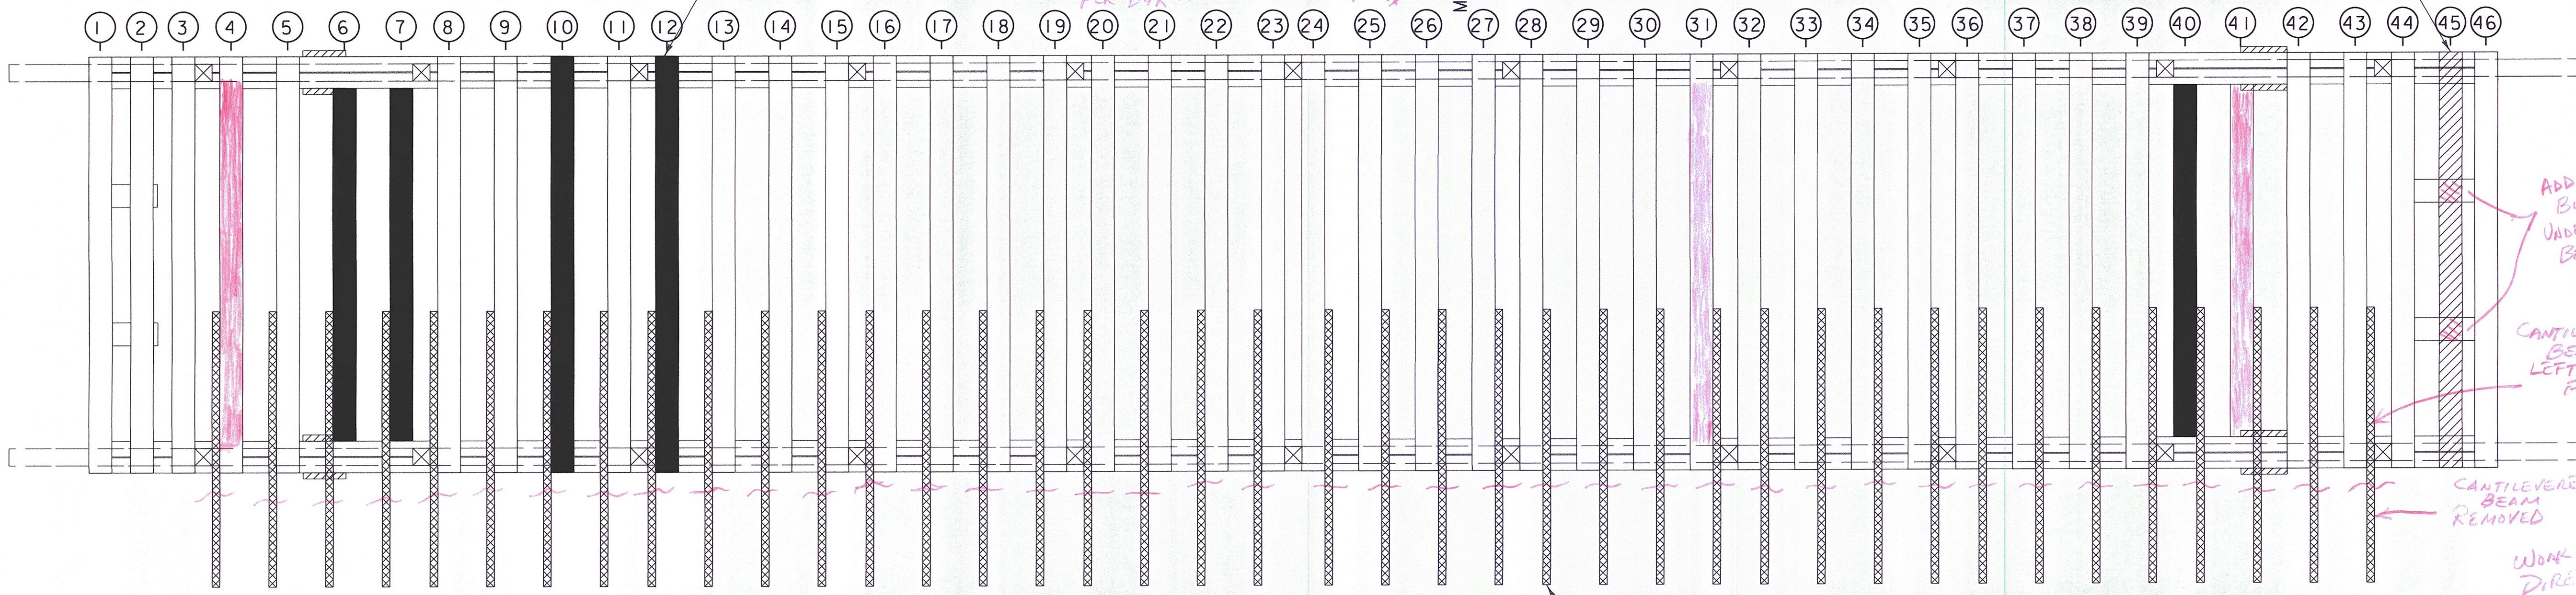

FLOOR FRAMING PLAN

SCALE: 1/4" = 1'-0"

REMOVE EXISTING CANTILEVER SIDEWALK BEAM (TYP.)

LEGEND

- ① = FLOORBEAM NUMBER
- = MEMBER TO BE REPLACED
- ▨ = MISSING MEMBER TO BE REPLACED
- ▩ = MEMBER TO BE REMOVED

DATUM
VERTICAL NAVD 88
HORIZONTAL NAD 83 (GPS)

PLOTTED 12/30/2014

DuBois & King Inc.
ENGINEERING • PLANNING • MANAGEMENT • DEVELOPMENT
6 GREEN TREE DRIVE
SOUTH BURLINGTON, VT 05403
TEL: (802) 878-7661
FAX: (866) 783-7101
www.dubois-king.com
RANDOLPH, VT
SPRINGFIELD, VT
BEDFORD, NH
LACONIA, NH
© Copyright 2014 DuBois & King Inc.
PROFESSIONAL SEAL

FINAL PLANS

TOWN OF WAITSFIELD
9 BRIDGE STREET
WAITSFIELD, VT

VILLAGE COVERED
BRIDGE REHAB. &
BRIDGE STREET
STORMWATER
IMPROVEMENTS

SHEET TITLE
**ROOF FRAMING &
FLOOR FRAMING
PLAN**

DRAWN BY	DATE
RHB/JDG	DEC. 2014
CHECKED BY	D&K PROJECT #
RHD	620922
PROJ. ENG.	D&K ARCHIVE #
RHB	620922

SHEET NUMBER

13

SHEET 13 OF 30

i:\620922 - Waitsfield\DESIGN\CADD FILES\620922_SIP.dgn