
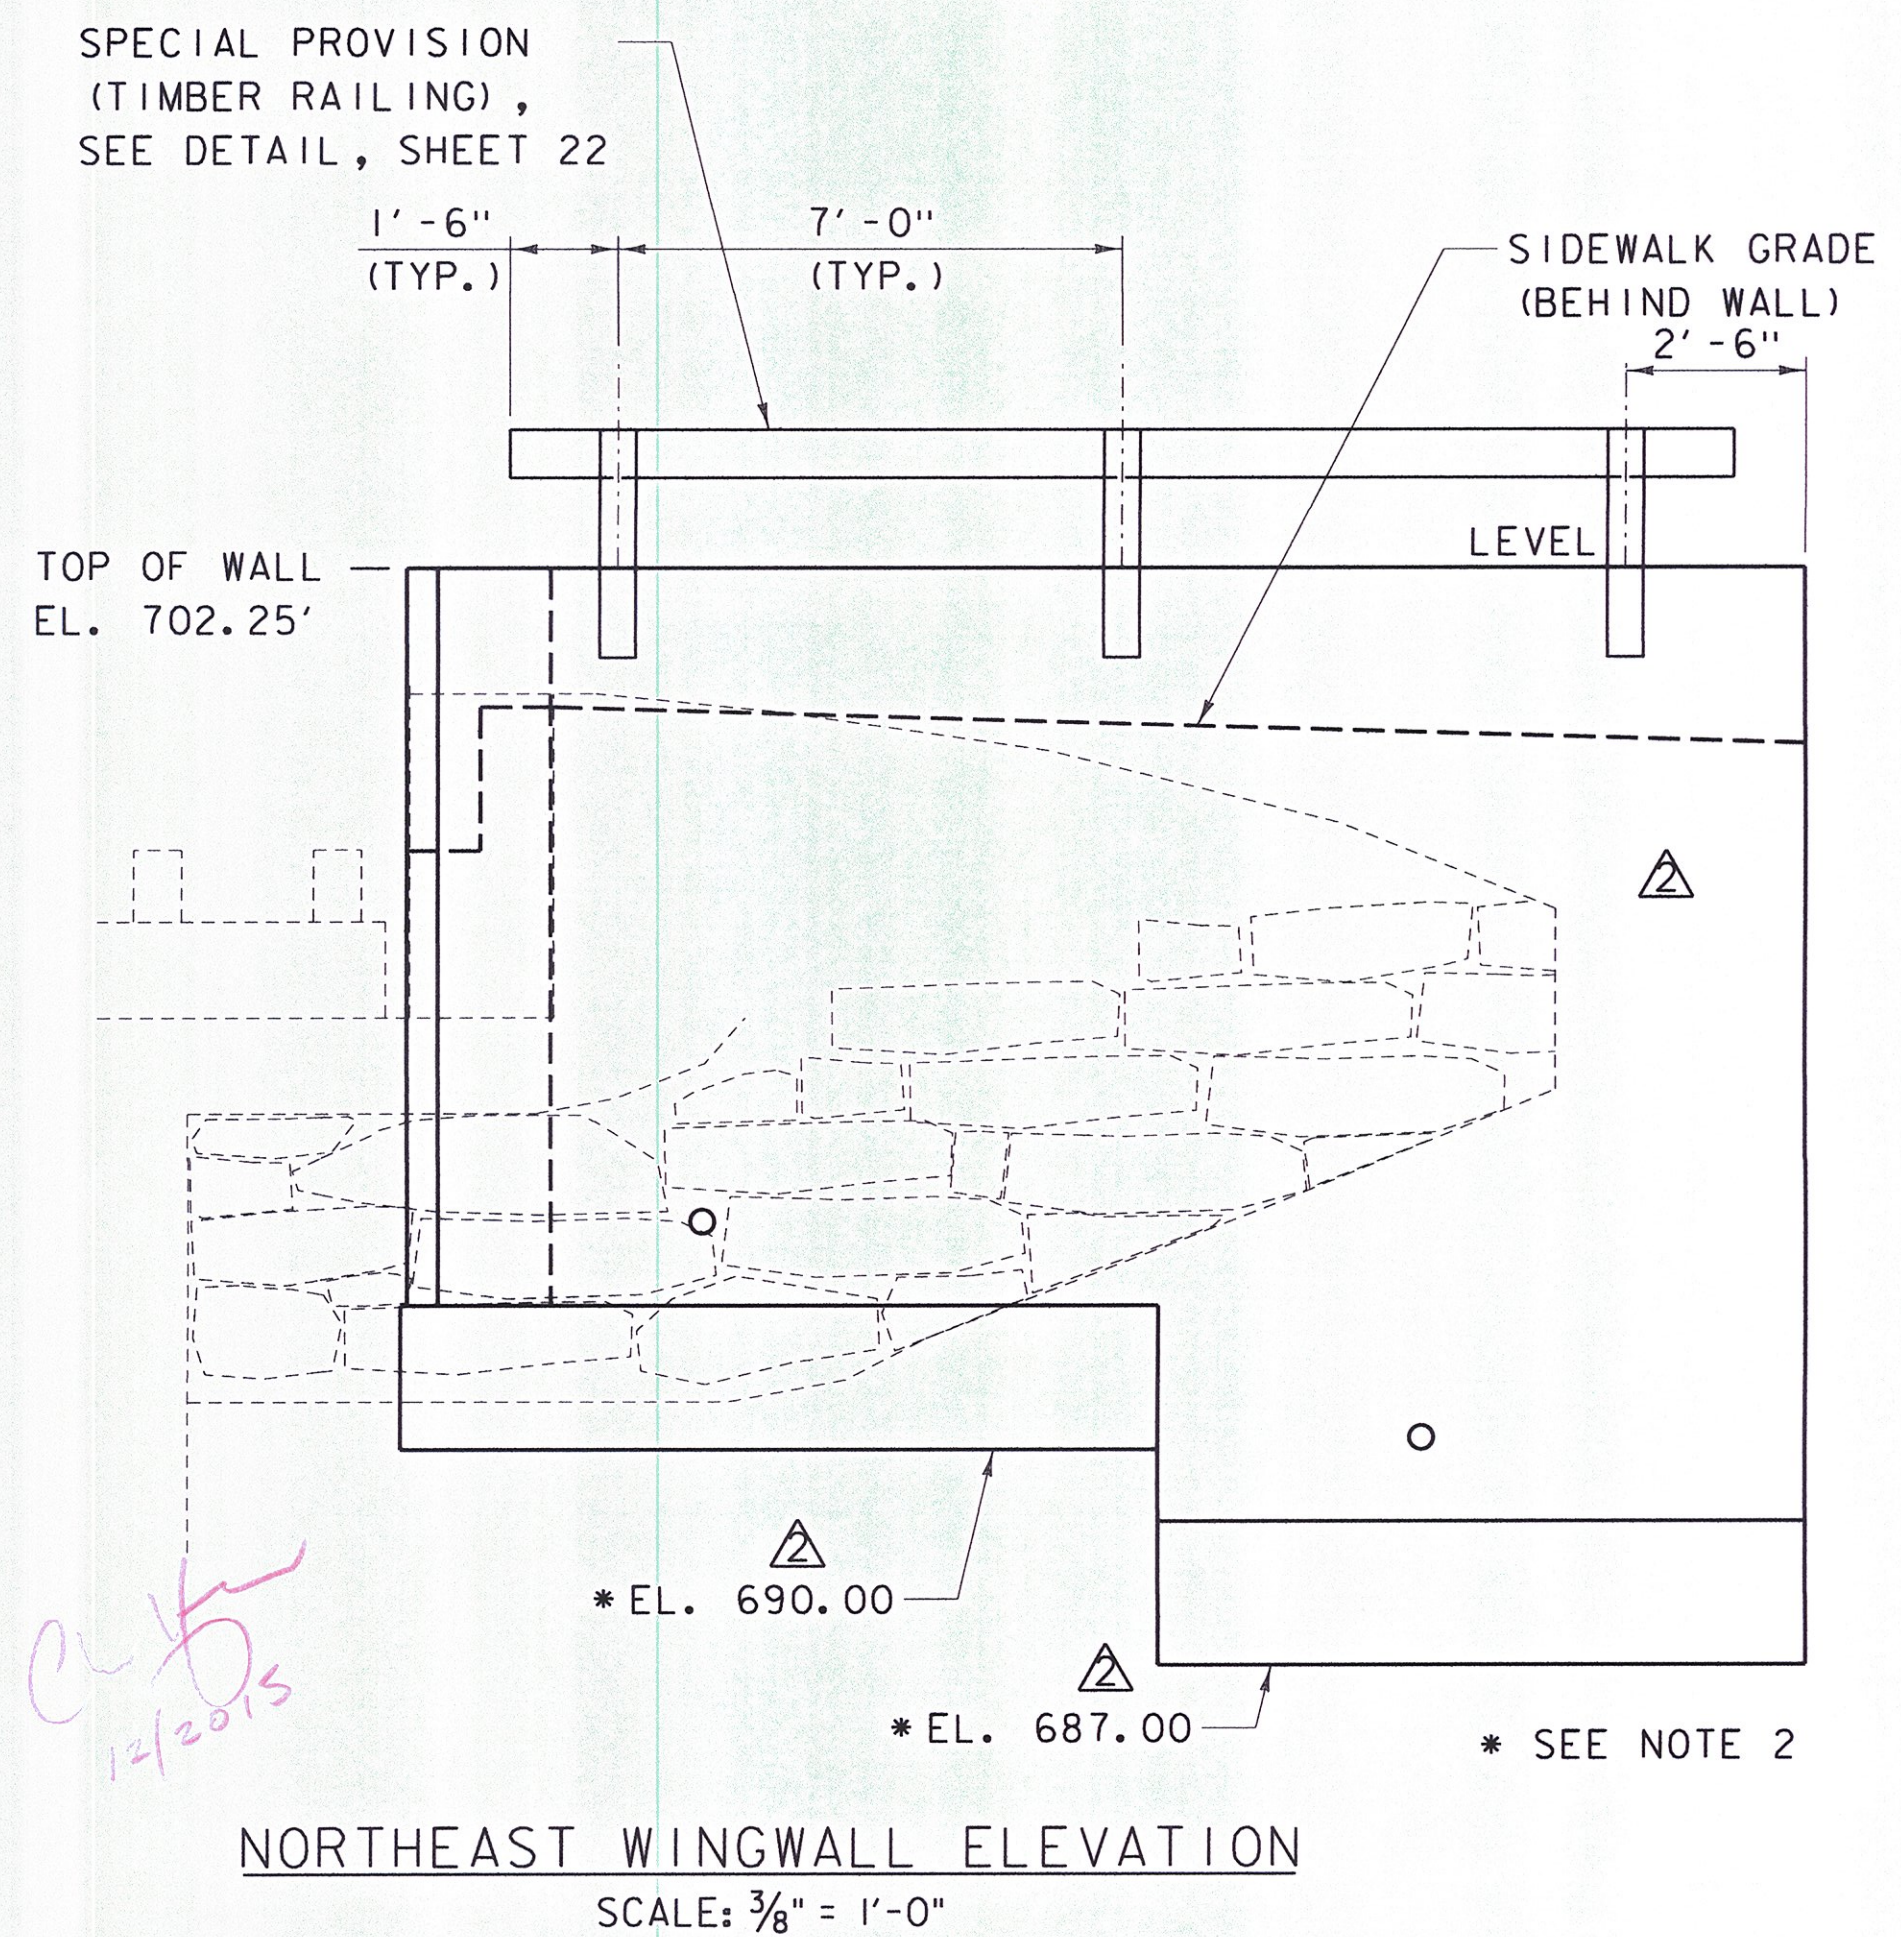
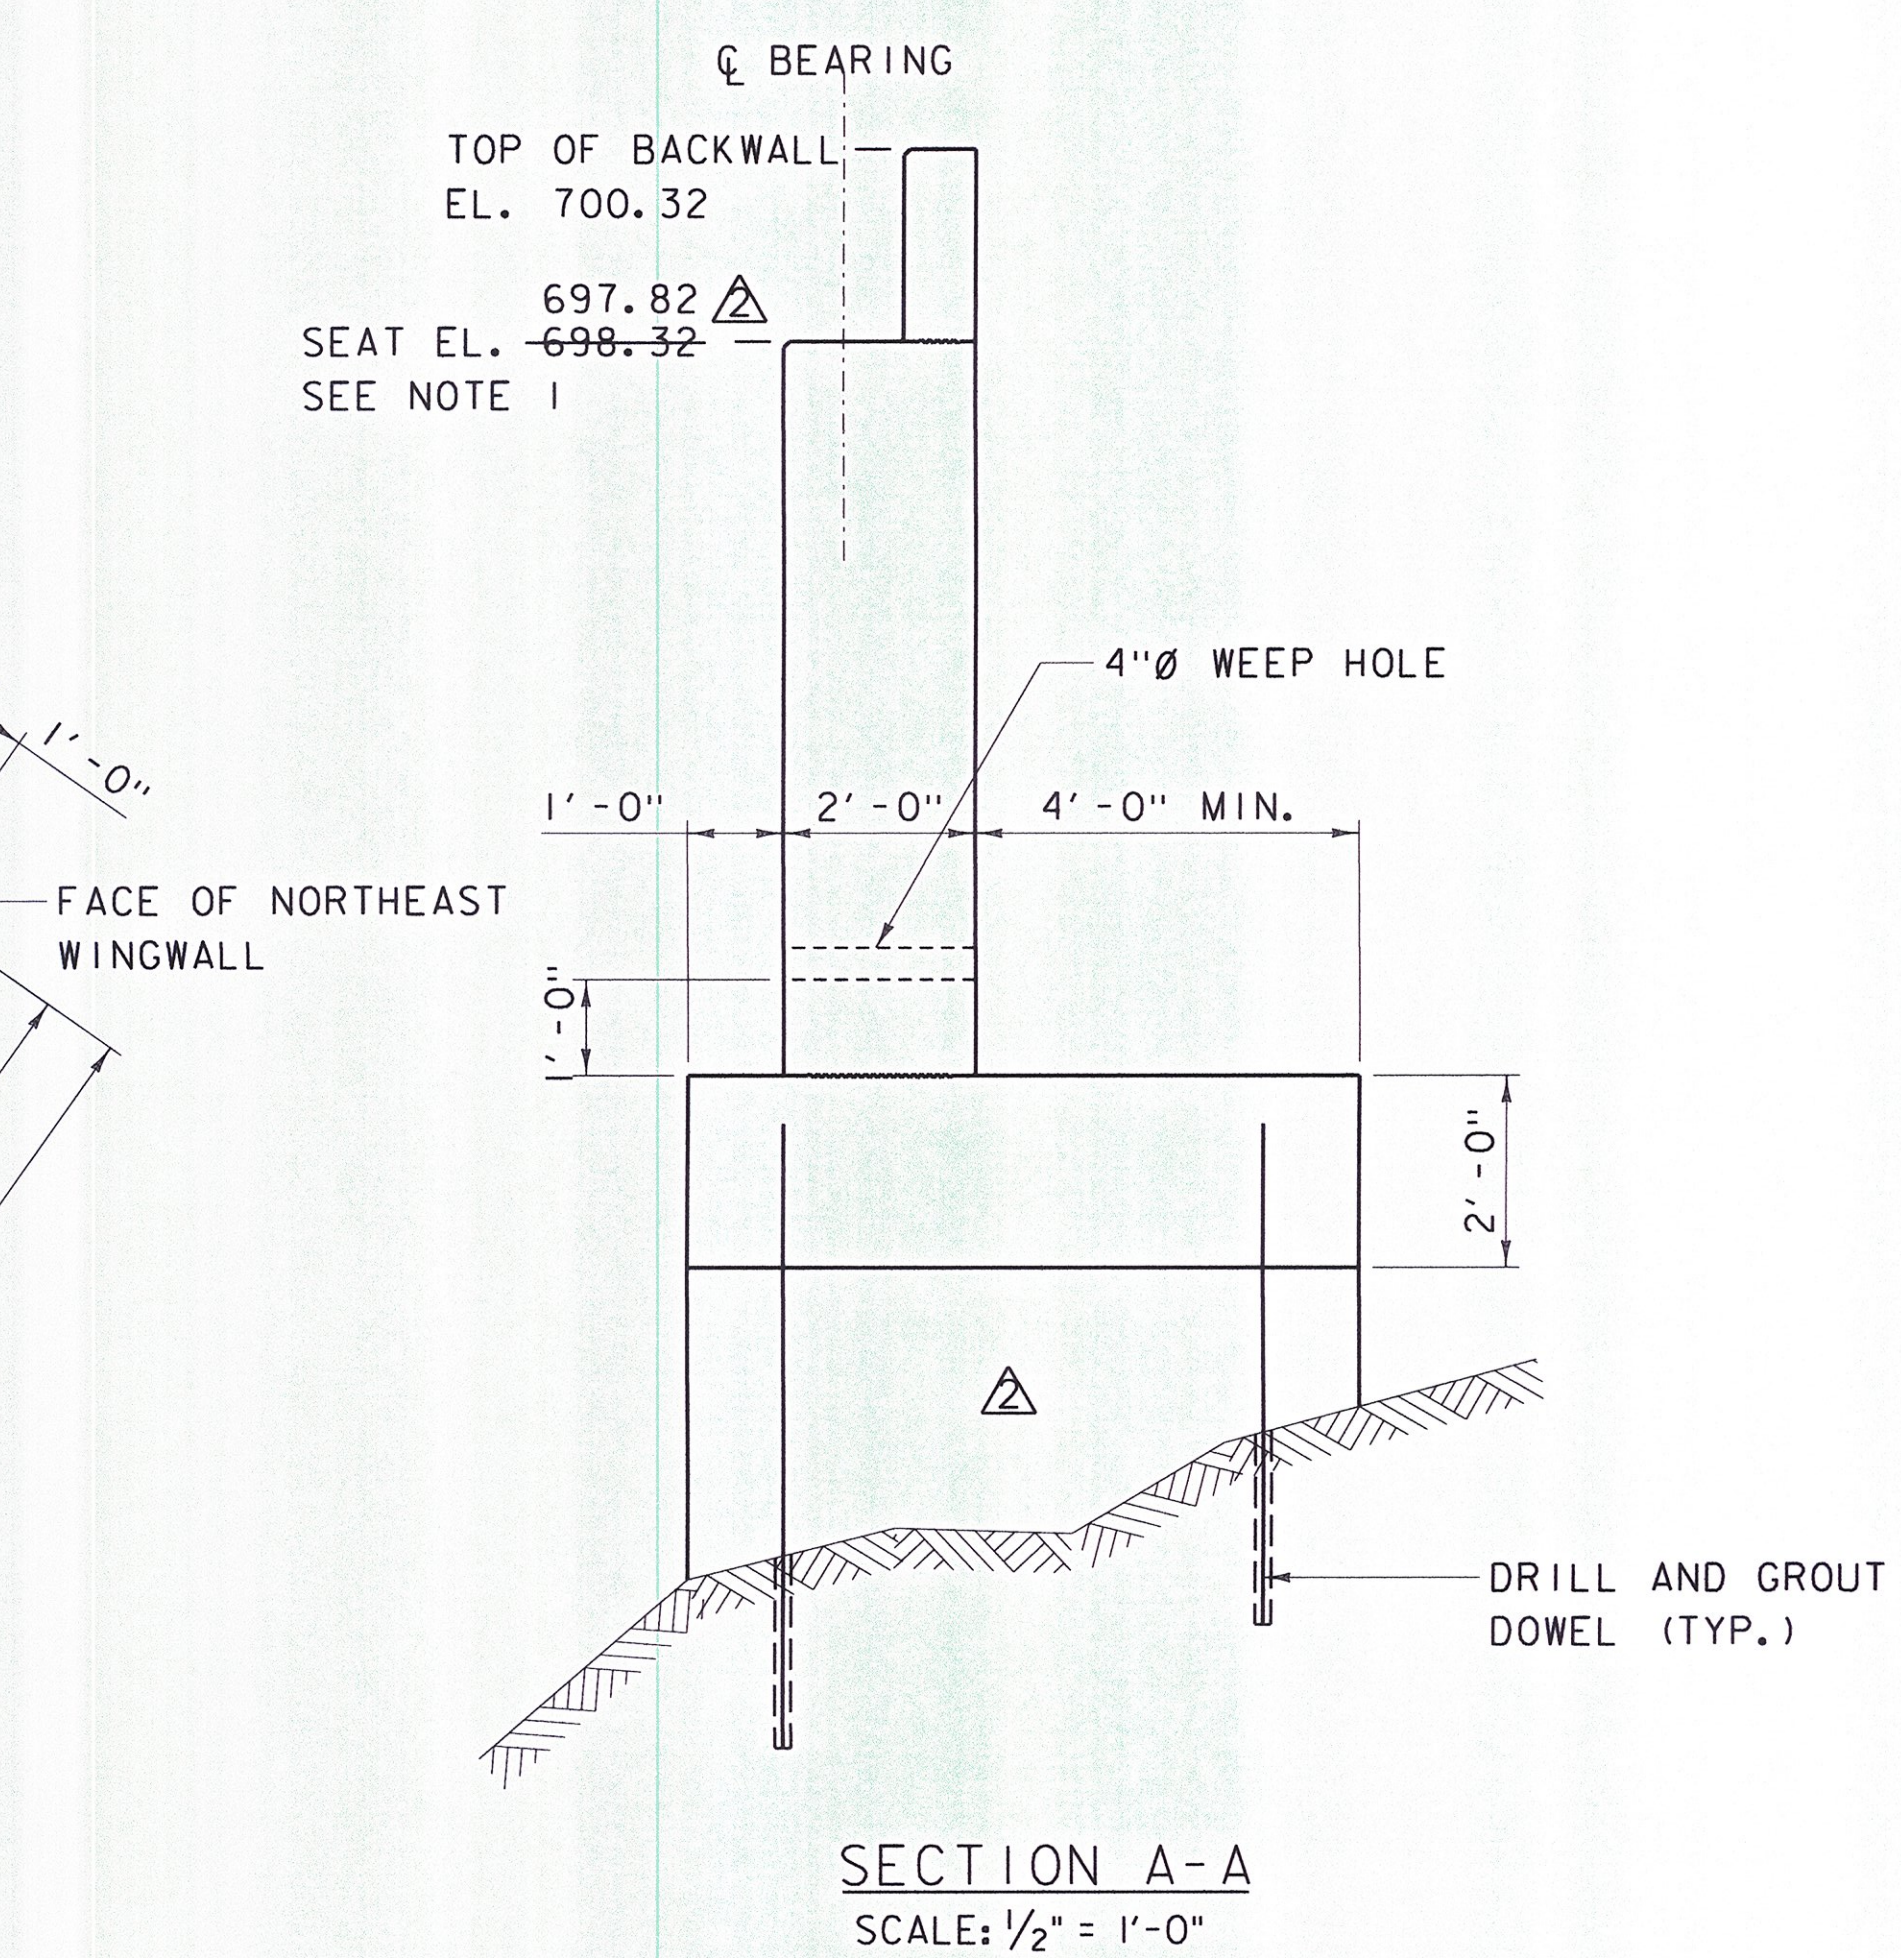


**NOTES:**

- ELEVATION IS BASED ON A 2'-0" DEPTH OF SUPERSTRUCTURE AND BEARING FROM FINISHED GRADE TO BRIDGE SEAT. IF A DIFFERENT DEPTH OF SUPERSTRUCTURE AND BEARING IS USED, ADJUST THIS ELEVATION ACCORDINGLY, WHILE MAINTAINING A LOW CHORD NO LOWER THAN EL. 698.65. 697.94 NORTH BOTTOM
- BOTTOM OF FOOTING ELEVATIONS AND FOOTING STEPS SHOWN ARE BASED ON AVAILABLE INFORMATION. FOOTING STEPS ARE INTENDED TO APPROXIMATELY MATCH EXISTING LEDGE PROFILE. REFER TO SHEET 4 FOR ADDITIONAL INFORMATION REGARDING FOUNDATION PREPARATION AND THE NEW CONCRETE FOOTINGS.
- DETERIORATED CONCRETE AT WEST SIDE OF NORTH ABUTMENT TO BE REPAIRED USING ITEM 501.34, "CONCRETE, HIGH PERFORMANCE CLASS B". FORMING TO FOLLOW SMOOTH CONCRETE SURFACES OF ABUTMENT AND WINGWALL. REFER TO SHEET 4, CONCRETE REPAIR NOTES FOR SURFACE PREPARATION INFORMATION. PAYMENT FOR SURFACE PREPARATION SHALL BE MADE ITEM 529.25. PAYMENT FOR CONCRETE SHALL BE MADE UNDER ITEM 501.34.

= APPROX. DETERIORATED OR SPALLED CONCRETE AREA

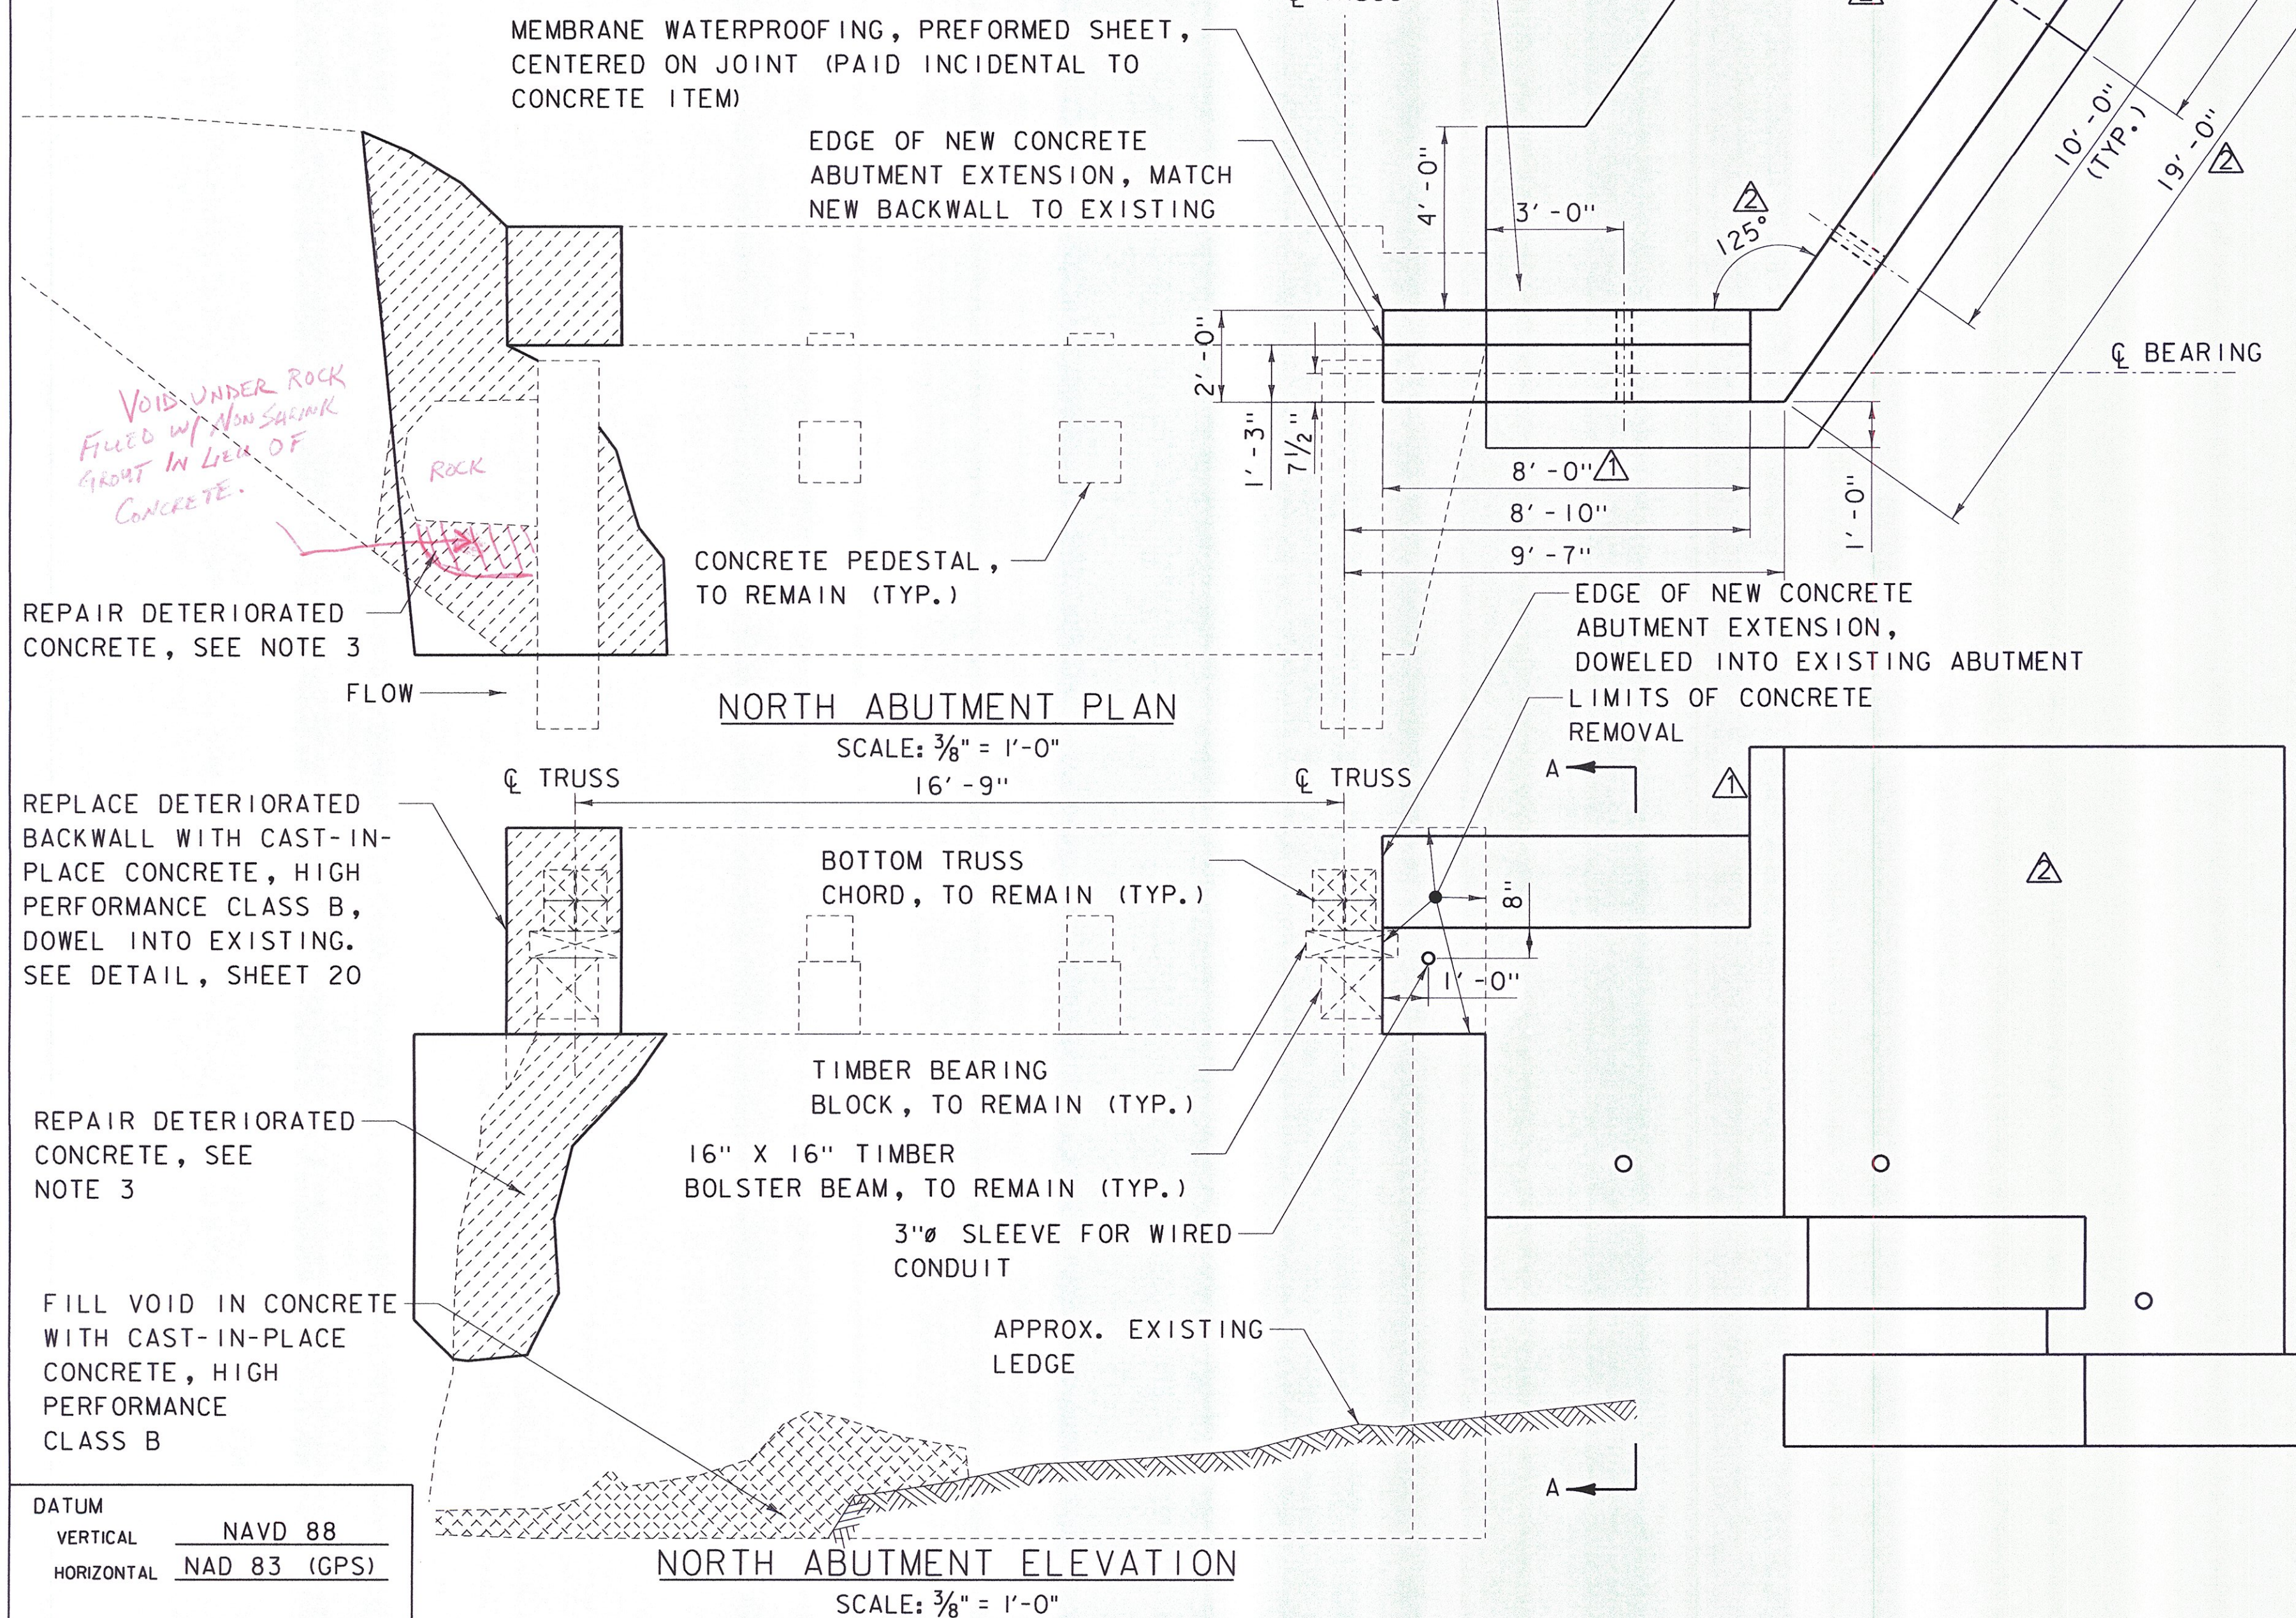

**DuBois & King Inc.**  
 ENGINEERING • PLANNING • MANAGEMENT • DEVELOPMENT  
 6 GREEN TREE DRIVE  
 SOUTH BURLINGTON, VT 05403  
 TEL: (802) 878-7651  
 FAX: (866) 783-7101  
 www.dubois-king.com  
 RANDOLPH, VT  
 SPRINGFIELD, VT  
 BEDFORD, NH  
 LACONIA, NH  
 © Copyright 2014 DuBois & King Inc.  
 PROFESSIONAL SEAL

**FINAL PLANS**

NO.	DATE	DESCRIPTION	BY	CRD
1	8/10/15	NORTH EAST WALL UPDATE	PCB	
2	7/31/15	WALL UPDATES	PCB	

TOWN OF  
 WAITSFIELD  
 9 BRIDGE STREET  
 WAITSFIELD, VT

VILLAGE COVERED  
 BRIDGE REHAB. &  
 BRIDGE STREET  
 STORMWATER  
 IMPROVEMENTS

SHEET TITLE  
 NORTH ABUTMENT &  
 NORTHEAST  
 WINGWALL  
 MASONRY

DRAWN BY	DATE
RHB/JDG	DEC. 2014
CHECKED BY	D&K PROJECT #
RHD	620922
PROJ. ENG.	D&K ARCHIVE #
RHB	620922

SHEET NUMBER

**16**

I:\620922 - Waitsfield\DESIGN\CADD FILES\620922\_SIB.dgn PLOTTED 8/11/2015