

**FINAL PLANS**

NO.	DATE	DESCRIPTION	BY	CHK'D
1	05/29/2015	PROFILE REVISIONS		

TOWN OF  
WAITSFIELD  
9 BRIDGE STREET  
WAITSFIELD, VT



VILLAGE COVERED  
BRIDGE REHAB. &  
BRIDGE STREET  
STORMWATER  
IMPROVEMENTS

SHEET TITLE  
ROADWAY CROSS  
SECTIONS

DRAWN BY	DATE
ZDC	MAY 2014
CHECKED BY	D&K PROJECT #
HLV	121447
PROJ. ENG.	D&K ARCHIVE #
HLV	

SHEET NUMBER

**28**

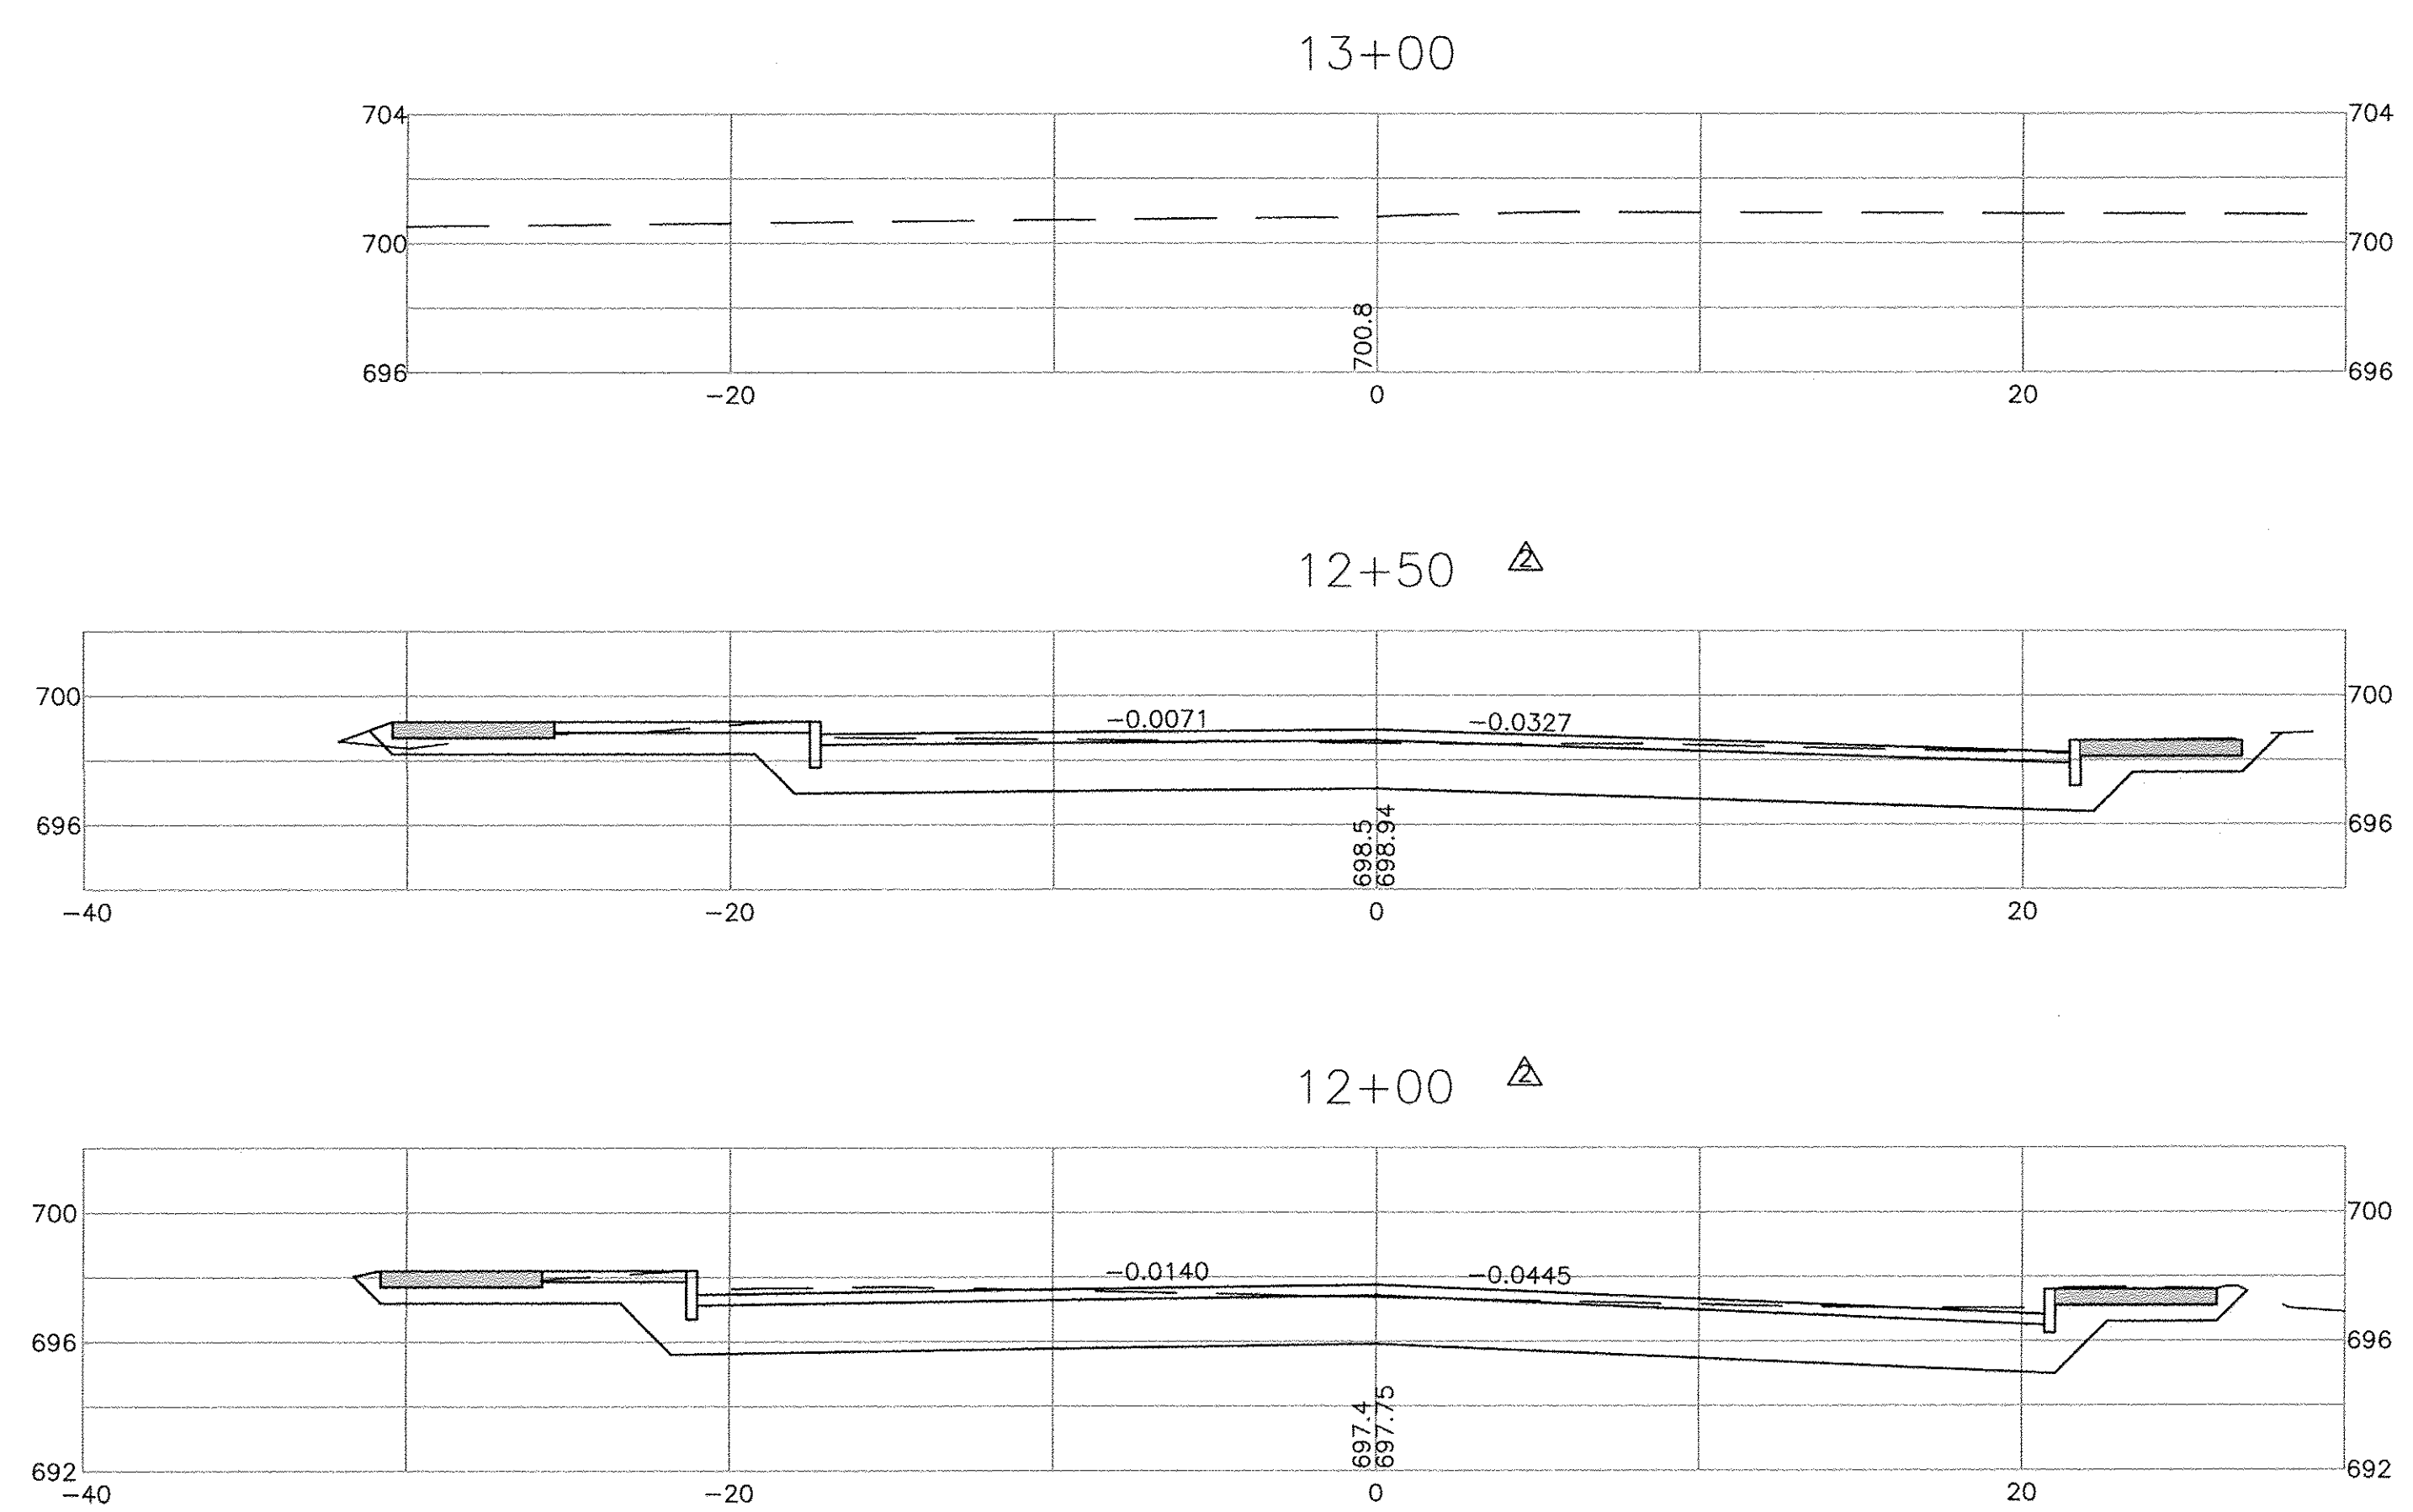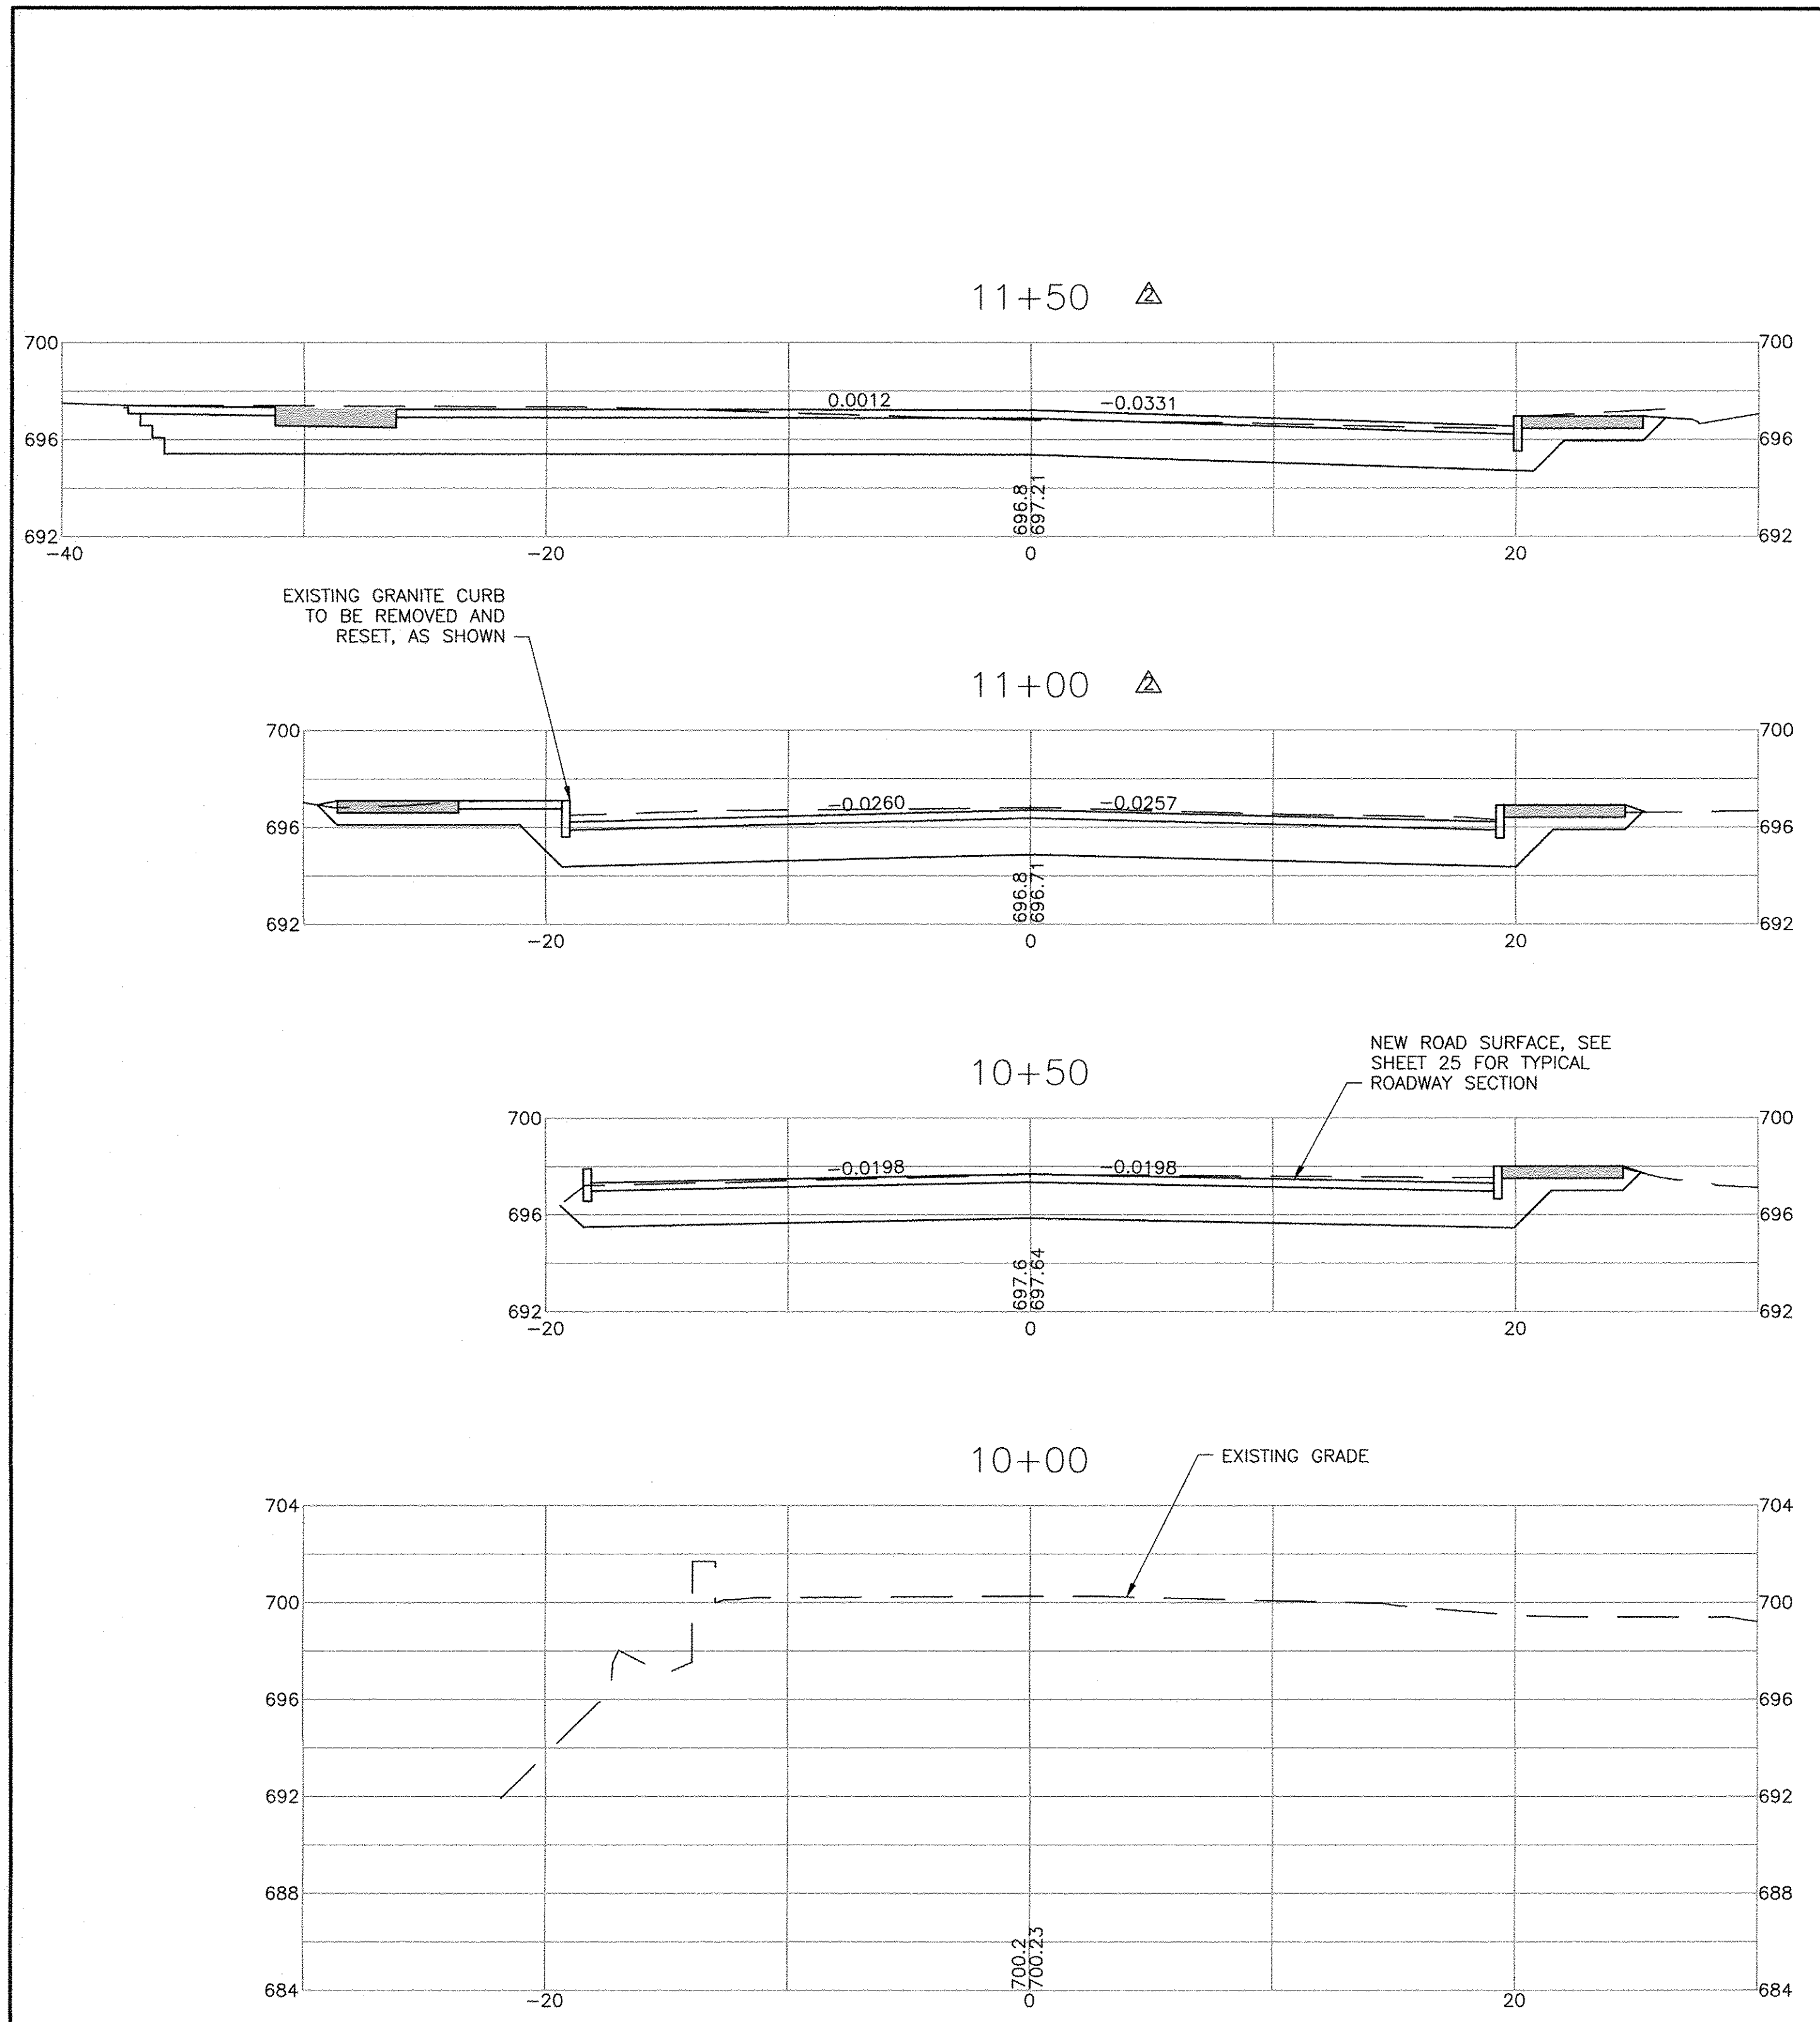

NOTE: FUTURE LIGHTING CONDUIT AND TRENCH NOT SHOWN ON CROSS SECTIONS.

