


TYPICAL SECTIONS 3

LEGEND

JT = EXISTING JOINT
 NJ = NEW JOINT
 CJ = NEW COMPROMISE JOINT

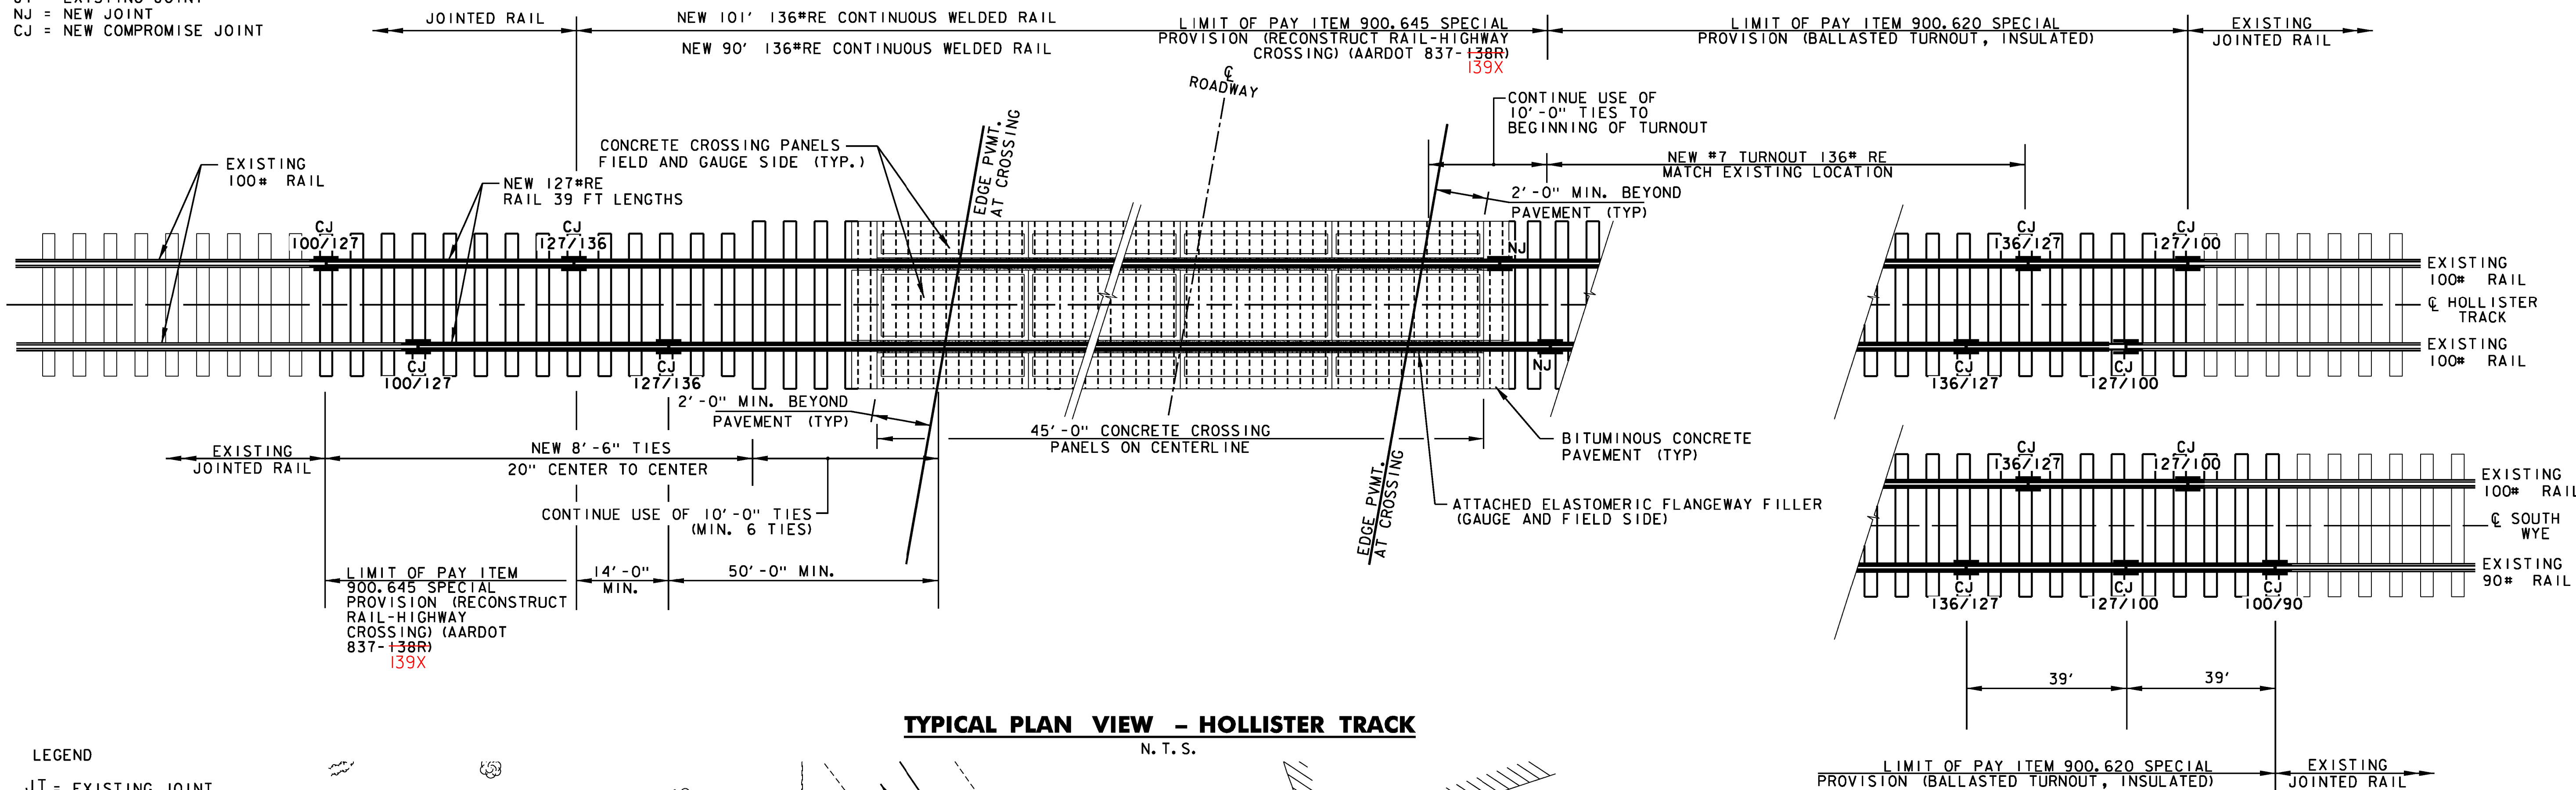


TYPICAL PLAN VIEW - HOLLISTER TRACK

N. T. S.

LEGEND

○ JT = EXISTING JOINT
 ● NJ = NEW JOINT
 ⊙ CJ = NEW COMPROMISE JOINT

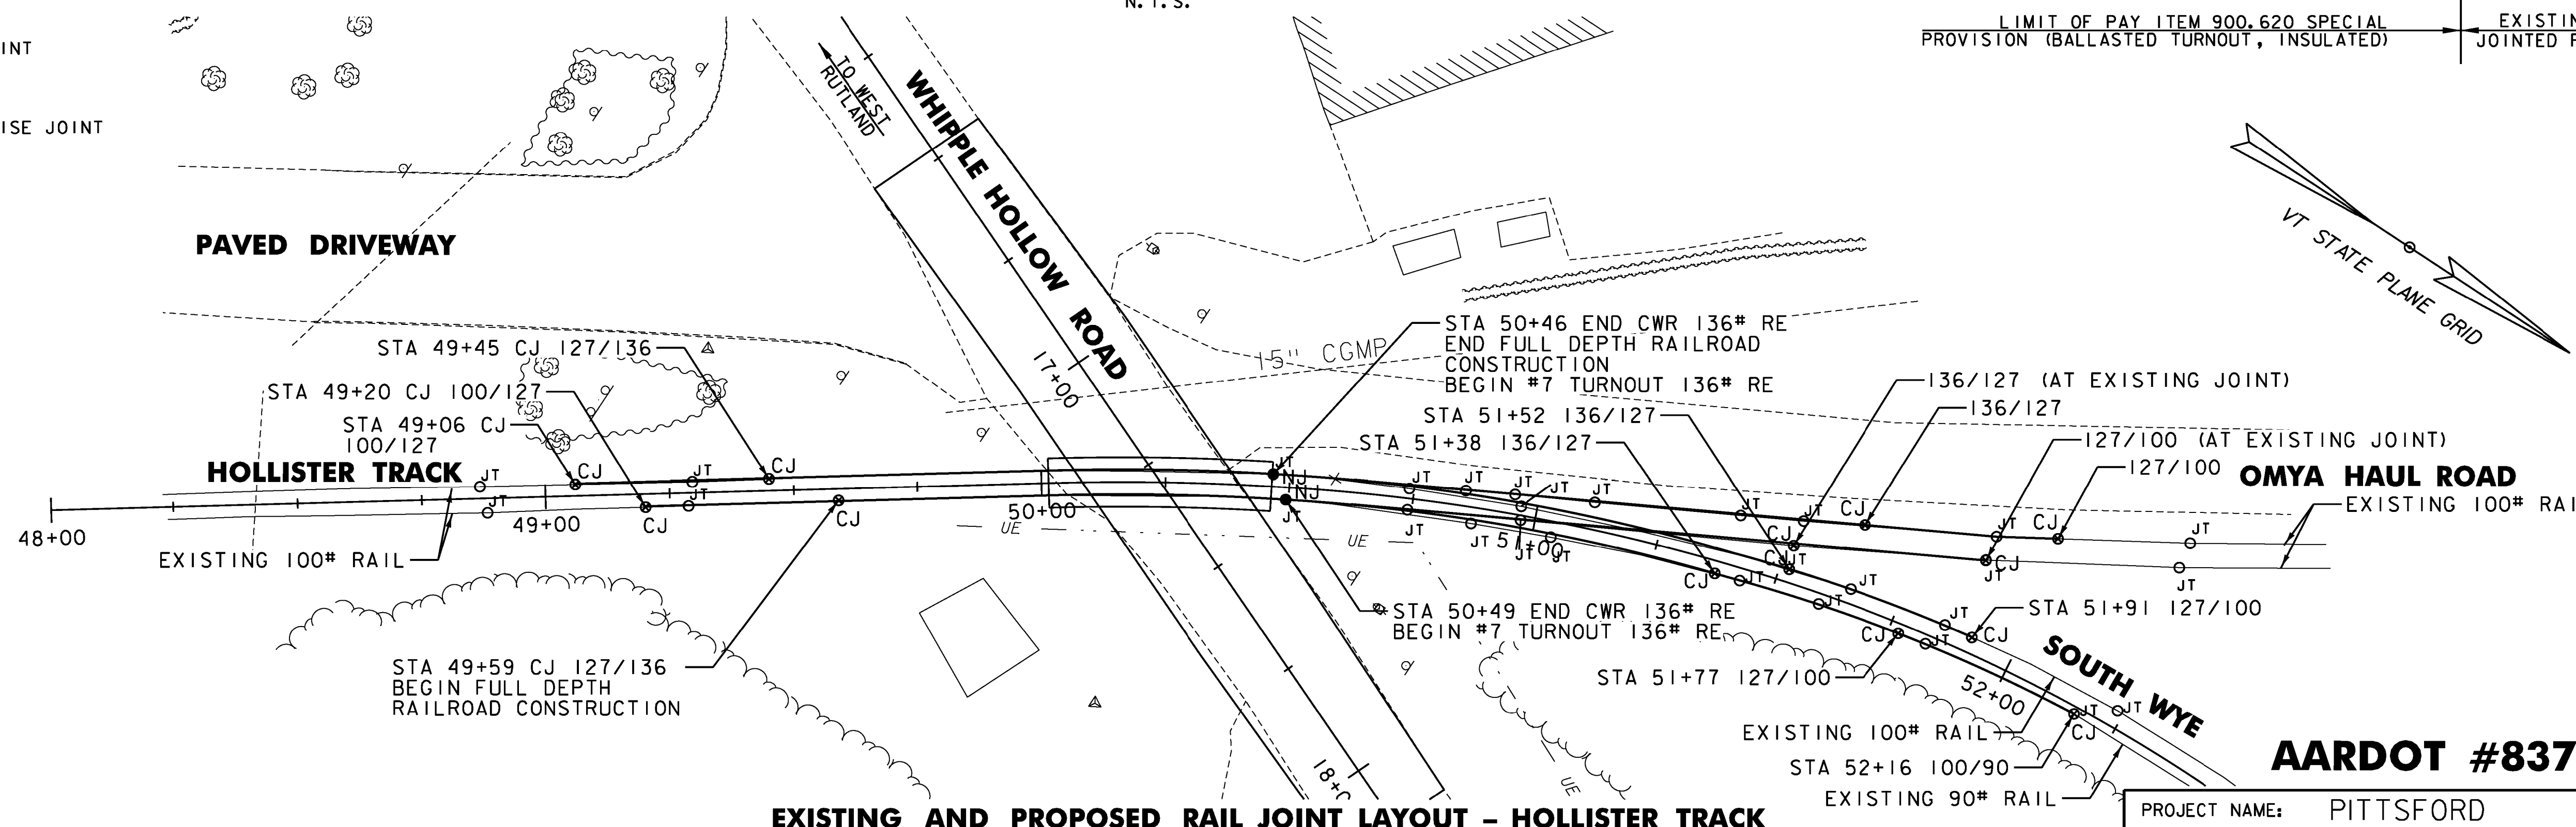

EXISTING AND PROPOSED RAIL JOINT LAYOUT - HOLLISTER TRACK



AARDOT #837-138R

PROJECT NAME: PITTSFORD
 PROJECT NUMBER: STP 2033(21)

FILE NAME: ...plotfiles\02 typicals.dgn PLOT DATE: 5/21/2013
 PROJECT LEADER: G. EDWARDS DRAWN BY: DKG
 DESIGNED BY: STANTEC CHECKED BY: KJR
TYPICAL SECTIONS - TYP 3 SHEET 5 OF 21

