



TYPICAL SECTIONS 4

LEGEND
 JT = EXISTING JOINT
 NJ = NEW JOINT
 CJ = COMPROMISE JOINT

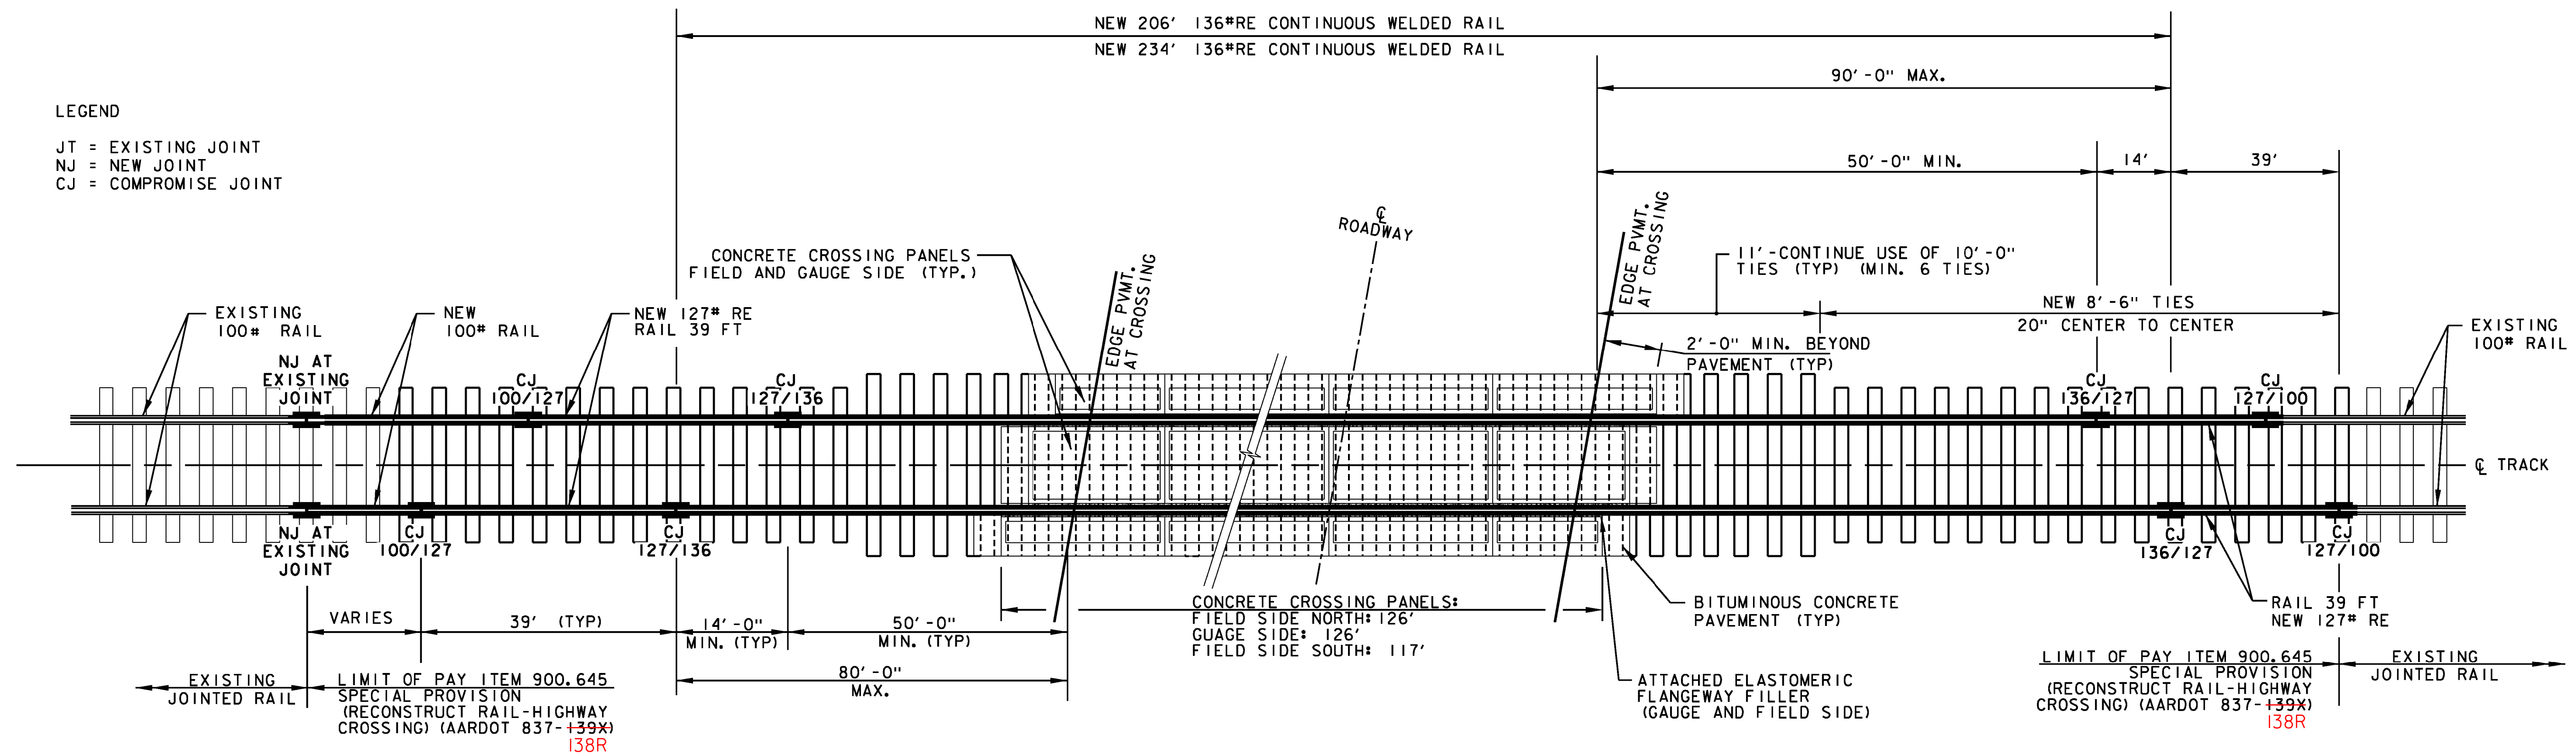

LEGEND
 ○JT = EXISTING JOINT
 ●NJ = NEW JOINT
 ⊗SJ = NEW COMPROMISE JOINT

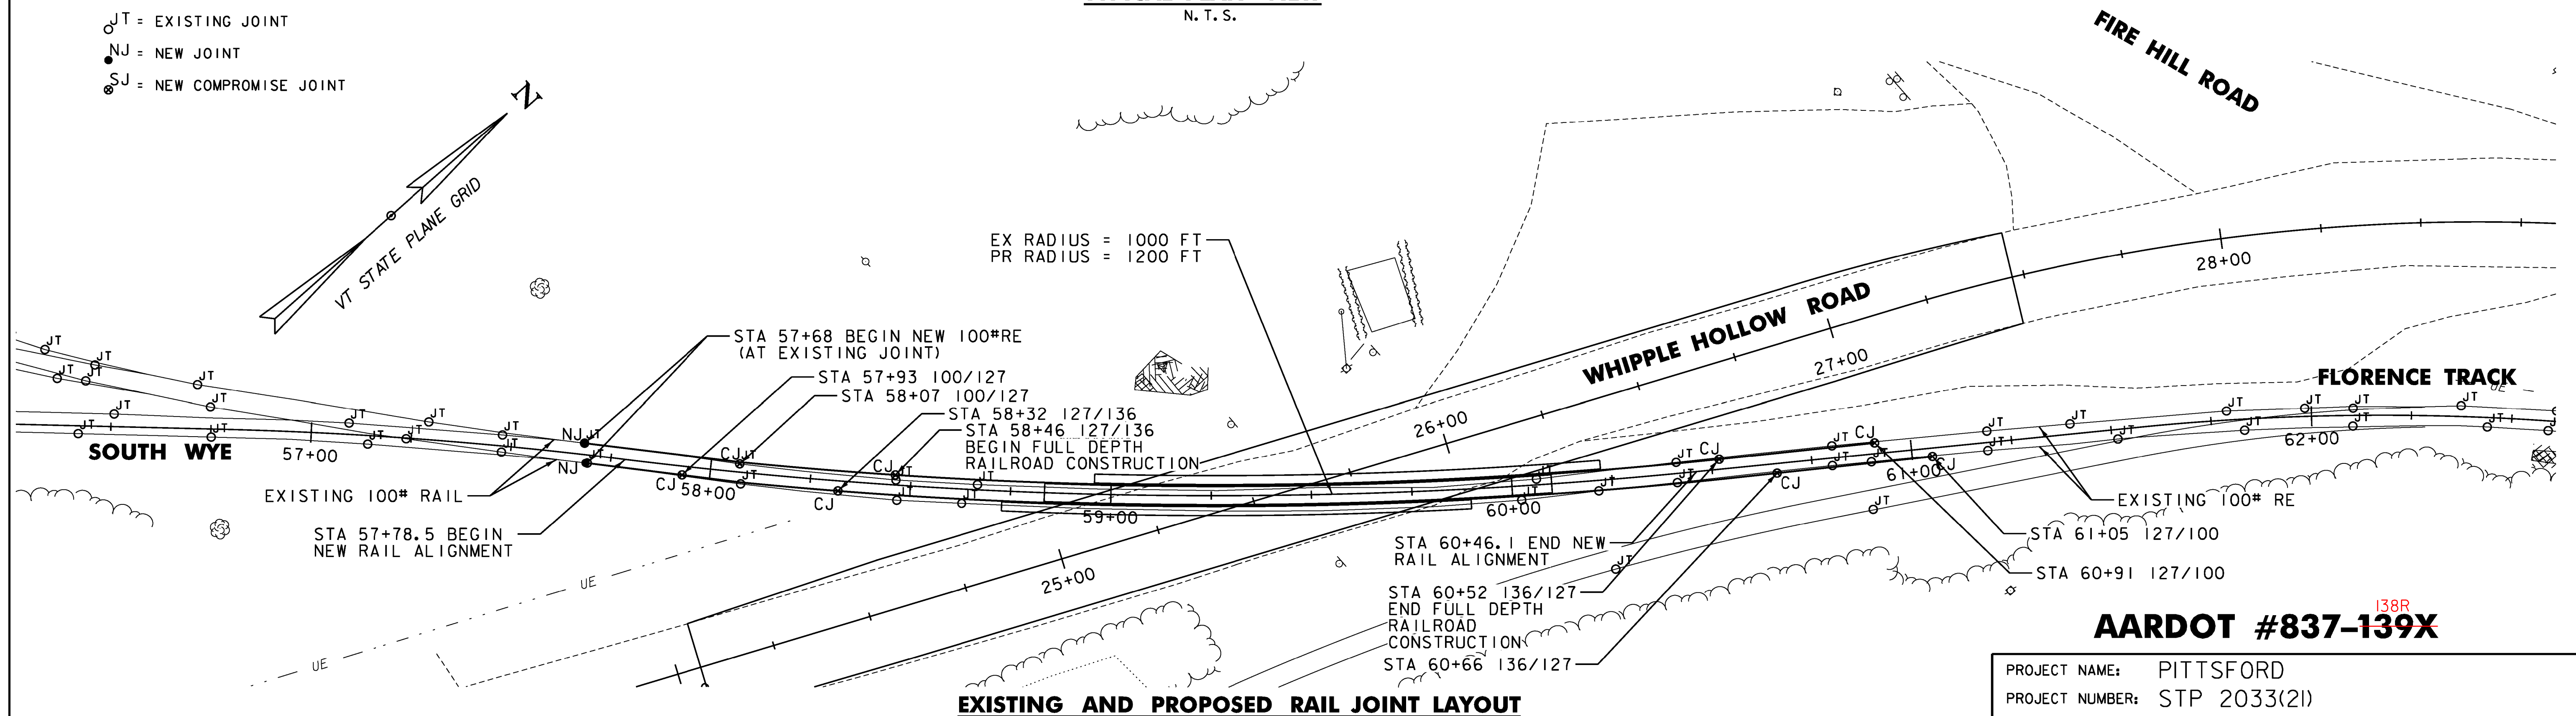

AARDOT #837-139X 138R

PROJECT NAME: PITTSFORD
 PROJECT NUMBER: STP 2033(21)

FILE NAME: ...plotfiles\02 typicals.dgn PLOT DATE: 5/21/2013
 PROJECT LEADER: G. EDWARDS DRAWN BY: DKG
 DESIGNED BY: STANTEC CHECKED BY: KJR
TYPICAL SECTIONS - TYP 4 SHEET 6 OF 21

