


PLACE 200' PRIOR TO STOP SIGN W10-4R

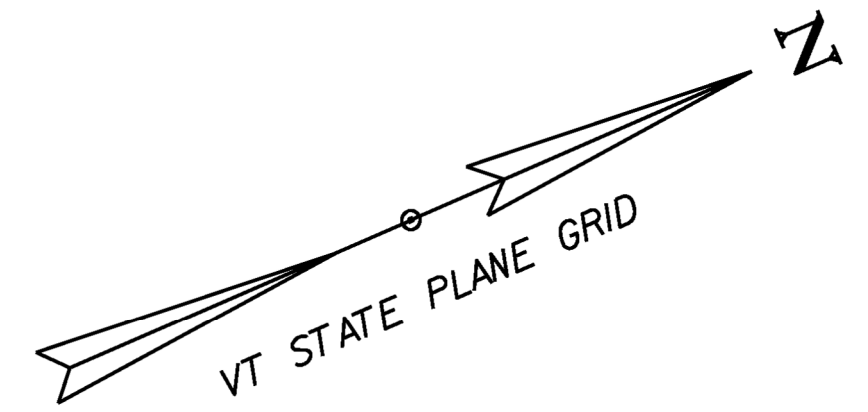

FIRE HILL ROAD

200'

DURABLE RAILROAD CROSSING SYMBOL

STA. 30+20 LT

REMOVING SIGNS

STA. 30+45 LT

MATCHLINE
SEE SHEET SP-3

LIMIT OF WORK

27+00

28+00

WHIPPLE HOLLOW ROAD

29+00

61+00


62+00

63+00


FLORENCE TRACK

64+00


STA. 30+20, LT.
W10-1

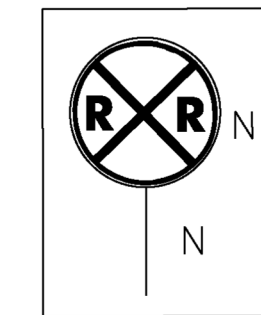

STA. 30+45, LT.

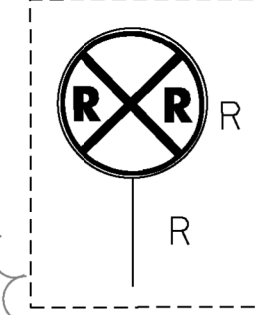

STA. 31+20, LT
W10-12R

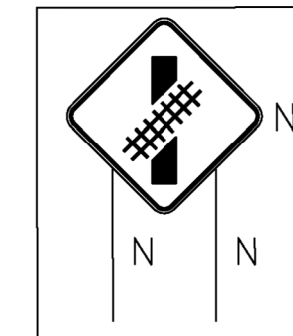

SIGN LEGEND

- N = NEW
- R = REMOVE
- R&S = REMOVE & SALVAGE
- S = SALVAGE SIGN
- RET = RETAIN
- B-B = BACK TO BACK



PROJECT NAME: PITTSFORD
PROJECT NUMBER: STP 2033(21)

FILE NAME: ...\\plotfiles\10 sign striping.dgn PLOT DATE: 5/21/2013
PROJECT LEADER: G. EDWARDS DRAWN BY: DKG
DESIGNED BY: STANTEC CHECKED BY: KJR
SIGNING, PAVEMENT MARKINGS SP-4 SHEET 15 OF 21