



STATE OF VERMONT AGENCY OF TRANSPORTATION

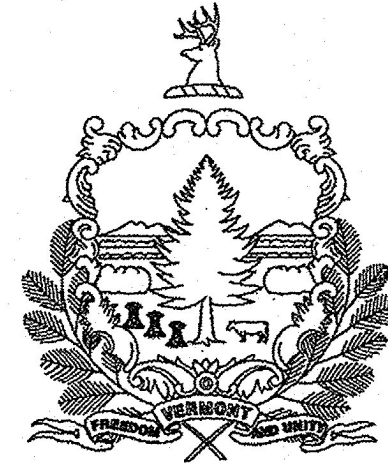


PROPOSED IMPROVEMENT BRIDGE PROJECT CITY OF RUTLAND COUNTY OF RUTLAND

RECORD PLANS	
CONTRACTOR:	KUBRICKY CONSTRUCTION CORP.- WILTON, NY
RESIDENT ENGINEER:	TIM POCKETTE
CONSTRUCTION BEGAN:	NOVEMBER 17, 2014
CONSTRUCTION COMPLETE:	JUNE 19, 2017
RECORD PLANS BY:	TIM POCKETTE & JESSE IVES
I HEREBY CERTIFY THAT ALL THE CONSTRUCTION REQUIRED BY THIS SET OF DRAWINGS HAS BEEN ACCOMPLISHED AS INDICATED HEREIN.	
BY	RESIDENT ENGINEER
DATE <u>APRIL 5, 2018</u>	
NOTE: Any further information concerning final quantities, amounts or other details relative to this project may be found by contacting Vtrans Records Management.	


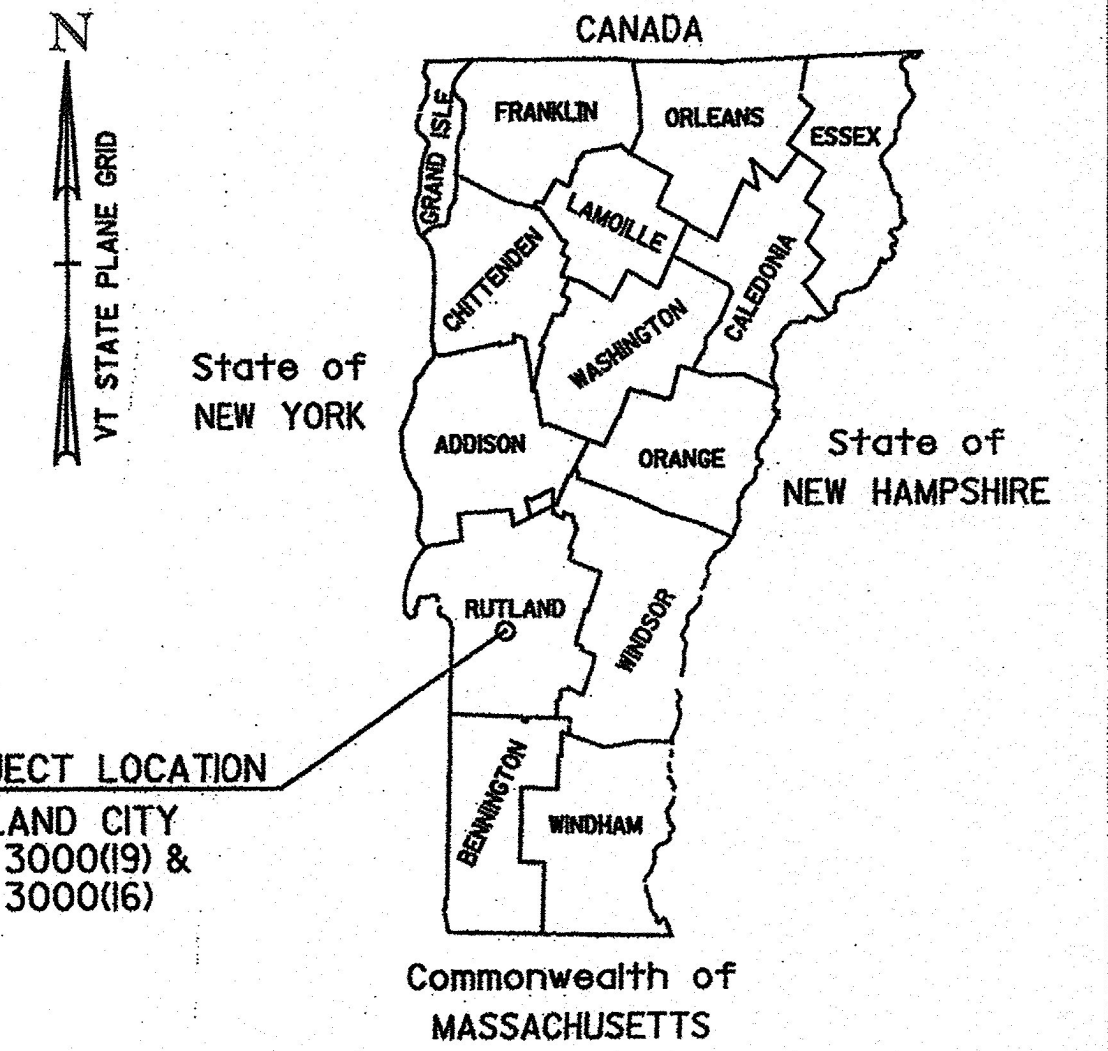


**RUTLAND CITY
BRF 3000(19)
SEE SHEET 18
FOR ADDITIONAL PROJECT INFORMATION
AND THE SUPERPAVE DESIGN CRITERIA**

**RUTLAND CITY
BRF 3000(16)
SEE SHEET 122
FOR ADDITIONAL PROJECT INFORMATION
AND THE SUPERPAVE DESIGN CRITERIA**

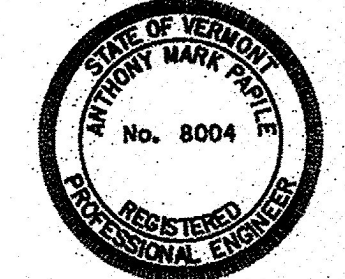

PLANS PREPARED BY

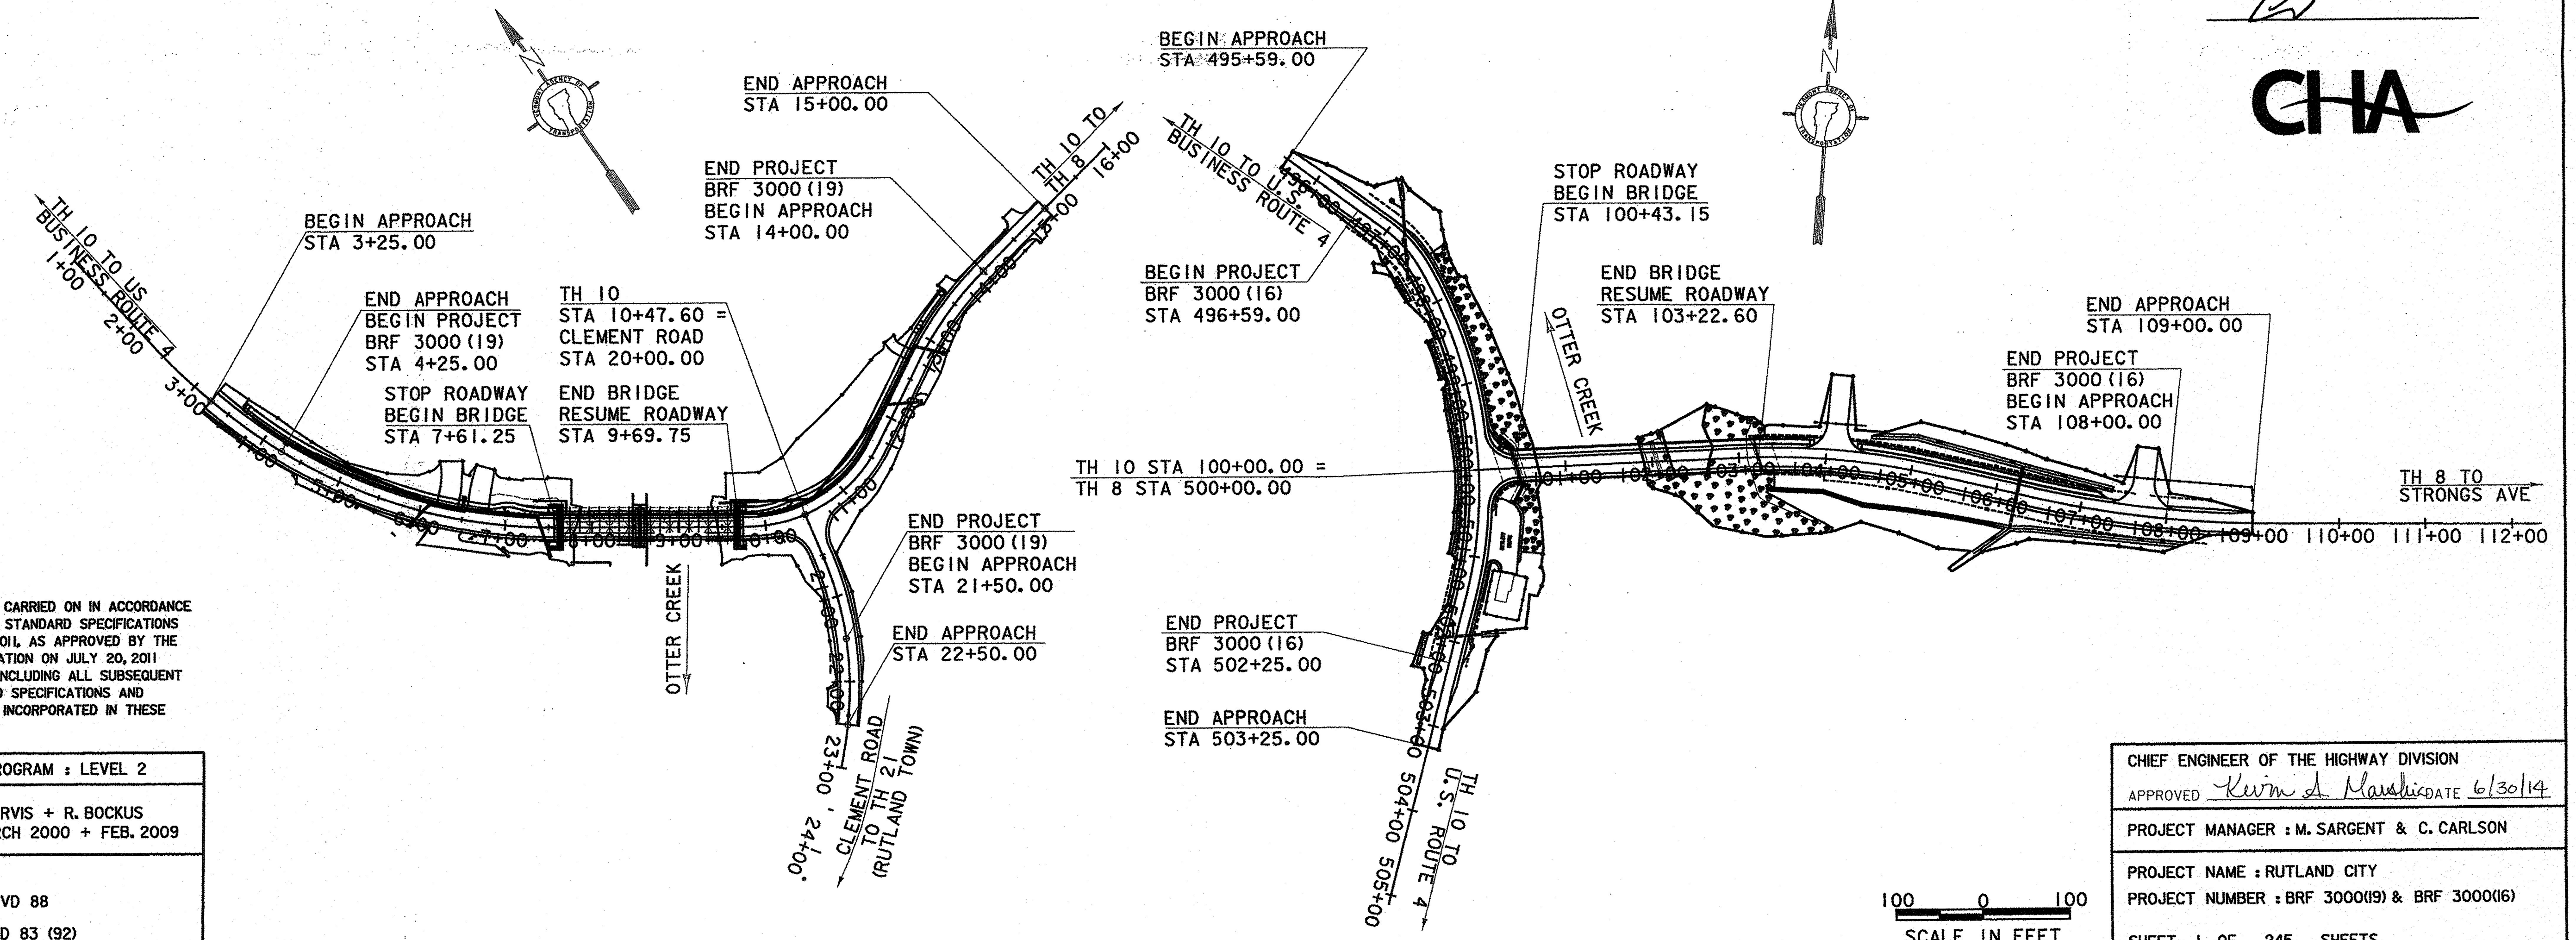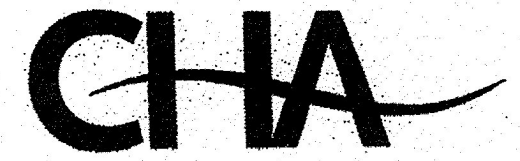

CONSTRUCTION IS TO BE CARRIED ON IN ACCORDANCE WITH THESE PLANS AND THE STANDARD SPECIFICATIONS FOR CONSTRUCTION DATED 2011, AS APPROVED BY THE FEDERAL HIGHWAY ADMINISTRATION ON JULY 20, 2011 FOR USE ON THIS PROJECT, INCLUDING ALL SUBSEQUENT REVISIONS AND SUCH REVISED SPECIFICATIONS AND SPECIAL PROVISIONS AS ARE INCORPORATED IN THESE PLANS.

QUALITY ASSURANCE PROGRAM : LEVEL 2	
SURVEYED BY :	L. ORVIS + R. BOCKUS
SURVEYED DATE :	MARCH 2000 + FEB. 2009
DATUM	
VERTICAL	NAVD 88
HORIZONTAL	NAD 83 (92)

CHIEF ENGINEER OF THE HIGHWAY DIVISION	
APPROVED	DATE 6/30/14
PROJECT MANAGER : M. SARGENT & C. CARLSON	
PROJECT NAME : RUTLAND CITY	
PROJECT NUMBER : BRF 3000(19) & BRF 3000(16)	
SHEET 1 OF 245 SHEETS	



FILE NAME = W:\P\0\8625\ANY\K2\26615\CADD\VTIN\08\085\consult\conts\08_085\comp\11.dwg
DATE/TIME = 6/26/2014
USER = 4916