


FILE NAME = V:\P\c\projects\ANY\K2\2015\CADD\MSTN\08\096\ecmsul\anta\z08\096p01.dgn  
 DATE/TIME = 6/30/2014  
 USER = 4916

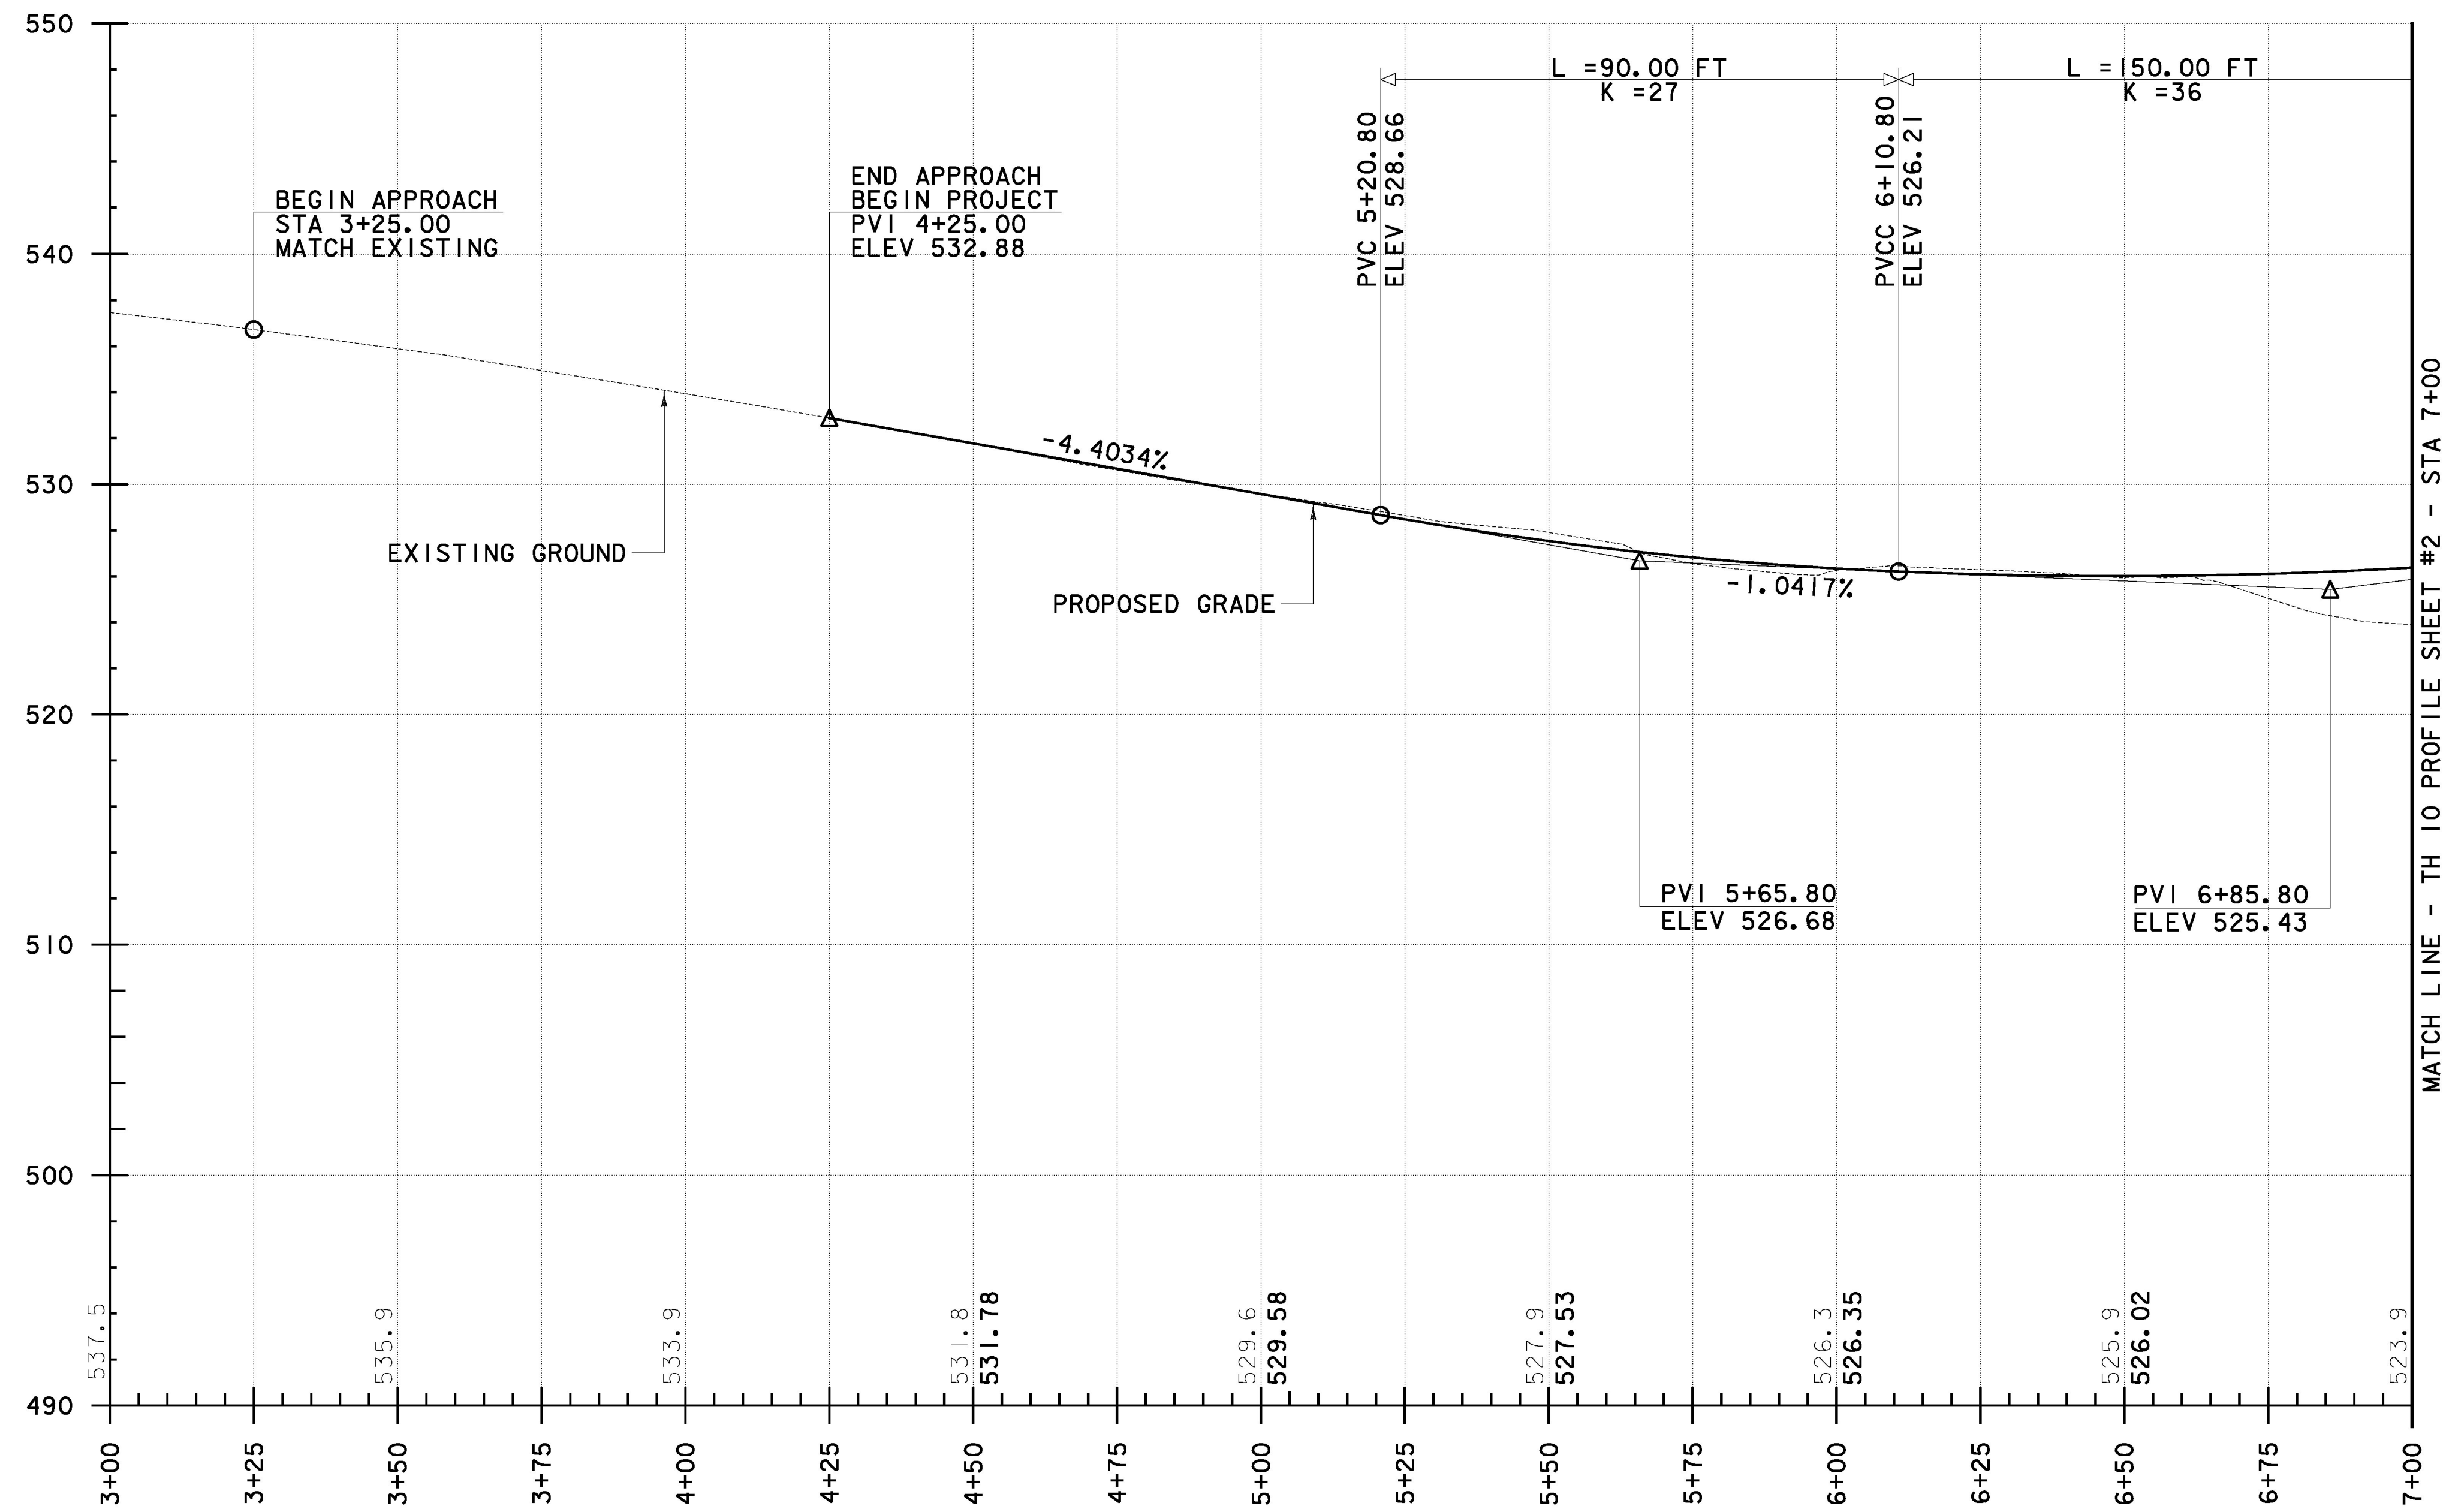

**PROFILE - TH 10**

SCALE IN FEET:  
 1" = 20' HORIZONTAL  
 1" = 5' VERTICAL

**NOTE:**

- THE GRADES SHOWN TO THE NEAREST TENTH ARE THE EXISTING GROUND ELEVATIONS ALONG CENTERLINE. THE GRADES SHOWN TO THE NEAREST HUNDREDTH ARE THE PROPOSED GRADES ALONG CENTERLINE.



**TH 10  
 PROFILE  
 SHEET #1**

PROJECT NAME: RUTLAND CITY  
 PROJECT NUMBER: BRF 3000 (I9)

PROJECT LEADER: M.D.S.  
 DESIGNED BY: C.R.H.  
 DWG. NO.: PRO-I

PLOT DATE: 6/30/2014  
 DRAWN BY: C.R.H.  
 CHECKED BY: D.E.G.  
 SHEET 37 OF 245

MATCH LINE - TH 10 PROFILE SHEET #2 - STA 7+00