

646.406 DURABLE 4 INCH WHITE LINE, RECESSED POLYUREA
 (ALL LINES WILL INCLUDE EDGE LINE BREAKS AND RADIUS FOR TOWN HIGHWAYS)
 CLEMENT ROAD:
 STA 21+00.00 - STA 22+50.00 EDGE LINE LT & RT

646.602 TEMPORARY 4 INCH WHITE LINE, PAINT
 (ALL LINES WILL INCLUDE EDGE LINE BREAKS AND RADIUS FOR TOWN HIGHWAYS)
 CLEMENT ROAD:
 STA 21+00.00 - STA 22+50.00 EDGE LINE LT & RT


646.416 DURABLE 4 INCH YELLOW LINE, RECESSED POLYUREA
 (ALL LINES WILL INCLUDE C/L BREAKS FOR TOWN HIGHWAYS) S=SOLID, D=DASHED
 CLEMENT ROAD: LT ☒ RT
 STA 21+00.00 - STA 22+50.00 S - S

646.612 TEMPORARY 4 INCH YELLOW LINE, PAINT
 (ALL LINES WILL INCLUDE C/L BREAKS FOR TOWN HIGHWAYS) S=SOLID, D=DASHED
 CLEMENT ROAD: LT ☒ RT
 STA 21+00.00 - STA 22+50.00 S - S

675.50 REMOVING SIGNS
 AS SHOWN - 1

FILE NAME = W:\P\c\areas\ANY\K2\2015\CADD\MSTN\08\096\ecmsul\anta\208\096bdr\spodgn
 DATE/TIME = 6/30/2014
 USER = 4916

SIGN LEGEND
 R = REMOVE
 S = SALVAGE
 N = NEW
 RET = RETAIN
 B-B = BACK TO BACK
 EXISTING = _____
 NEW = _____

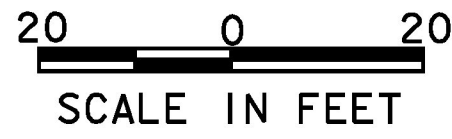

SIGNING & STRIPING PLAN SHEET #4	PROJECT NAME: RUTLAND CITY	PLOT DATE: 6/30/2014
	PROJECT NUMBER: BRF 3000 (I9)	DRAWN BY: C.R.H.
	PROJECT LEADER: M.D.S.	CHECKED BY: D.E.G.
	DESIGNED BY: C.R.H.	SHEET 50 OF 245
	DWG. NO.: SSP-4	