



31+75

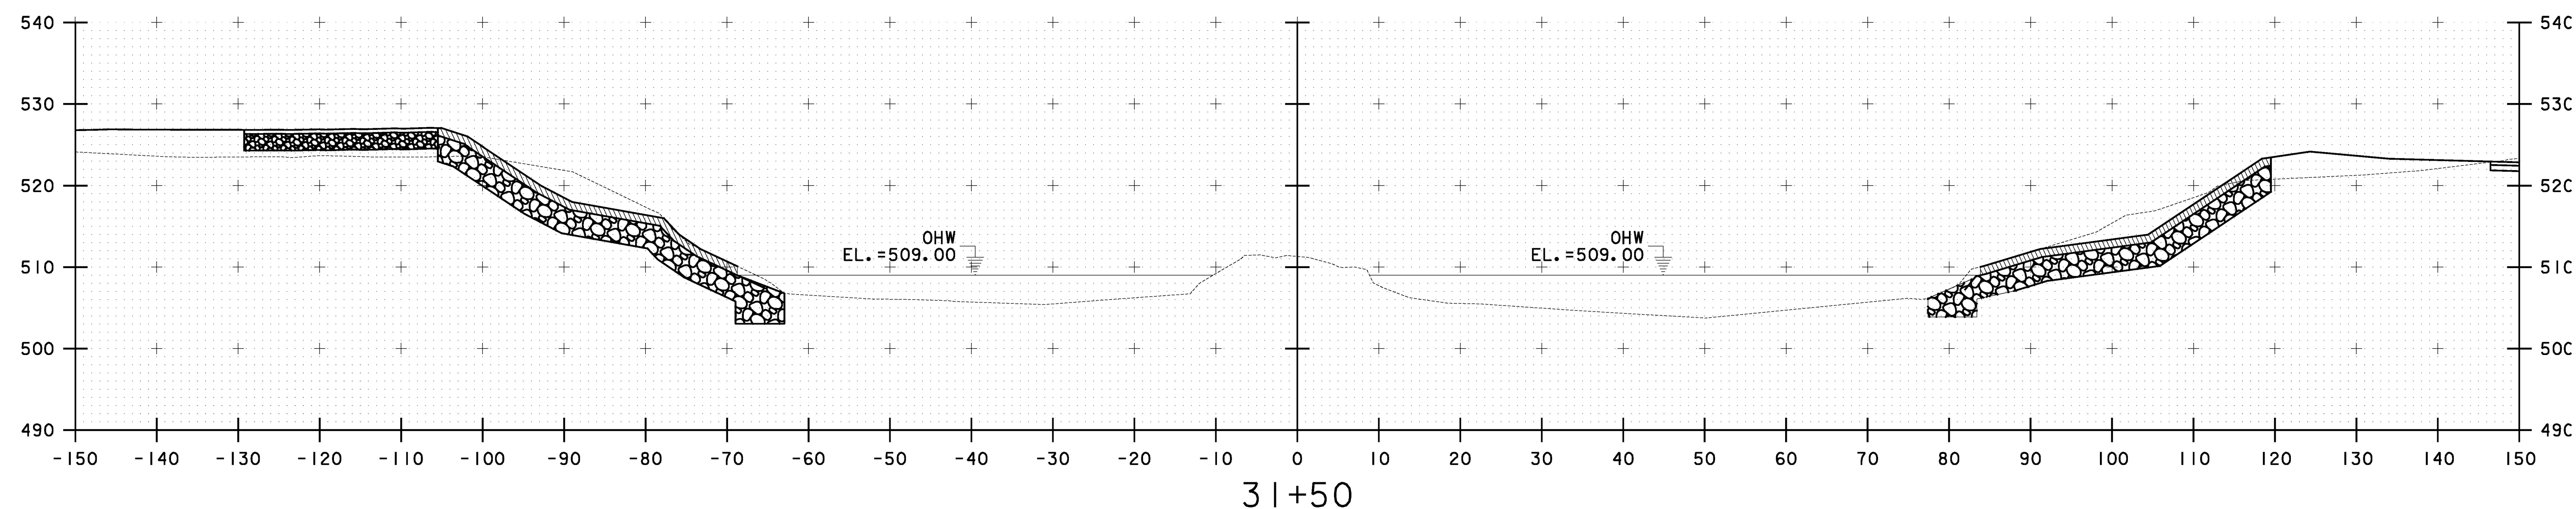

31+50

FILE NAME = W:\Projects\BRF3000\19\31+50\31+50.dgn
 DATE/TIME = 6/30/2014 4:16
 USER =

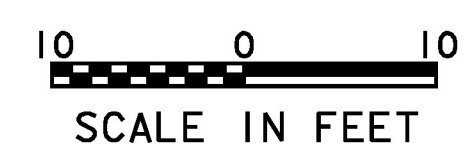

SCALE IN FEET



STA. 31+50 TO STA. 31+75

CHANNEL CROSS SECTIONS #3	PROJECT NAME: RUTLAND CITY	PLOT DATE: 6/30/2014
	PROJECT NUMBER: BRF 3000 (19)	DRAWN BY: D.M.D.
	PROJECT LEADER: M.D.S.	CHECKED BY: P.M.P.
	DESIGNED BY: D.M.D.	SHEET 93 OF 245
	DWG. NO.: CXS-3	