


3'-7" at sections AA or CC, 3'-9" at sections BB

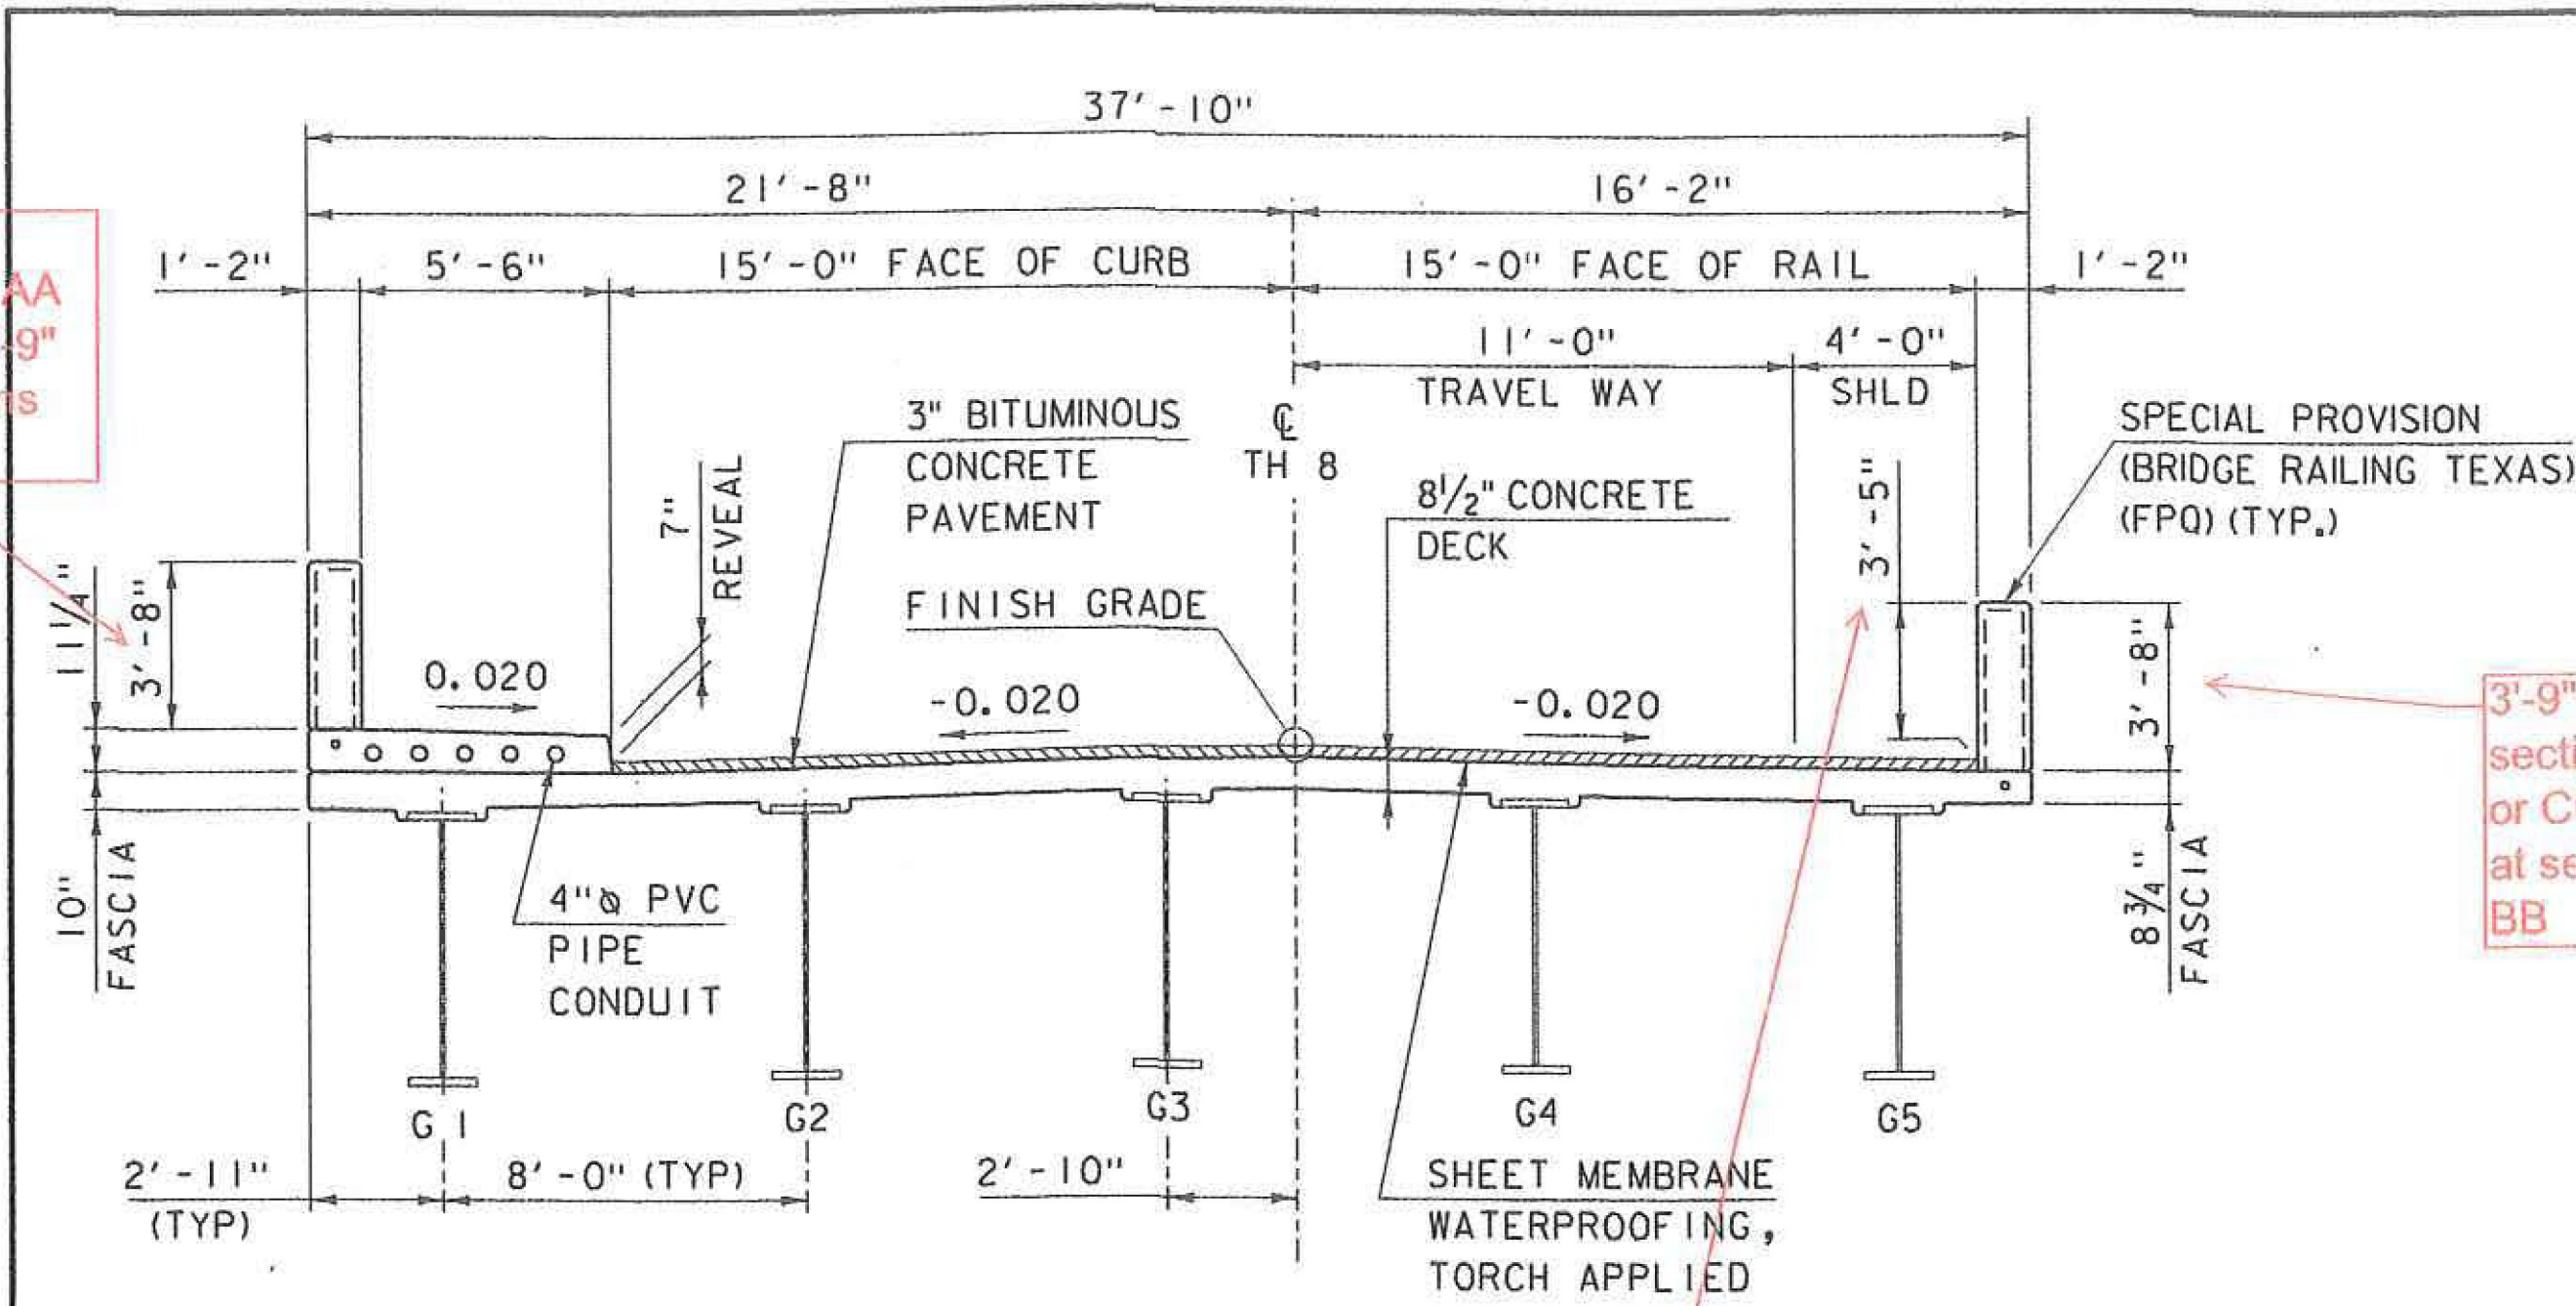


TH-8 BRIDGE TYPICAL SECTION


SCALE: 1/4" = 1'-0"

BITUMINOUS CONCRETE PAVEMENT ON BRIDGE  
 1 1/2" TYPE IV WEARING COURSE  
 1 1/2" TYPE IV BINDER COURSE


3'-6" at sections AA or CC, 3'-8" at sections BB

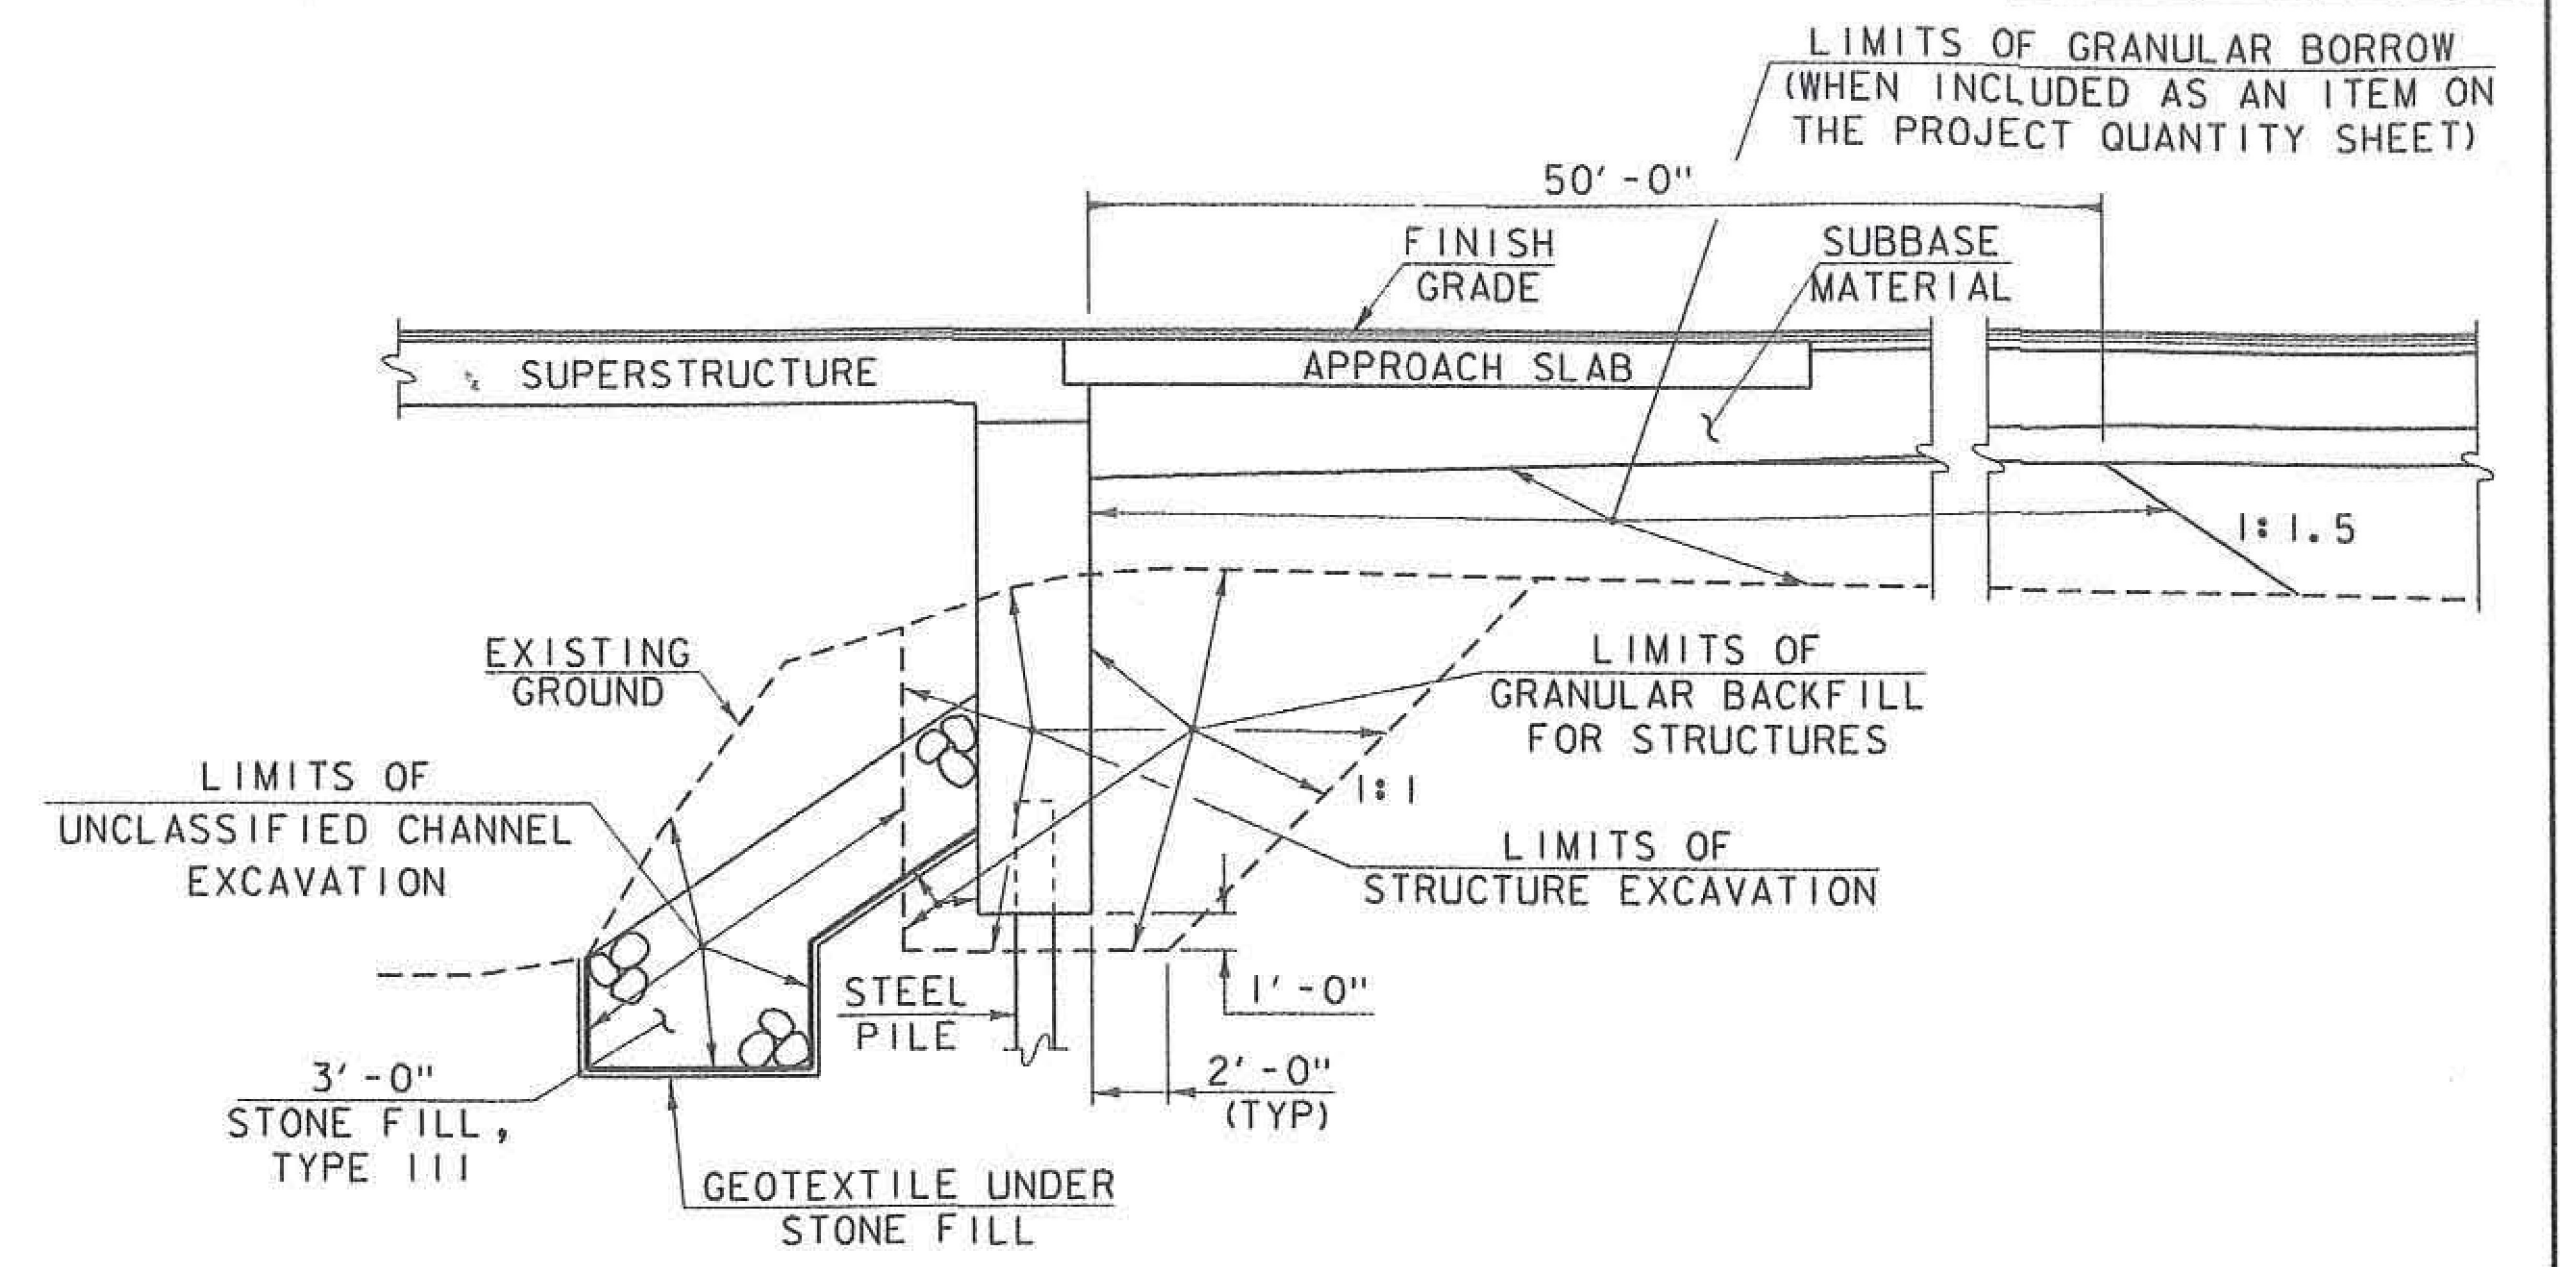

ABUTMENT 2 EARTHWORK TYPICAL SECTION (NOT TO SCALE)

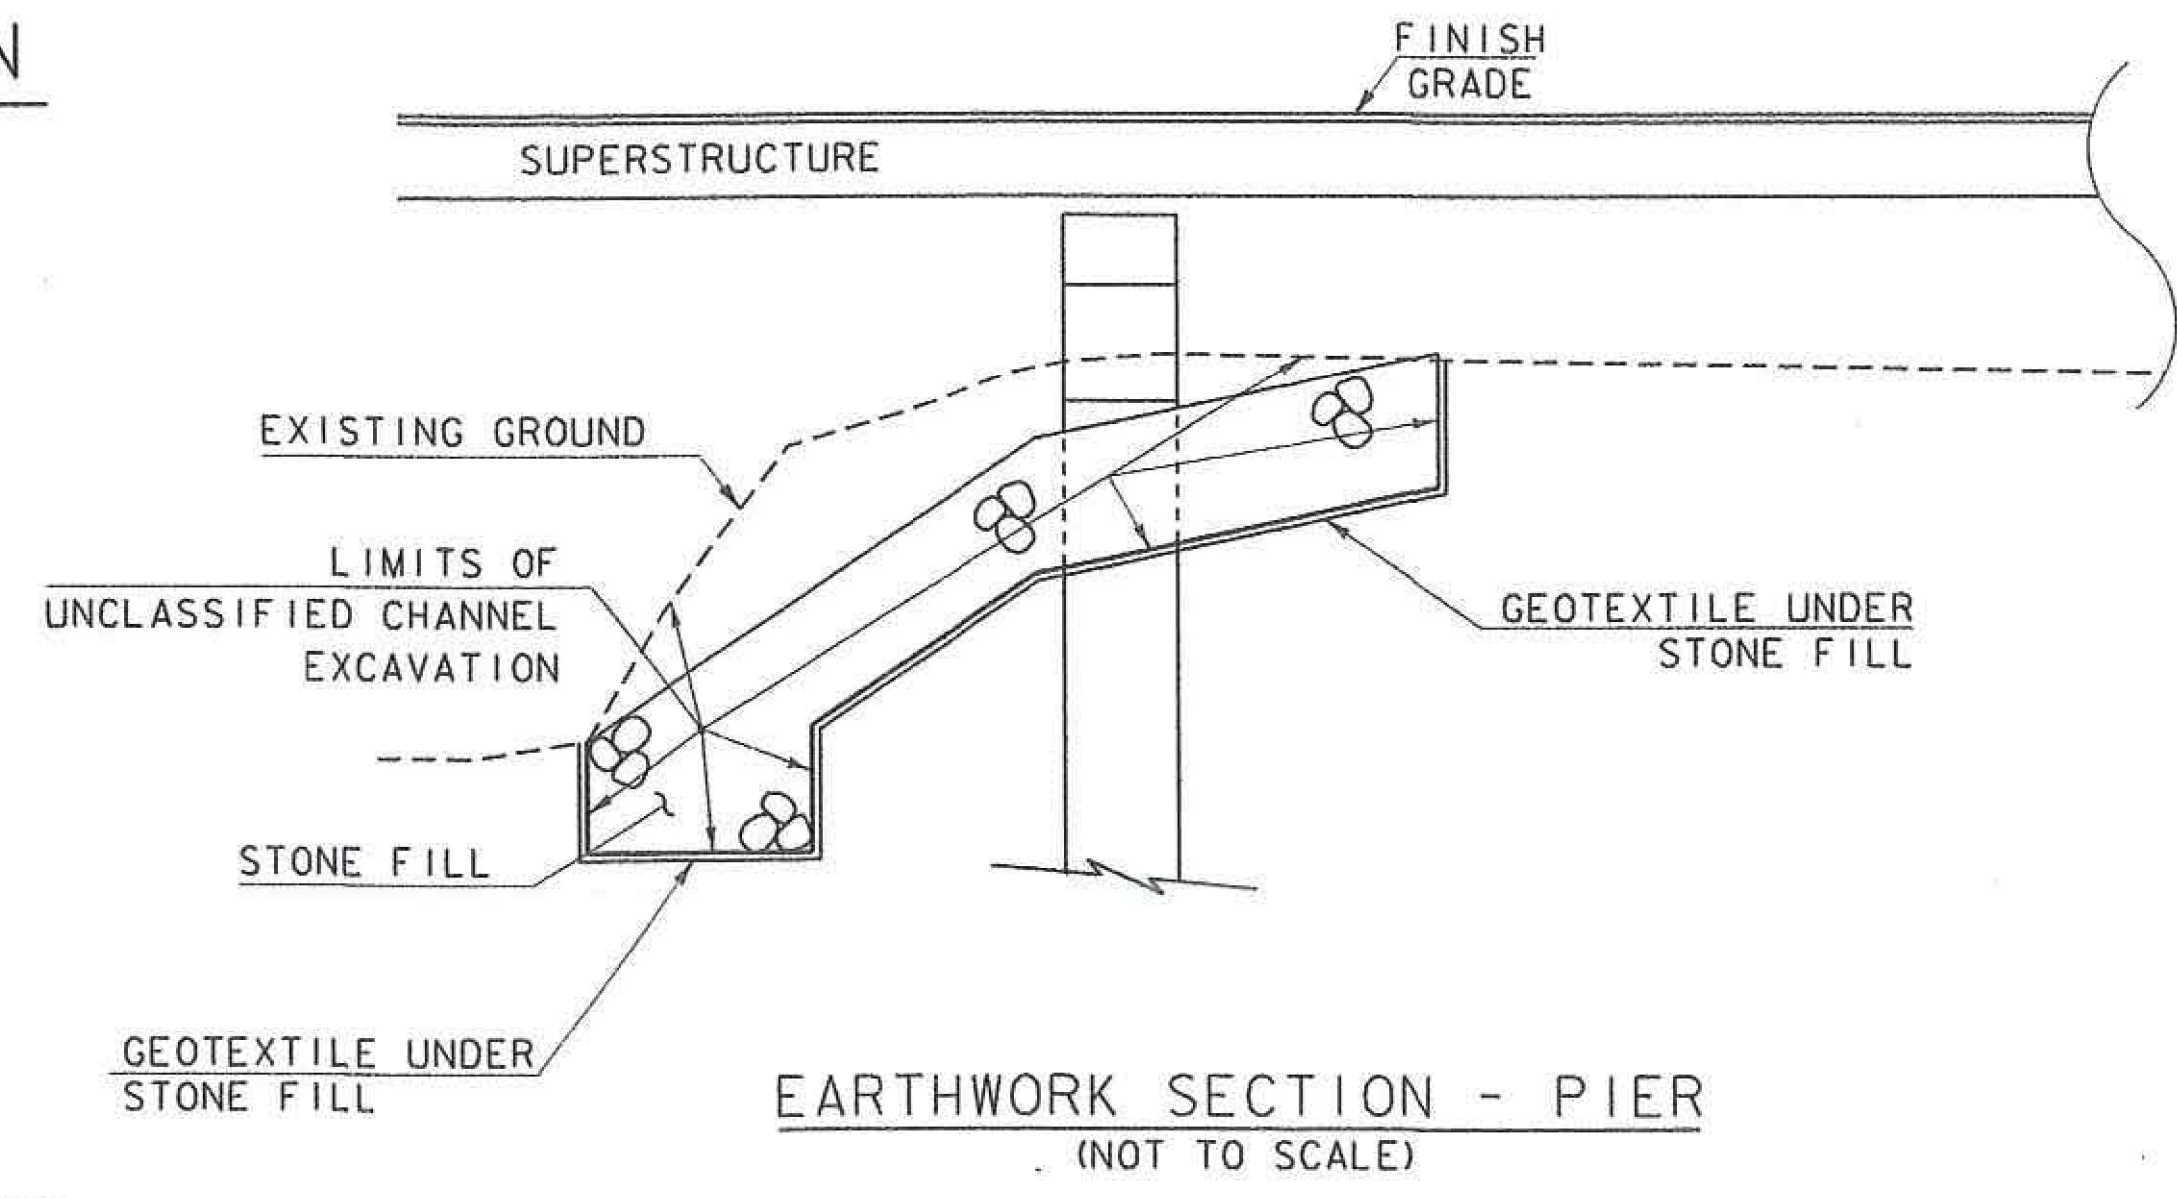


EARTHWORK SECTION - PIER (NOT TO SCALE)

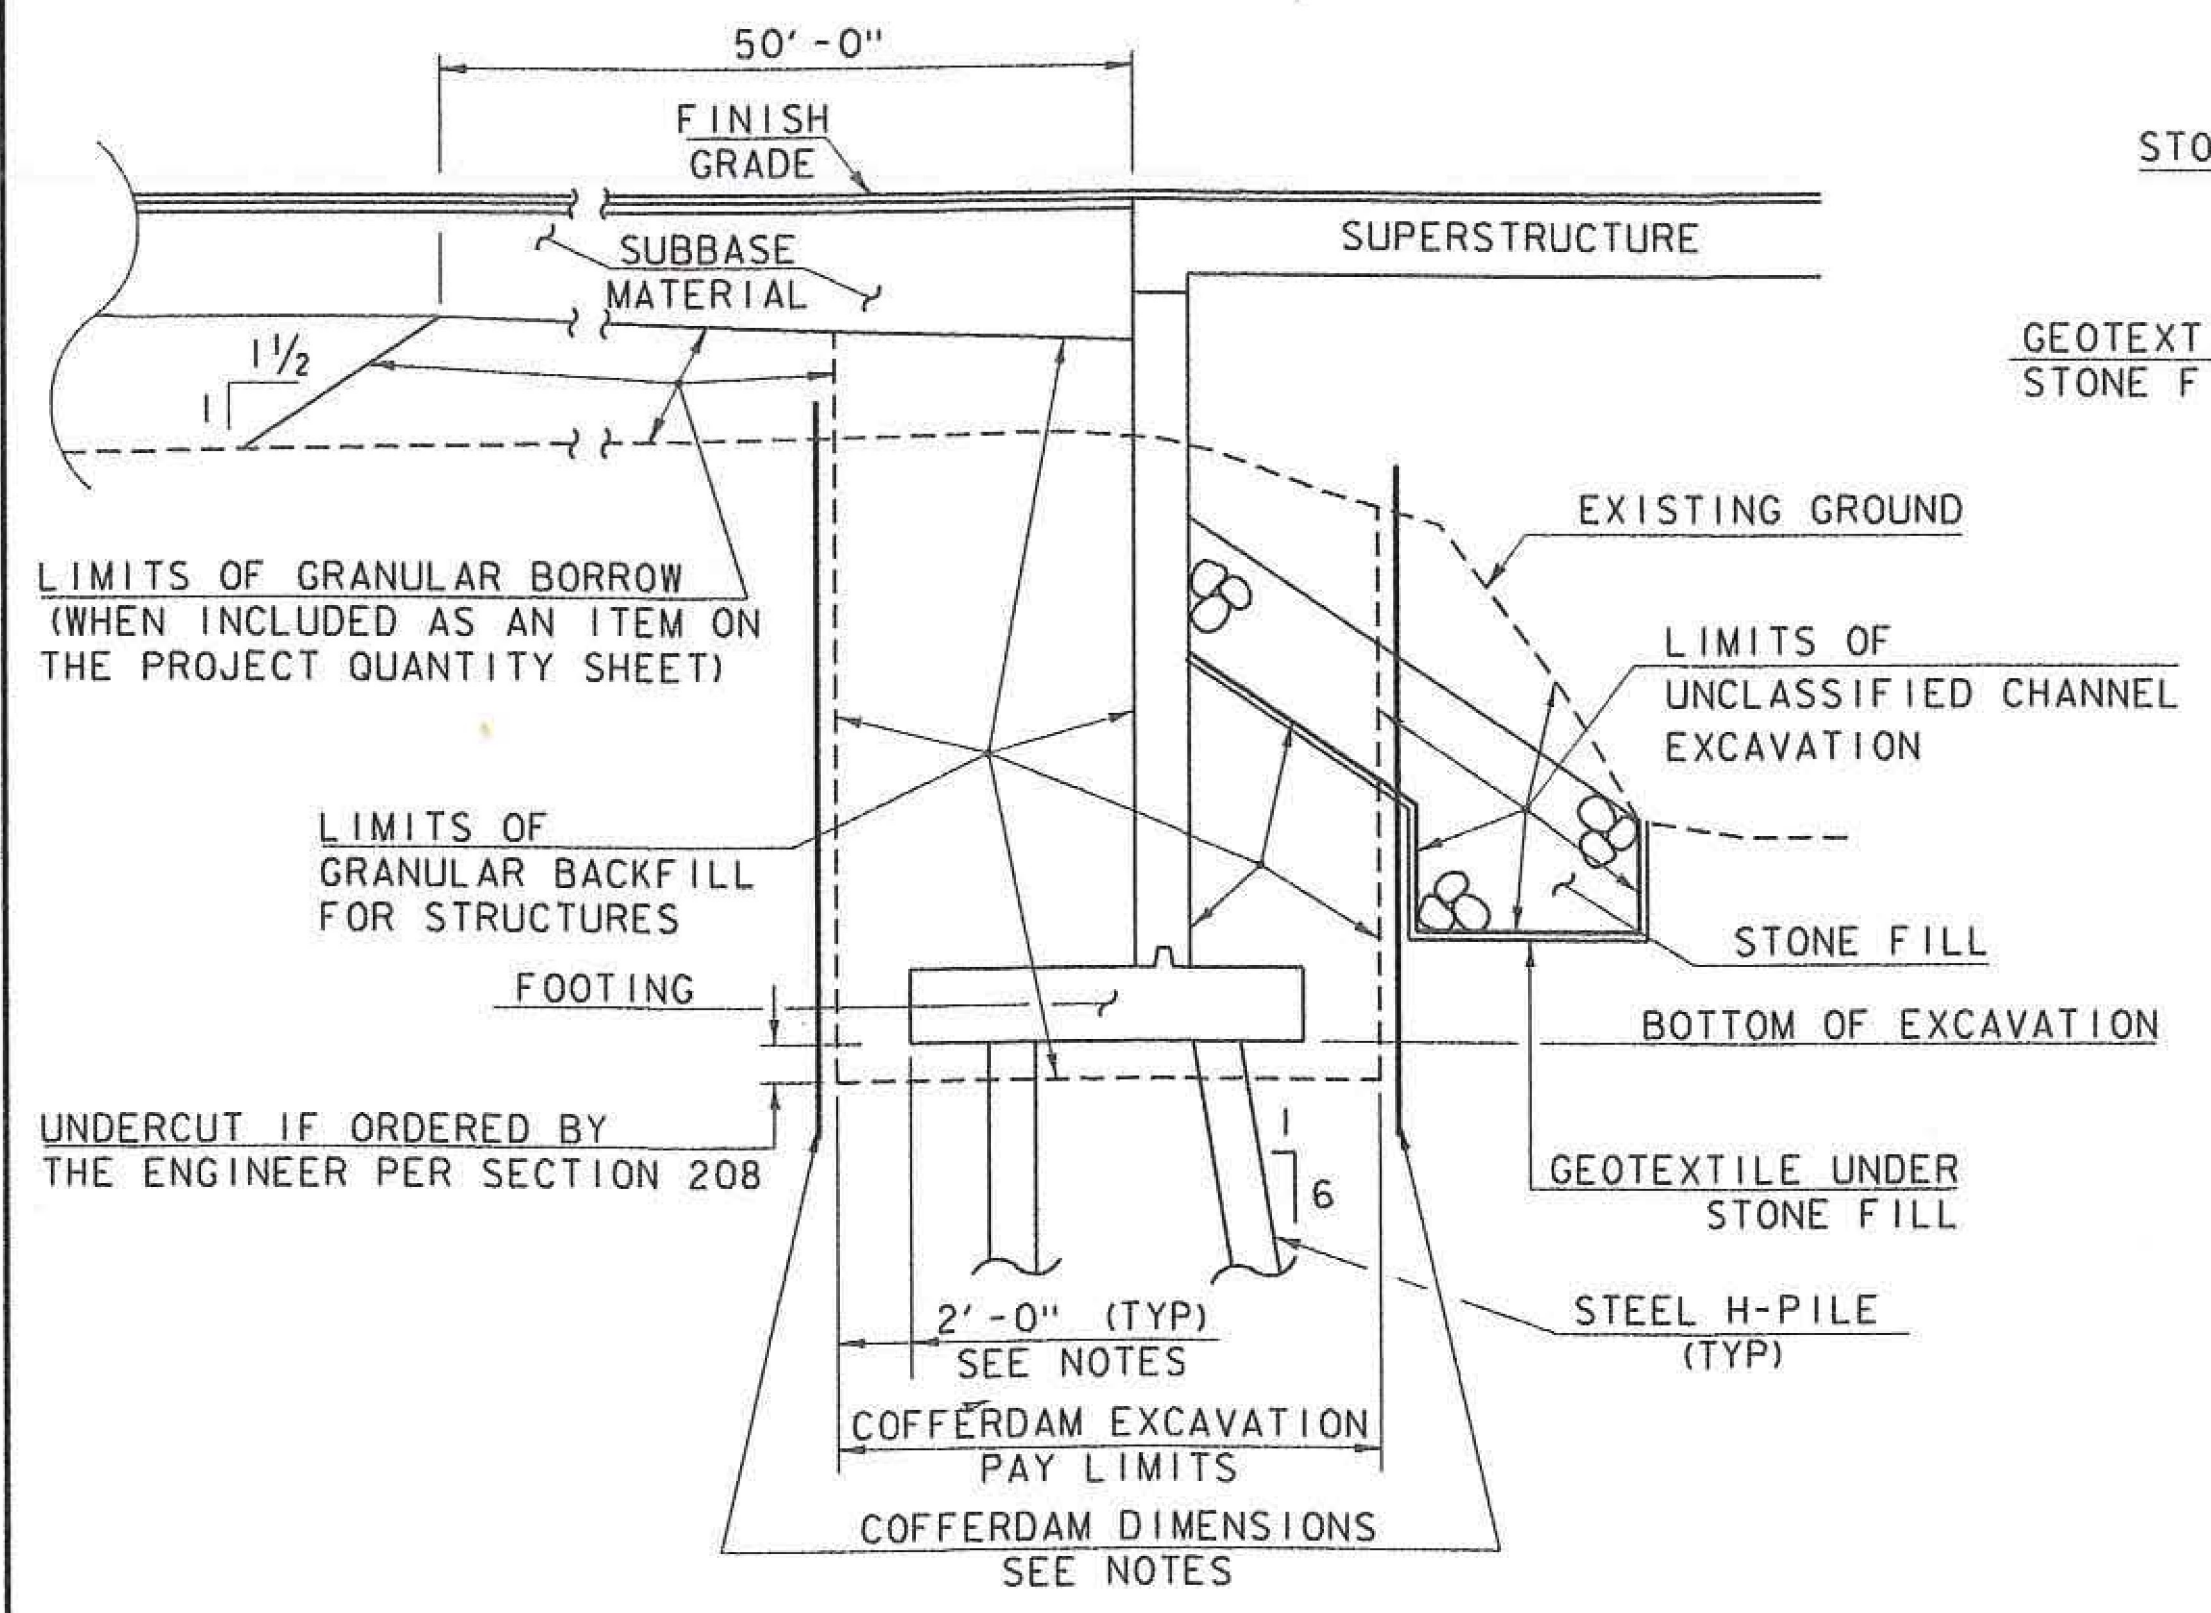

COFFERDAM AND EARTHWORK SECTION ABUTMENT #1 (NOT TO SCALE)

COFFERDAM NOTES

1. COFFERDAM DIMENSIONS TO BE DETERMINED BY THE CONTRACTOR.
2. THE PAY LIMITS OF "COFFERDAM EXCAVATION, EARTH" AND "COFFERDAM EXCAVATION, ROCK" SHALL BE 2'-0" OUTSIDE THE PERIMETER OF THE FOOTING AND FROM BOTTOM OF EXCAVATION UP TO THE EXISTING GROUND OR BOTTOM OF SUBBASE, WHICHEVER IS LOWER.
3. IF A COFFERDAM IS CONSTRUCTED WHICH IS LARGER THAN THE INDICATED COFFERDAM EXCAVATION PAY LIMITS, PAYMENT FOR ALL UNCLASSIFIED CHANNEL EXCAVATION, INCLUDING THAT PORTION WHICH IS INSIDE THE COFFERDAM BUT OUTSIDE THE COFFERDAM PAY LIMITS, WILL BE MADE AT THE CONTRACT UNIT PRICE FOR UNCLASSIFIED CHANNEL EXCAVATION. NO MEASUREMENT AND PAYMENT WILL BE MADE FOR COFFERDAM EXCAVATION AND GRANULAR BACKFILL FOR STRUCTURES OUTSIDE THE PAY LIMITS DEFINED IN NOTE 2.

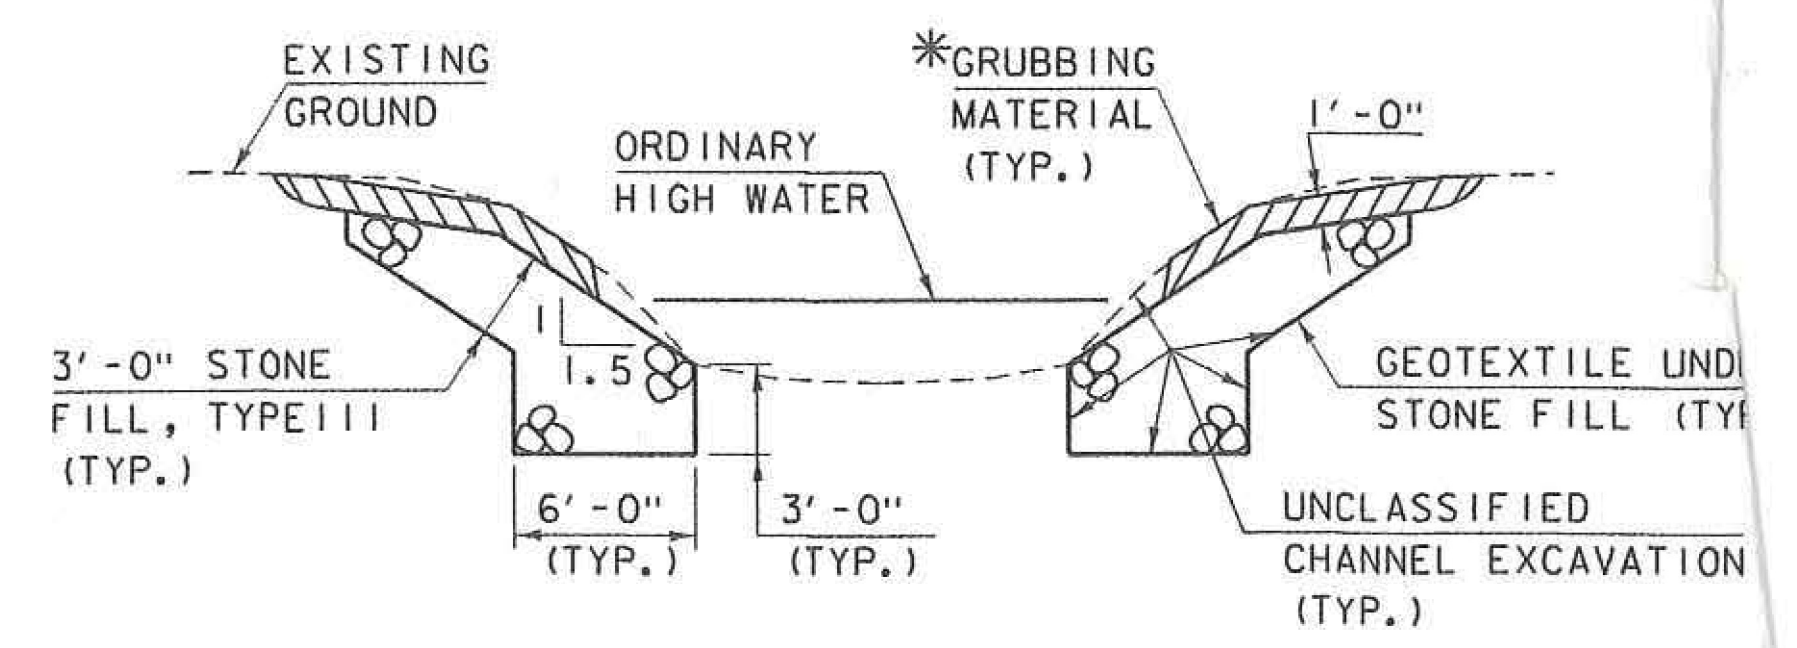

TYPICAL CHANNEL SECTION (NOT TO SCALE)

\*GRUBBING MATERIAL SHALL NOT BE PLACED ON THE STONE FILL IN THE AREA UNDER THE BRIDGE. WHENEVER CHANNEL SLOPE INTERSECTS ROADWAY SUBBASE, GRUBBING MATERIAL SHALL BEGIN AT THE BOTTOM OF SUBBASE.

PROJECT NAME:	RUTLAND CITY	PLOT DATE:	03-JUL-2014
PROJECT NUMBER:	BRF 3000 (16)	DRAWN BY:	M. LONGSTREET
FILE NAME:	s94j092+yp.dgn	CHECKED BY:	EVANS-MONGEON
PROJECT LEADER:	C. CARLSON	EARTHWORKS	SHEET 126A OF 245