

BOX BEAM GUARDRAIL  
STA. 497+23.41 TO 499+25 LT

CAST-IN-PLACE CONCRETE CURB, TYPE B  
STA. 497+65 TO 499+25 RT

STONE FILL, TYPE III  
STA. 497+50 TO 499+25 LT

GEOTEXTILE UNDER STONE FILL  
STA. 497+50 TO 499+25 LT

GRUBBING MATERIAL  
STA. 497+50 TO 499+25 LT

UNCLASSIFIED CHANNEL EXCAVATION  
STA. 497+50 TO 499+25 LT

DRY MASONRY  
STA. 497+20 TO 497+28 RT  
STA. 497+51 TO 497+85 RT  
STA. 498+40 TO 498+86 RT  
STA. 499+00 TO 499+25 RT

SPECIAL PROVISION (GATE FOR ORNAMENTAL FENCE, 4 FEET)  
STA. 497+29 TO 497+50 RT

CONSTRUCT PAVED DRIVE  
STA. 497+23 TO 497+57 RT

RELOCATE MAILBOX, SINGLE SUPPORT  
STA 496+76 LT

DECIDUOUS TREES

(2) STA 498+58 RT  
(1) STA 499+02 RT  
(1) STA 499+09 RT

(1) TH 10 STA. 496+94 LT TO 497+62 RT  
NEW 18" X 90" CAAP, PCCSP OR CPEP  
W/ STONE FILL TYPE I AT OUTLET  
DI AT INLET

MATCHLINE STA 499+25 (LAYOUT 3)

GMP #37SP  
W/ 30' ANCHOR

6" WATER (-C+)  
499+00

8" SEWER (ABS)  
499+00

STONE FILL, TYPE III

PILTH 10 CURVE (1)  
STA 499+04.23 AH  
STA 498+38.01 BK

TH 10 CURVE (1)  
Δ = 68°27'08" RT  
D = 38°11'50" (1) D = 11°27'33" (2)  
R = 150.00' (1) R = 500.00' (2)  
T = 208.32' (1) T = 306.78' (2)  
L = 63.63' (1) L = 385.25' (2)  
E = 106.71'

STA 496+59.00  
BEGIN PROJECT

STA 495+59.00  
BEGIN APPROACH

PC  
STA 496+95.91

PCC  
STA 497+59.57

PAVED DRIVE

PAVED DRIVE



PAVED DRIVE

PAVED DRIVE

PAVED DRIVE

PAVED DRIVE

OTTER CREEK

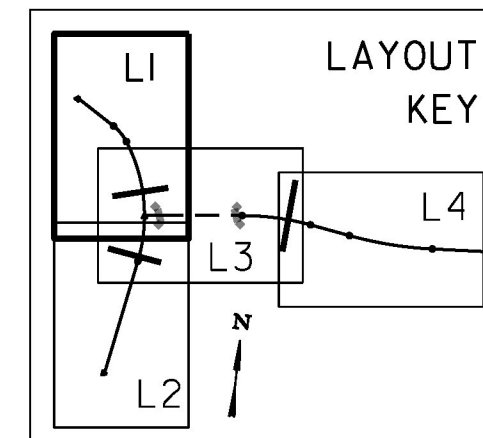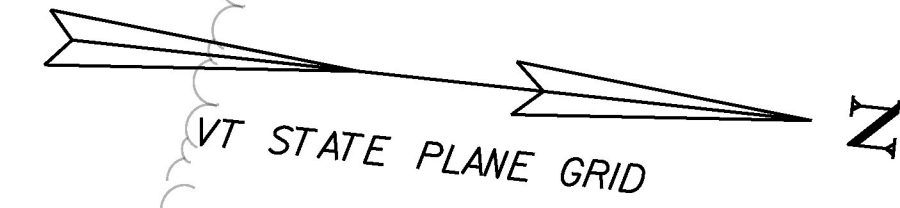

PROJECT NAME: RUTLAND CITY	PLOT DATE: 14-JUL-2014
PROJECT NUMBER: BRF 3000 (16)	DRAWN BY: M. LONGSTREET
FILE NAME: s94j092bdr.dgn	CHECKED BY: EVANS-MONGEON
DESIGNED BY: EVANS-MONGEON	LAYOUT SHEET 1
	SHEET 133 OF 245

