



WIRED CONDUIT (2")
 STA. 501+64 RT TO 501+41 LT (POWER)
 STA. 501+64 RT TO 501+41 LT (TELEPHONE)

POWER DROP STANCHION, STREET LIGHTING
 STA. 501+64 RT

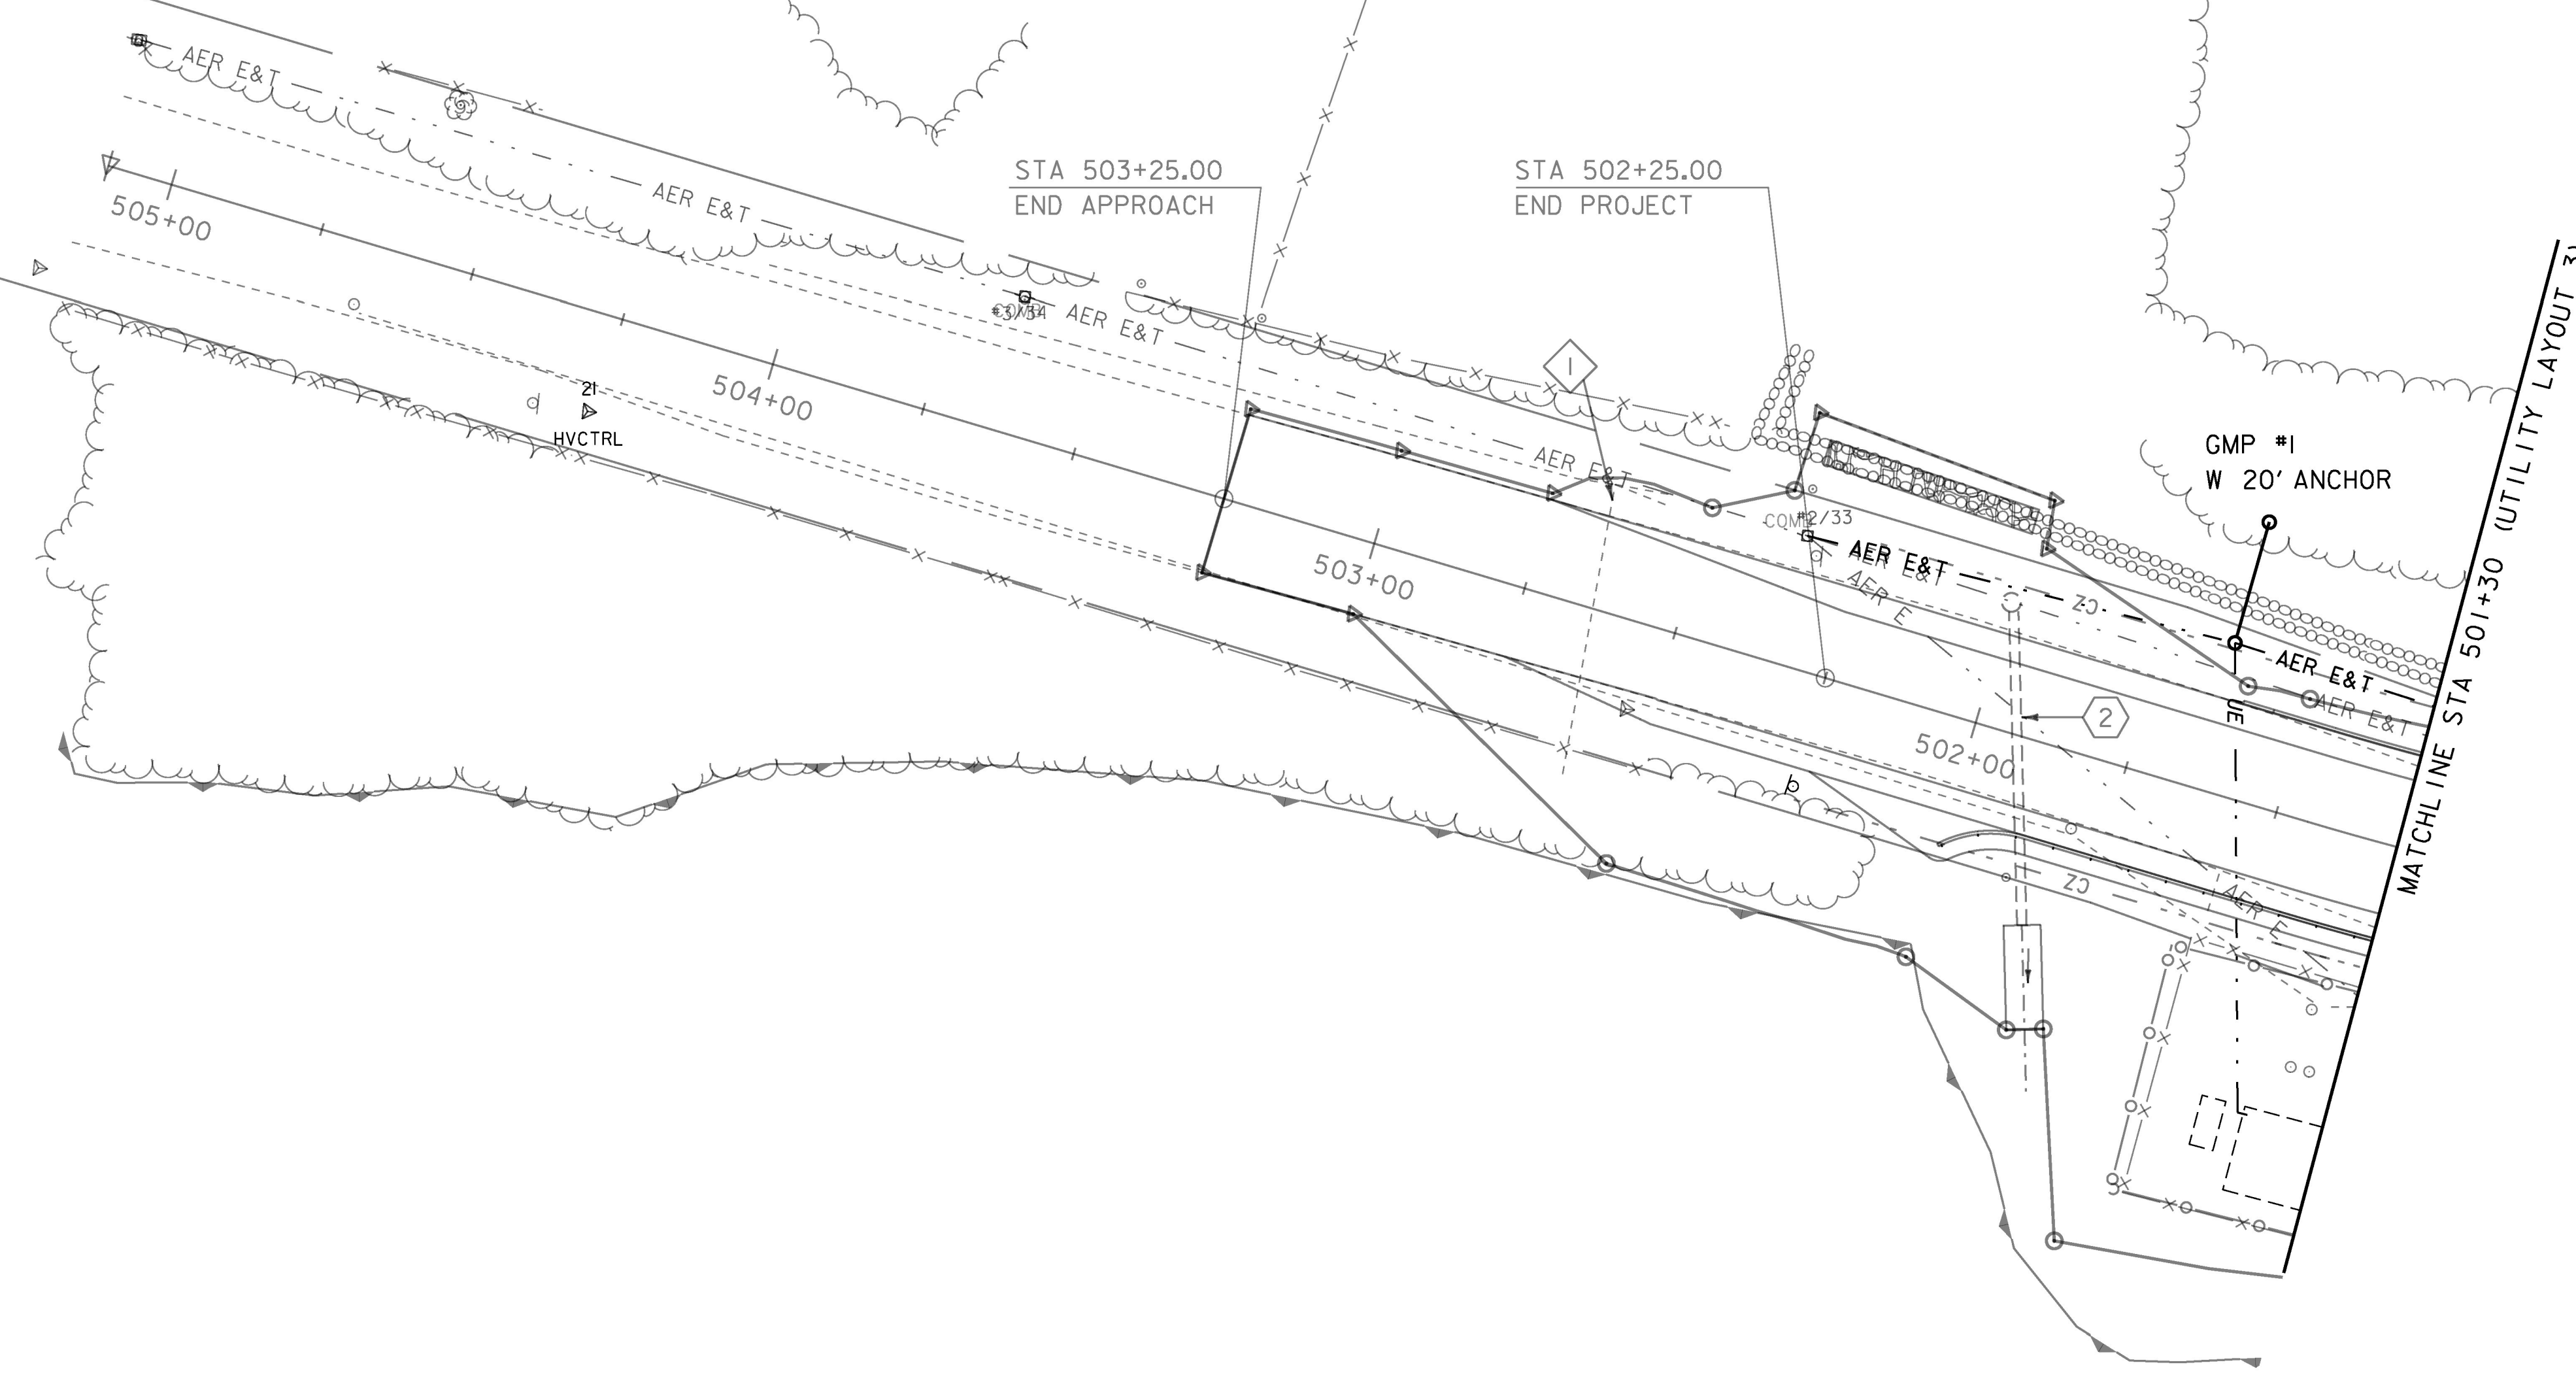

CLASS II
 WETLANDS

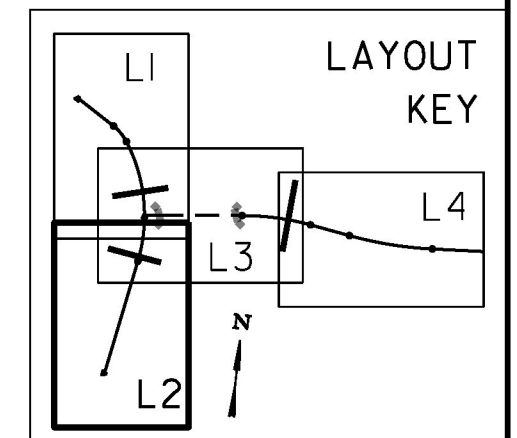

PROJECT NAME:	RUTLAND CITY	PLOT DATE:	03-JUL-2014
PROJECT NUMBER:	BRF 3000 (16)	DRAWN BY:	M. LONGSTREET
FILE NAME:	s94j092u1bdr.dgn	DESIGNED BY:	EVANS-MONGEON
PROJECT LEADER:	C. CARLSON	CHECKED BY:	EVANS-MONGEON
UTILITY LAYOUT 2		SHEET	142 OF 245