

TH 8 CURVE (1)
 $\Delta = 15^\circ 26' 29''$ RT
 $D = 07^\circ 09' 43''$
 $R = 800.00'$
 $T = 108.46'$
 $L = 215.60'$
 $E = 7.32'$

CONSTRUCT SIDEWALK
 RAMP TYPE I
 STA 103+85 LT
 STA 104+35 LT

GMP #36
 W/ 25' ANCHOR

STA 103+22.60
 END BRIDGE

CONSTRUCT SIDEWALK
 RAMP TYPE I
 STA 100+22.75 LT

STA 100+43.15
 BEGIN BRIDGE


RELOCATED ϕ TH 8 (RIVER STR.)

101+00 N 83°46'41" E 102+00

EXISTING ϕ TH 8 (RIVER STR.)

B.M. #2900
 VT DISK IN BRIDGE CURB
 EL = 533.6905

GRASS SWALE 3
 FOR STORMWATER
 TREATMENT

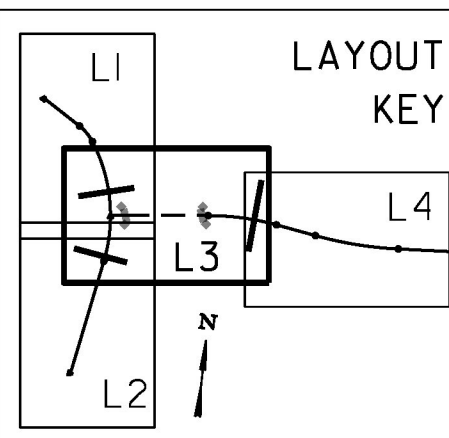

PROJECT NAME:	RUTLAND CITY	PLOT DATE:	03-JUL-2014
PROJECT NUMBER:	BRF 3000 (16)	DRAWN BY:	M. LONGSTREET
FILE NAME:	s94j092u+1bdr.dgn	CHECKED BY:	EVANS-MONGEON
PROJECT LEADER:	C. CARLSON	DESIGNED BY:	EVANS-MONGEON
UTILITY LAYOUT 3		SHEET	143 OF 245