

MATCHLINE STA 104+50 (UTILITY LAYOUT 3)

GRASS SWALE 4 FOR STORMWATER TREATMENT

CONSTRUCT SIDEWALK RAMP TYPE I STA 107+34 LT

STA 109+00.00 END APPROACH

STA 108+00.00 END PROJECT


N 86°40'20" E Q TH 8 (RIVER STR)

GRASS SWALE 3 FOR STORMWATER TREATMENT

GMP #34 W/ 25' ANCHOR

GRASS SWALE 5 FOR STORMWATER TREATMENT

TH 8 CURVE (2)
 $\Delta = 12^\circ 32' 50''$ LT
 $D = 04^\circ 46' 29''$
 $R = 1200.00'$
 $T_1 = 131.92'$
 $L = 262.79'$
 $E = 7.23'$

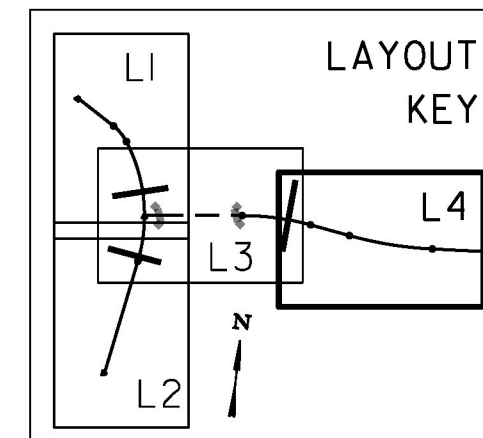

PROJECT NAME:	RUTLAND CITY	PLOT DATE:	03-JUL-2014
PROJECT NUMBER:	BRF 3000 (16)	DRAWN BY:	M. LONGSTREET
FILE NAME:	s94j092u1bdr.dgn	CHECKED BY:	EVANS-MONGEON
DESIGNED BY:	EVANS-MONGEON	UTILITY LAYOUT 4	SHEET 144 OF 245

