
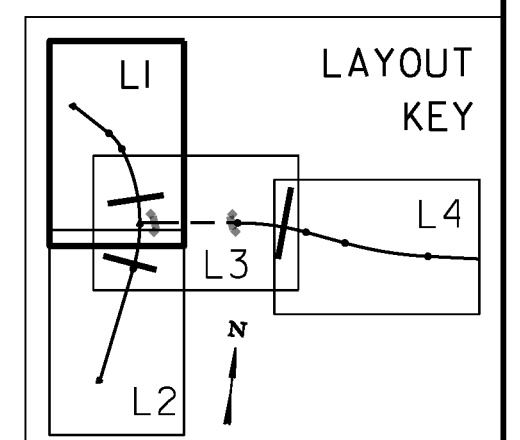
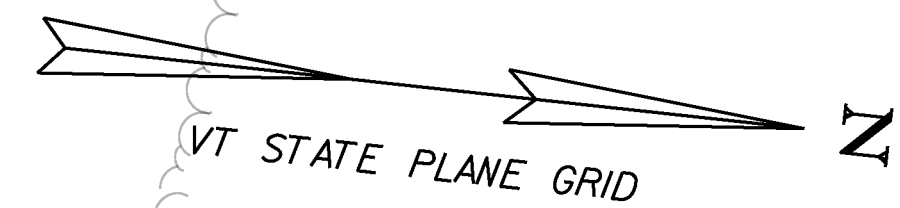


DURABLE 4" YELLOW LINE,
 RECESSED POLYUREA (DOUBLE CL) (TH 10)
 STA 495+59.00 - STA 499+25.00

DURABLE 4" WHITE LINE,
 RECESSED POLYUREA (TH 10)
 STA 495+59.00 - STA 499+25.00 LT
 STA 495+59.00 - STA 499+25.00 RT

REMOVING SIGNS
 STA 499+00.00 LT
 STA 499+25.00 LT

TRAFFIC SIGNS, TYPE A
 STA 495+55.00 RT
 STA 498+00.00 LT
 STA 499+00.00 LT

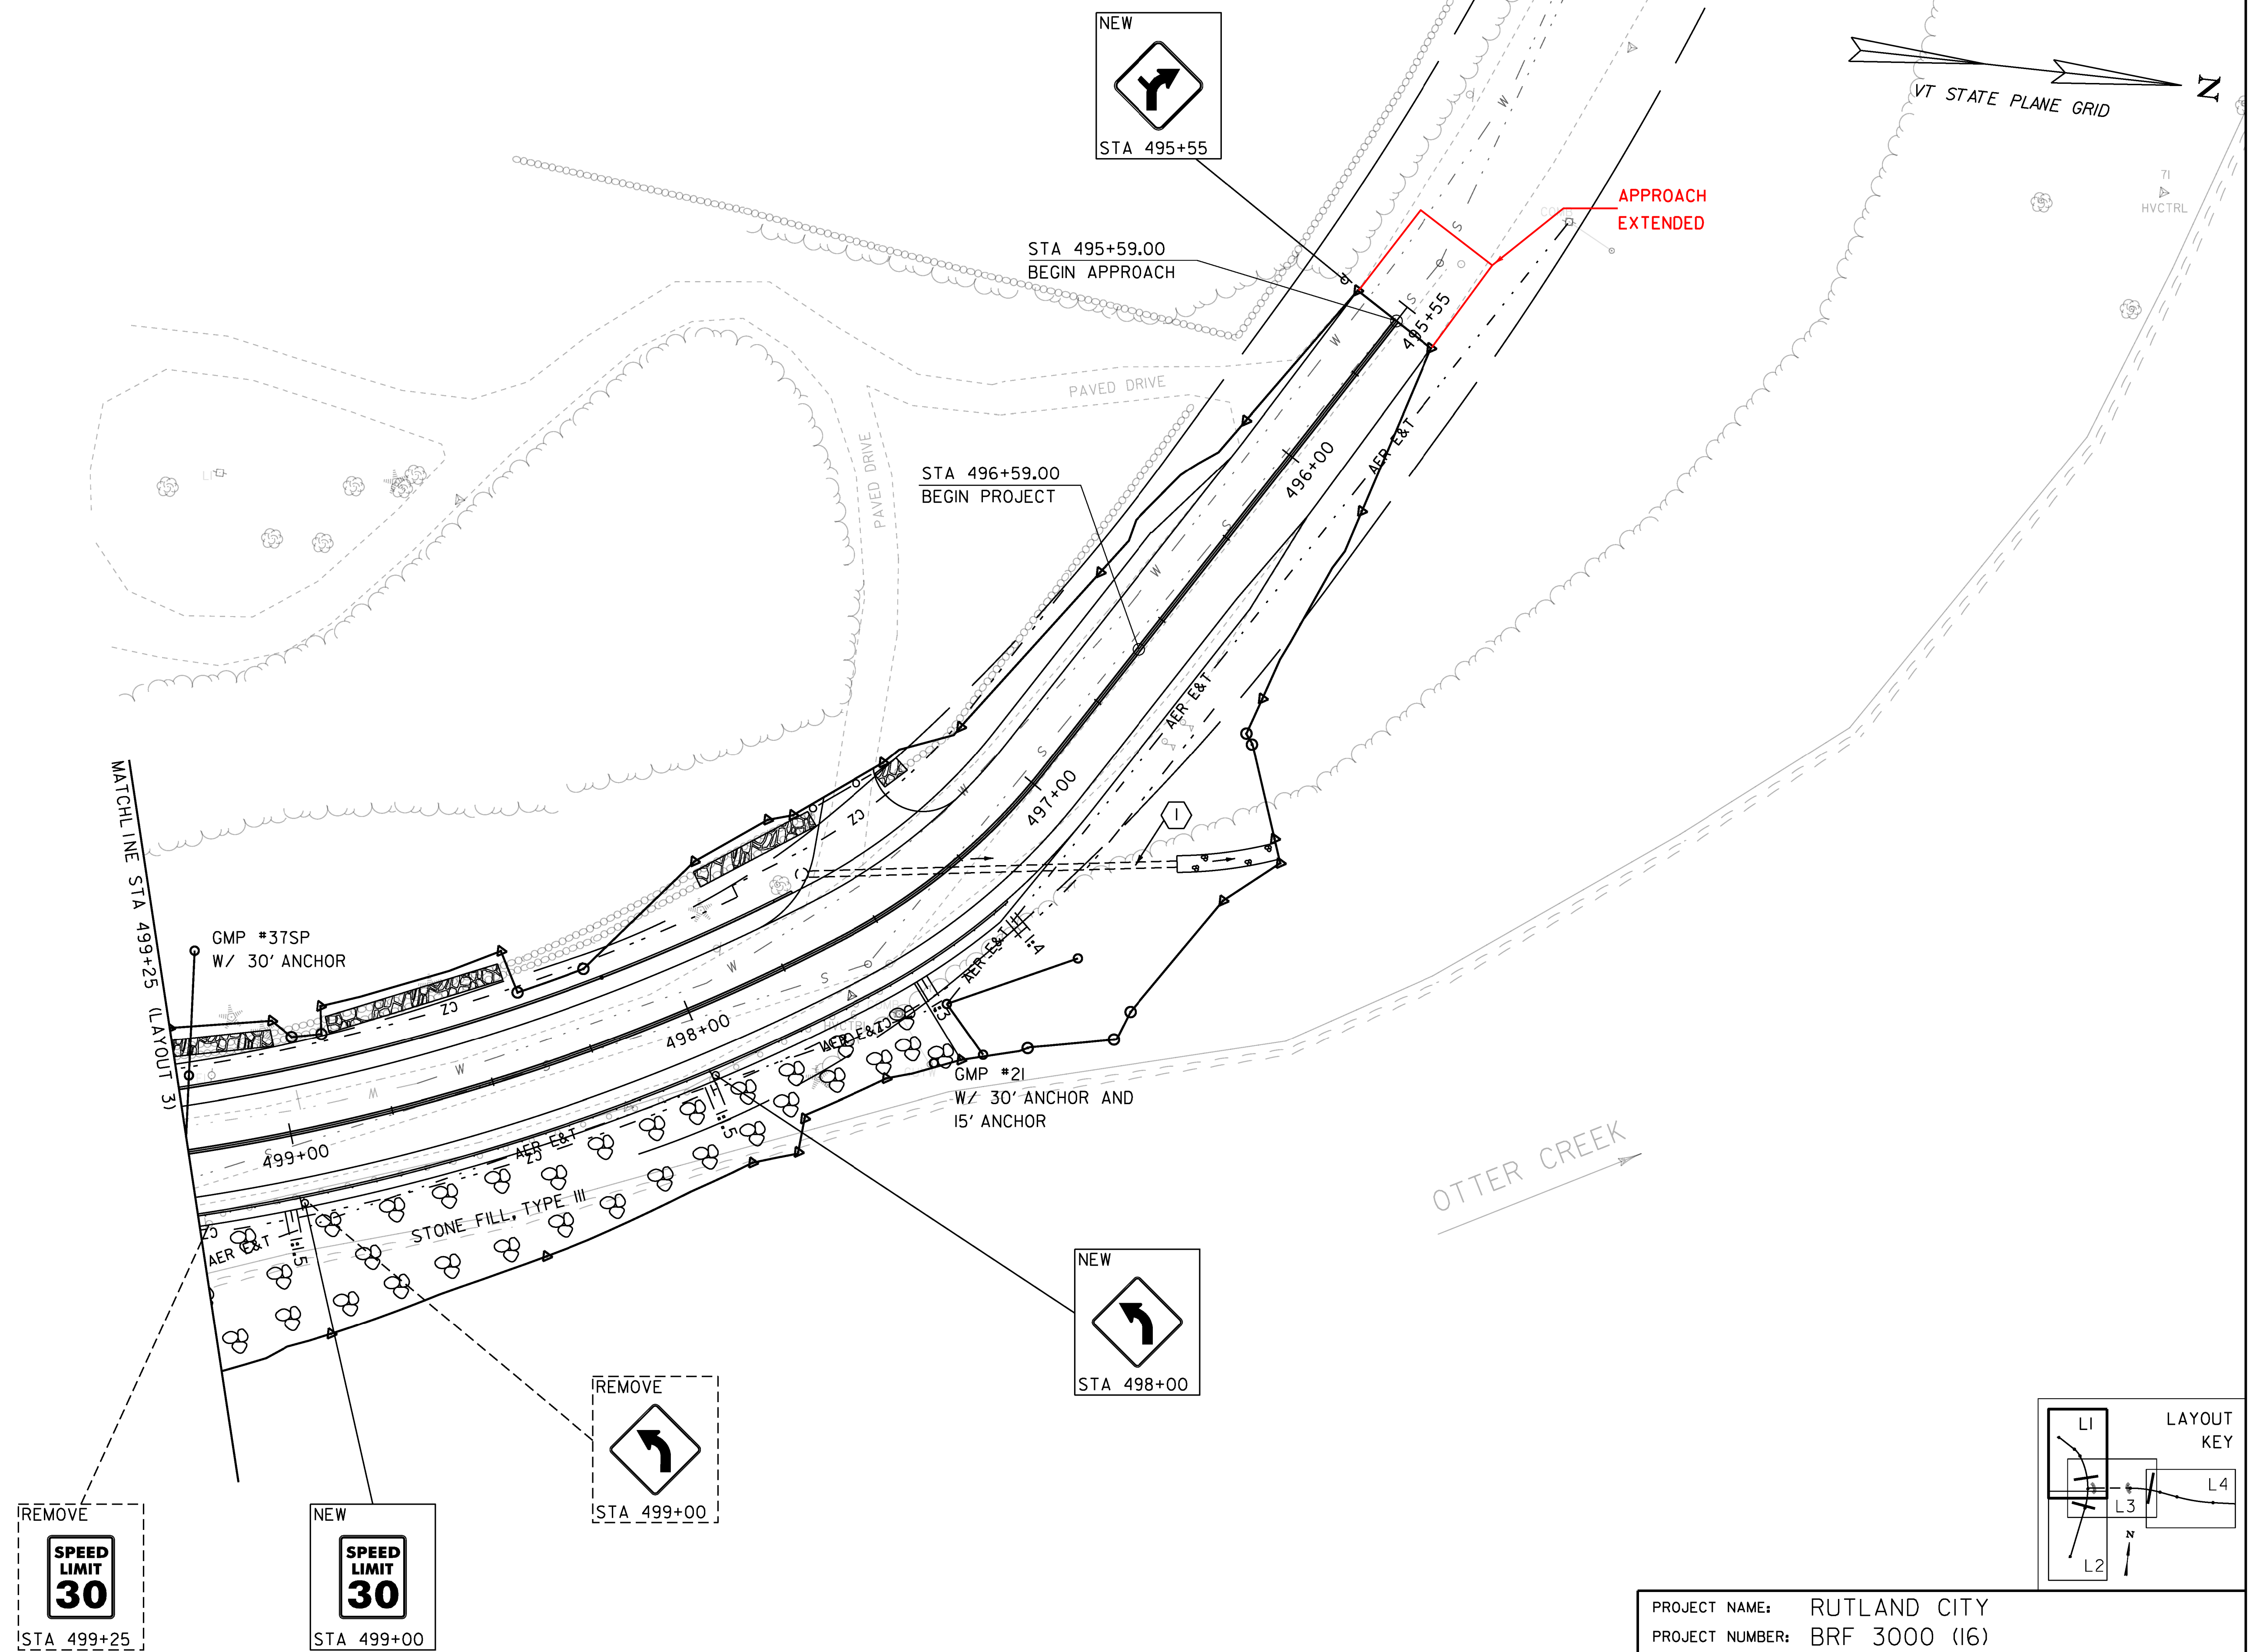

PROJECT NAME: RUTLAND CITY
 PROJECT NUMBER: BRF 3000 (16)
 FILE NAME: s94J092+sBdr.dgn
 PROJECT LEADER: C. CARLSON
 DESIGNED BY: EVANS-MONGEON
 SIGN AND STRIPING LAYOUT SHEET 1
 PLOT DATE: 03-JUL-2014
 DRAWN BY: C. MOONEY
 CHECKED BY: EVANS-MONGEON
 SHEET 145 OF 245

