
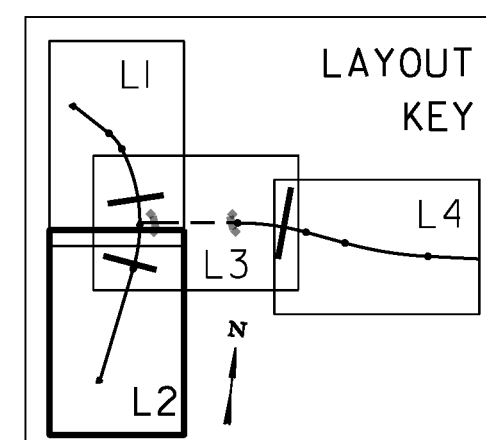
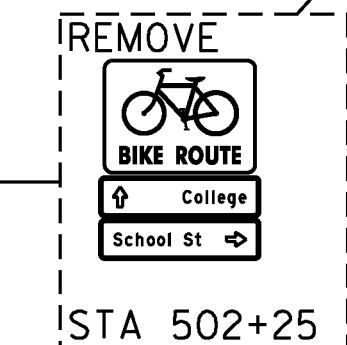
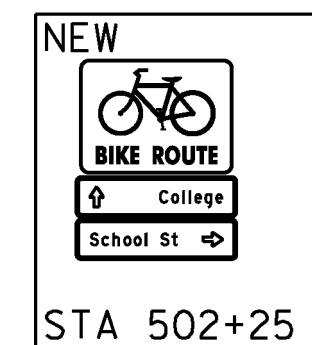
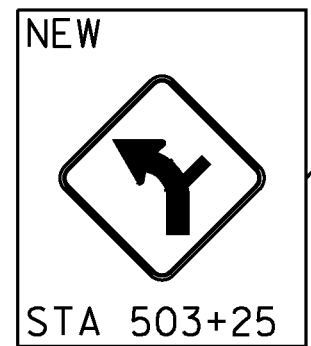
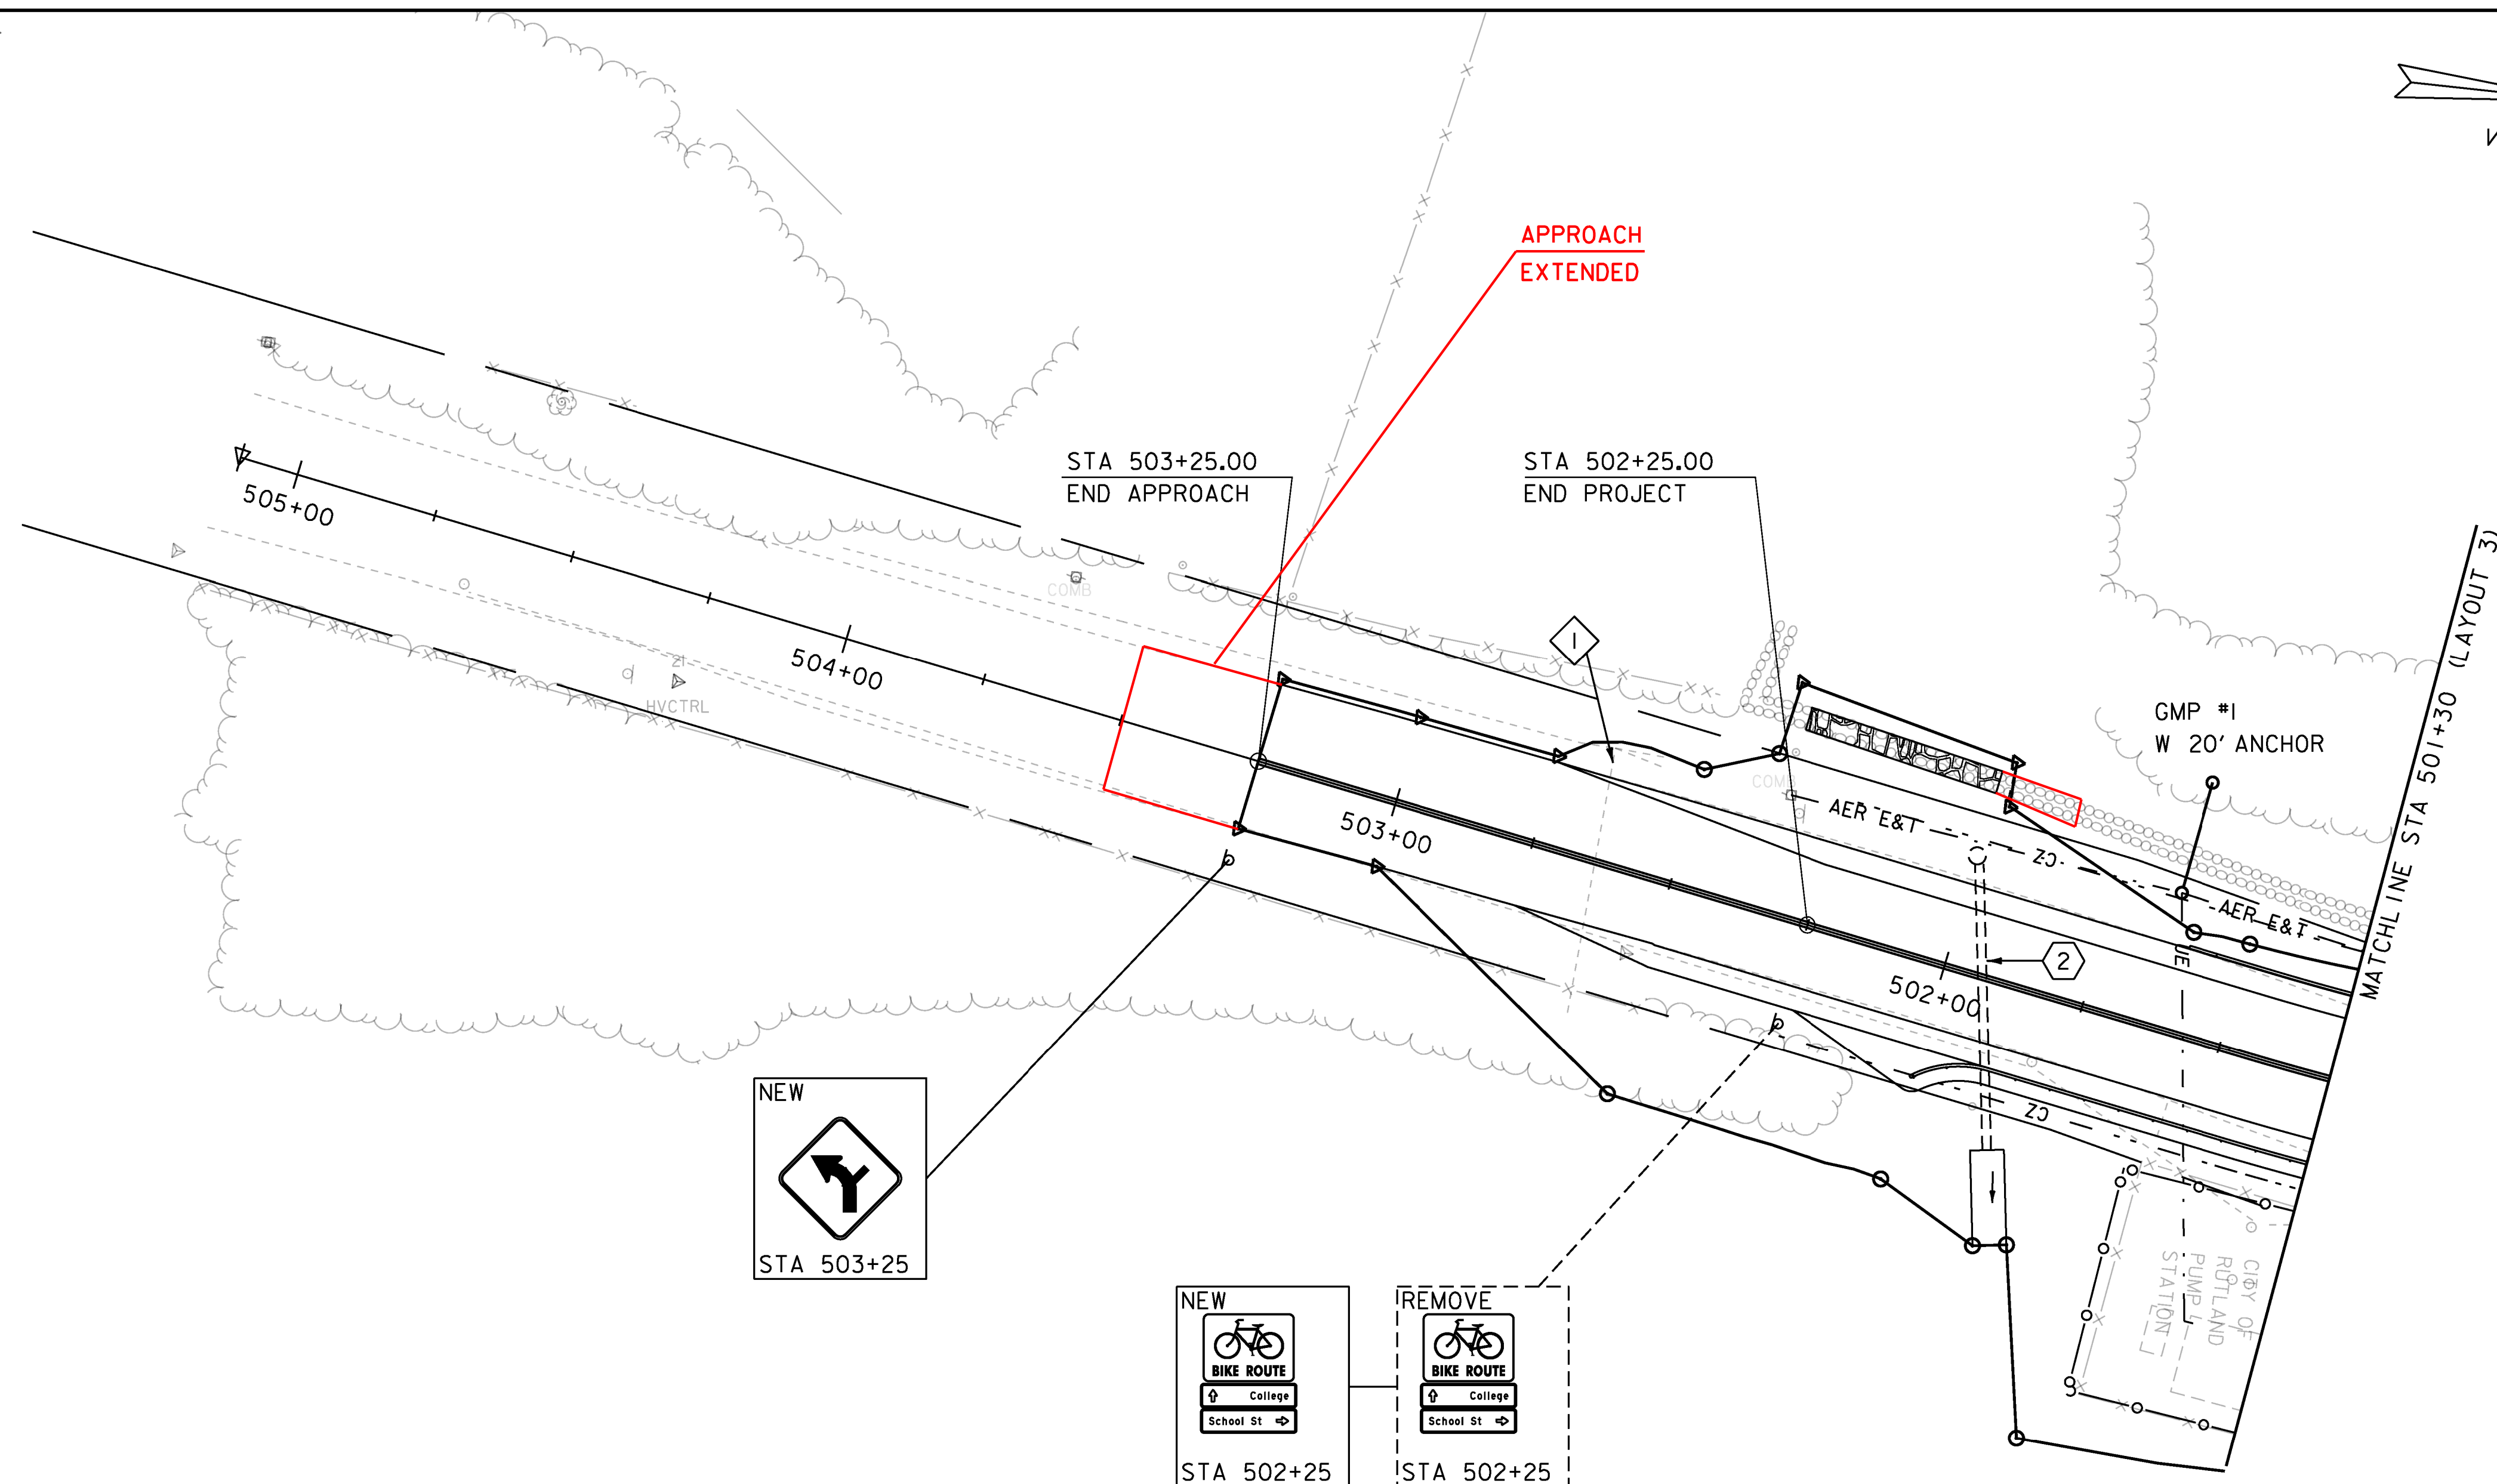


DURABLE 4" YELLOW LINE
 RECESSED POLYUREA (DOUBLE CL) (TH 10)
 STA 501+30.00 - STA 503+25.00

DURABLE 4" WHITE LINE,
 RECESSED POLYUREA (TH 10)
 STA 501+30.00 - STA 503+25.00 LT
 STA 501+30.00 - STA 503+25.00 RT

REMOVING SIGNS
 STA 502+25.00 LT (3)

TRAFFIC SIGNS, TYPE A
 STA 502+25.00 LT (3)
 STA 503+25.00 LT

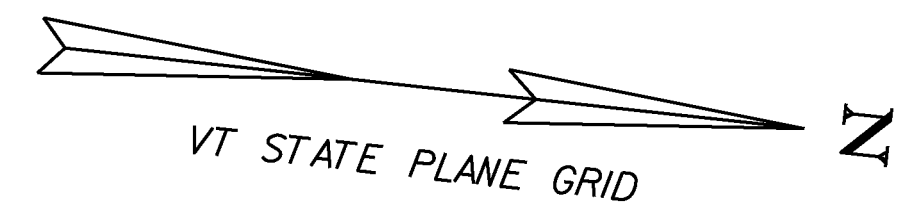

SCALE 1" = 20'-0"
 20 0 20

PROJECT NAME: RUTLAND CITY	PLOT DATE: 03-JUL-2014
PROJECT NUMBER: BRF 3000 (16)	DRAWN BY: C. MOONEY
FILE NAME: s94J092+sBdr.dgn	CHECKED BY: EVANS-MONGEON
PROJECT LEADER: C. CARLSON	SHEET 146 OF 245
DESIGNED BY: EVANS-MONGEON	
SIGN AND STRIPING LAYOUT SHEET 2	