

DURABLE 4" YELLOW LINE,
RECESSED POLYUREA (DOUBLE CL) (TH 8)
STA 100+10 - STA 104+50.00

DURABLE 4" YELLOW LINE,
RECESSED POLYUREA (DOUBLE CL) (TH 10)
STA 499+25.00 - 499+89.89
STA 500+10.11 - STA 501+30.00

DURABLE 4" WHITE LINE,
RECESSED POLYUREA (TH 10)
STA 499+25.00 - STA 499+89.89 LT
STA 500+10.11 - STA 501+30.00 LT
STA 499+25.00 - STA 501+30.00 RT

DURABLE 4" WHITE LINE,
RECESSED POLYUREA (TH 8)
STA 100+10 - STA 104+50.00 LT
STA 100+10 - STA 104+50.00 RT



DURABLE 24" STOP BAR,
RECESSED TYPE A TAPE (TH10)
STA 499+78.00
STA 500+20.00

DURABLE 24" STOP BAR,
RECESSED TYPE A TAPE (TH8)
STA 100+20.00

REMOVING SIGNS
STA 499+91.00 LT
STA 500+45.00 RT
STA 500+70 RT (3)
STA 500 +75.00 RT (4)
STA 501+25.00 LT (2)
STA 500+75.00 LT (2)
STA 500+50.00 LT








TRAFFIC SIGNS, TYPE A
STA 495+75.00 RT (2)
STA 499+91.00 RT (3)
STA 500+20.00 RT (4)
STA 500+20.00 LT (2)
STA 100+30.00 RT

EAST CREEK

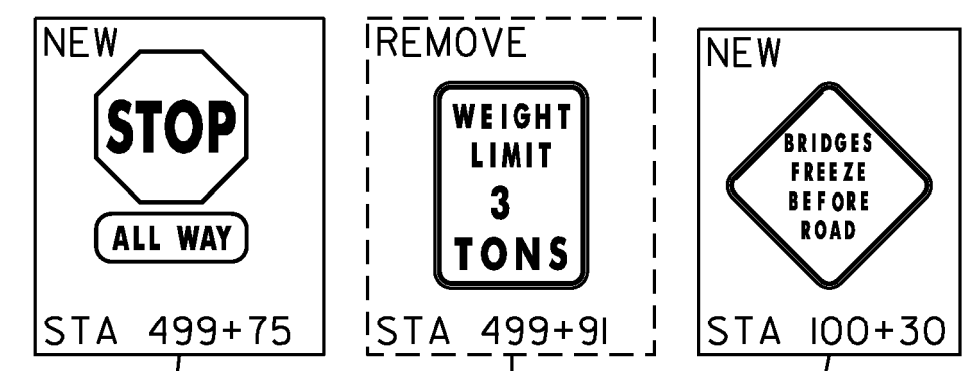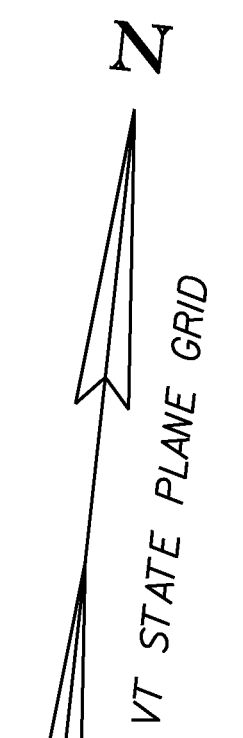


"STOP" SYMBOLS INSTALLED
AFTER CHANGE ORDER WAS
ISSUED

CONSTRUCT SIDEWALK
RAMP TYPE I
STA 103+85 LT
STA 104+35 LT

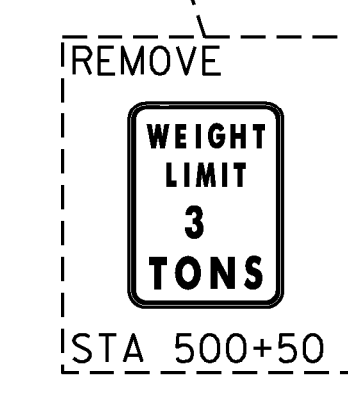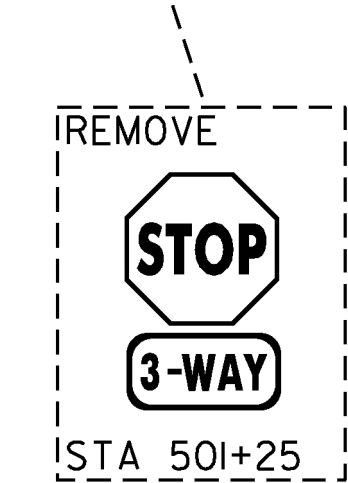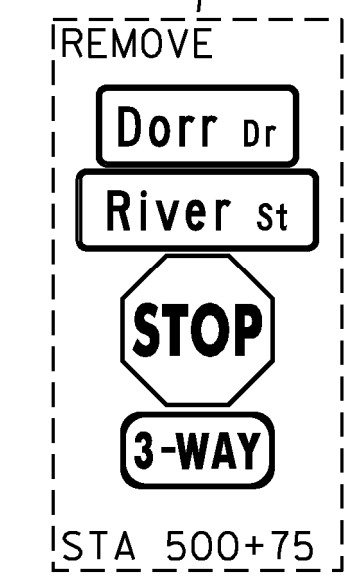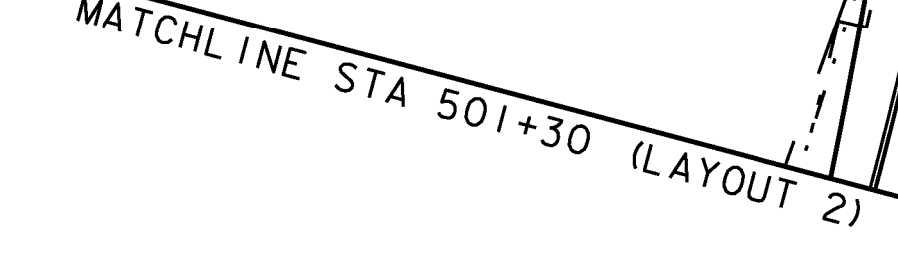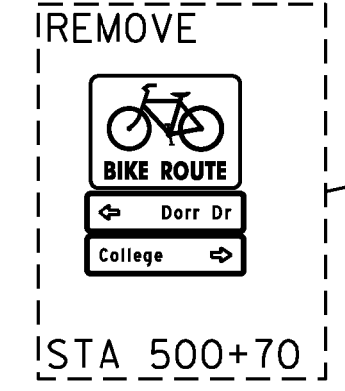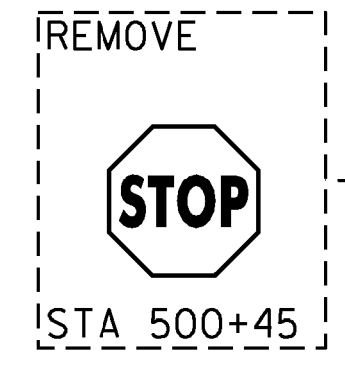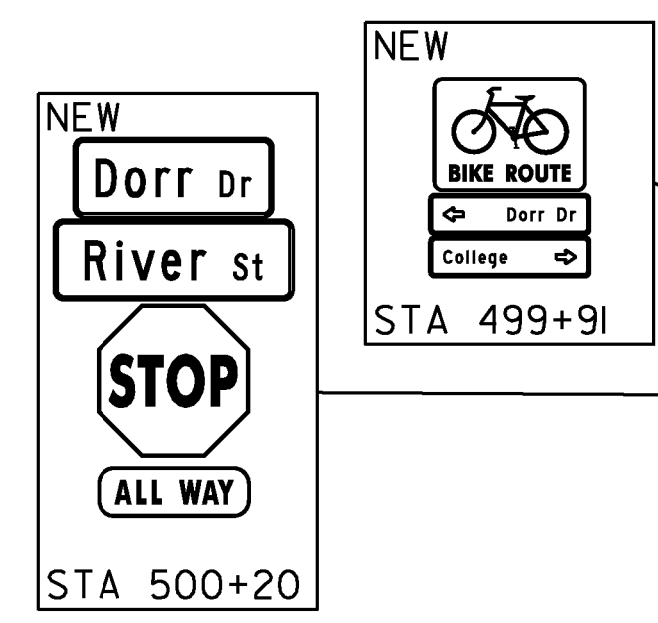


MATCHLINE STA 499+25 (LAYOUT 1)

MATCHLINE STA 104+50 (LAYOUT 4)

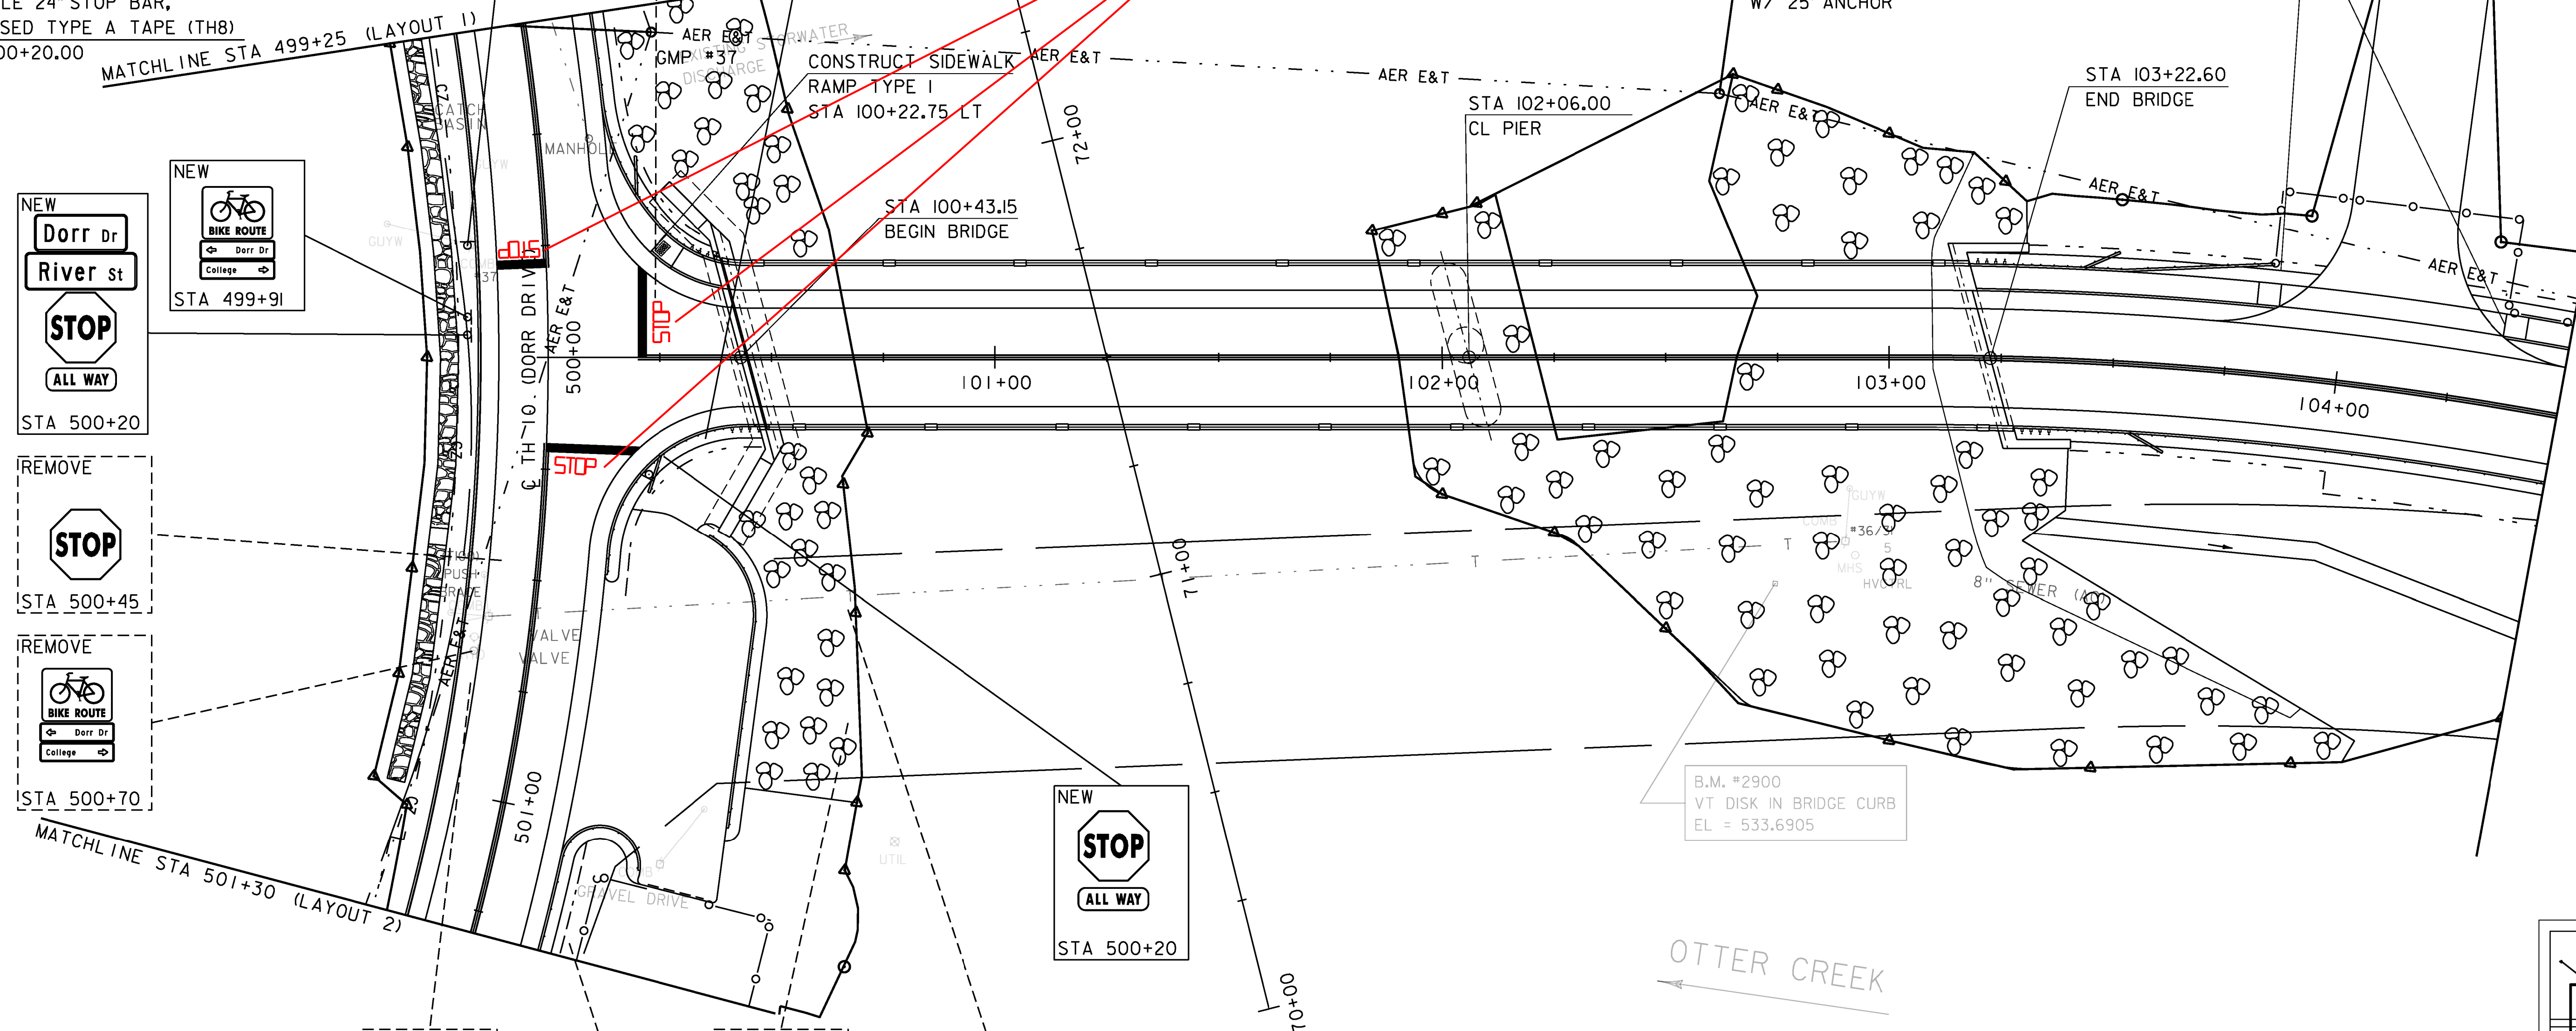

B.M. #2900
VT DISK IN BRIDGE CURB
EL = 533.6905

OTTER CREEK

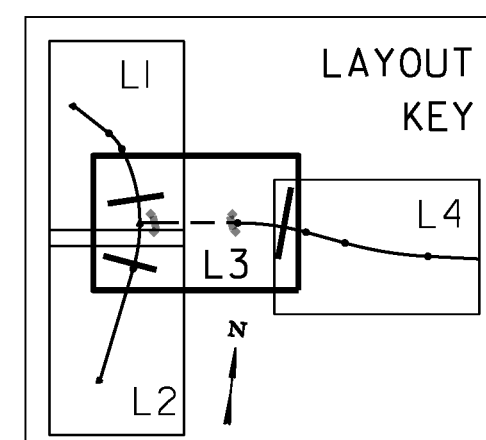

PROJECT NAME: RUTLAND CITY
PROJECT NUMBER: BRF 3000 (16)

FILE NAME: s94J092+sBdr.dgn
PROJECT LEADER: C. CARLSON
DESIGNED BY: EVANS-MONGEON
SIGN AND STRIPING LAYOUT SHEET 3

PLOT DATE: 03-JUL-2014
DRAWN BY: C. MOONEY
CHECKED BY: EVANS-MONGEON
SHEET 147 OF 245

