

DURABLE 4" WHITE LINE,  
RECESSED POLYUREA  
STA 104+50.00 - STA 109+00 LT  
STA 104+50.00 - STA 109+00 RT

DURABLE 4" YELLOW LINE,  
RECESSED POLYUREA (DOUBLE CL)  
STA 104+50.00 - 109+00

REMOVING SIGNS  
STA 106+30.00 RT(3)

TRAFFIC SIGNS, TYPE A  
STA 106+30.00 LT (2)

REMOVE

WEIGHT  
LIMIT  
3  
TONS

NO  
PARKING  
THIS  
SIDE

BRIDGES  
FREEZE  
BEFORE  
ROAD

STA 106+30

NEW  
NO  
PARKING  
THIS  
SIDE  
BRIDGES  
FREEZE  
BEFORE  
ROAD  
STA 106+30

CONSTRUCT SIDEWALK  
RAMP TYPE I  
STA 107+34 LT

GRASS SWALE 4  
FOR STORMWATER  
TREATMENT

GRASS SWALE 3  
FOR STORMWATER  
TREATMENT

GMP #34  
W/ 25' ANCHOR

GRASS SWALE 5  
FOR STORMWATER  
TREATMENT

STA 109+00.00  
END APPROACH

STA 108+00.00  
END PROJECT

APPROACH  
EXTENDED

BUILDING

GRAVEL  
PARKING  
LOT

GARDEN

FENCE

CH 8 (RIVER STR)

110+00


109+00

108+00

107+00

106+00

105+00

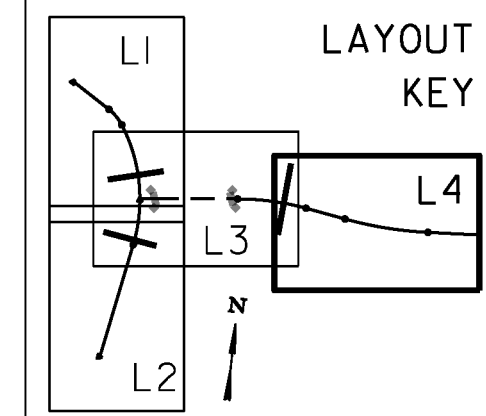

PROJECT NAME: RUTLAND CITY  
PROJECT NUMBER: BRF 3000 (16)  
FILE NAME: s94J092+sBdr.dgn  
PROJECT LEADER: C. CARLSON  
DESIGNED BY: EVANS-MONGEON  
SIGN AND STRIPING LAYOUT SHEET 4  
PLOT DATE: 03-JUL-2014  
DRAWN BY: C. MOONEY  
CHECKED BY: EVANS-MONGEON  
SHEET 148 OF 245

