


PLAN

SCALE 1" = 10'

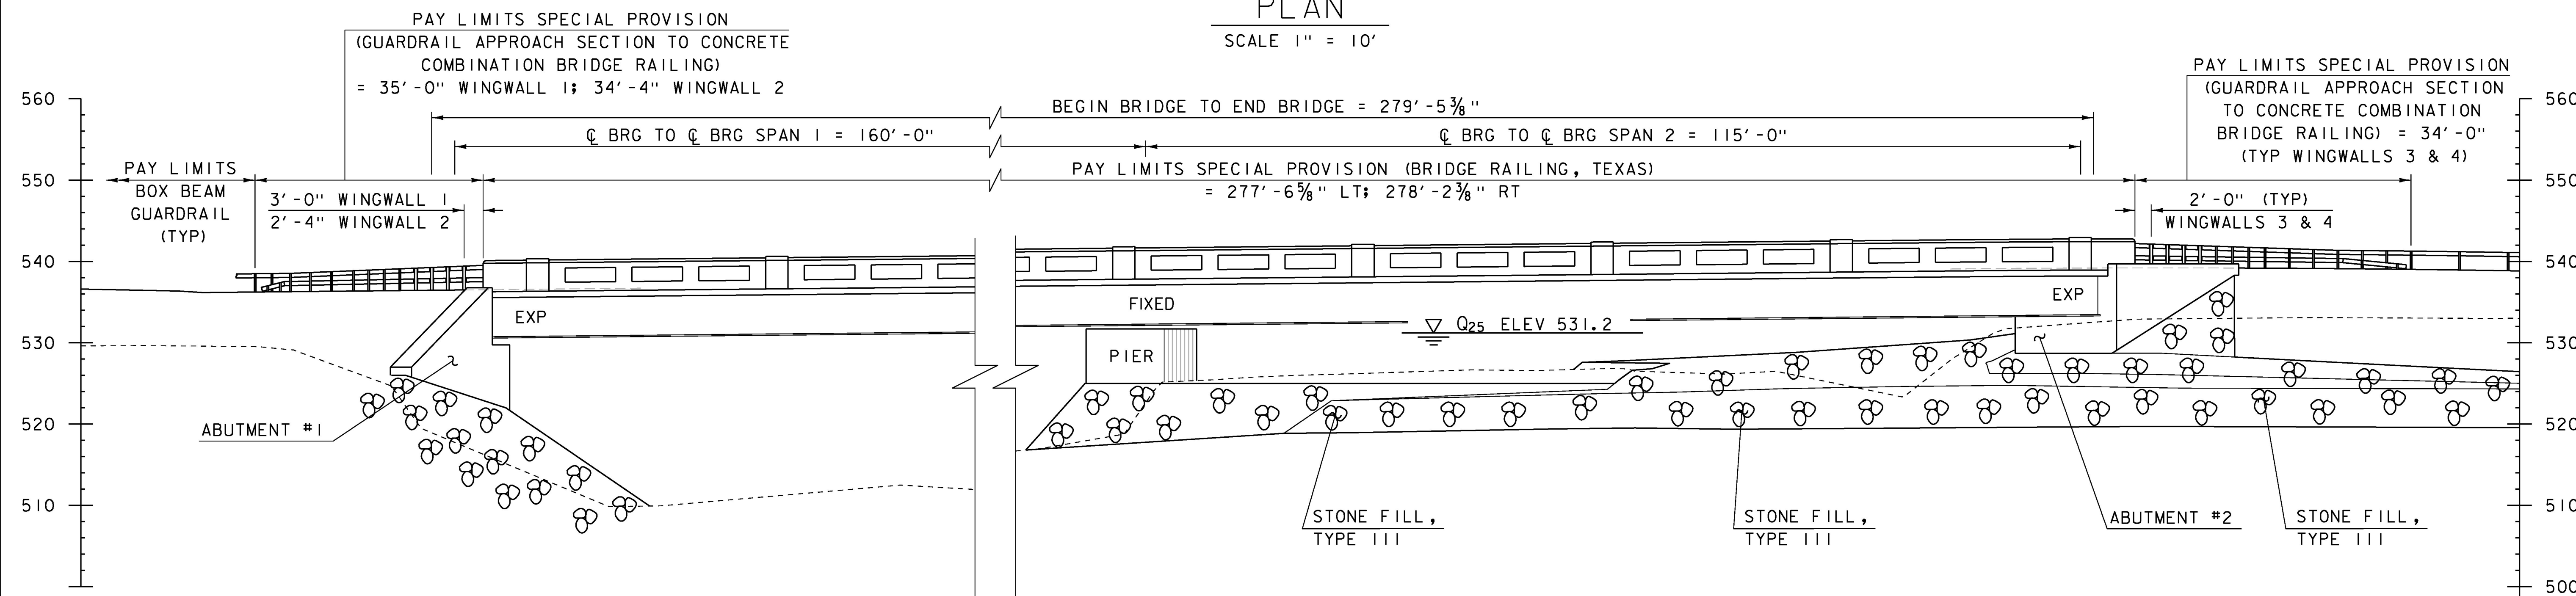

ELEVATION

SCALE 1" = 10'

PROJECT NAME:	RUTLAND CITY
PROJECT NUMBER:	BRF 3000 (16)
FILE NAME:	s94j092pe.dgn
PROJECT LEADER:	C. CARLSON
DESIGNED BY:	EVANS-MONGEON
PLAN AND ELEVATION	
PLOT DATE:	03-JUL-2014
DRAWN BY:	M.LONGSTREET
CHECKED BY:	EVANS-MONGEON
SHEET	162 OF 245