



STA. 103+22.60 END BRIDGE

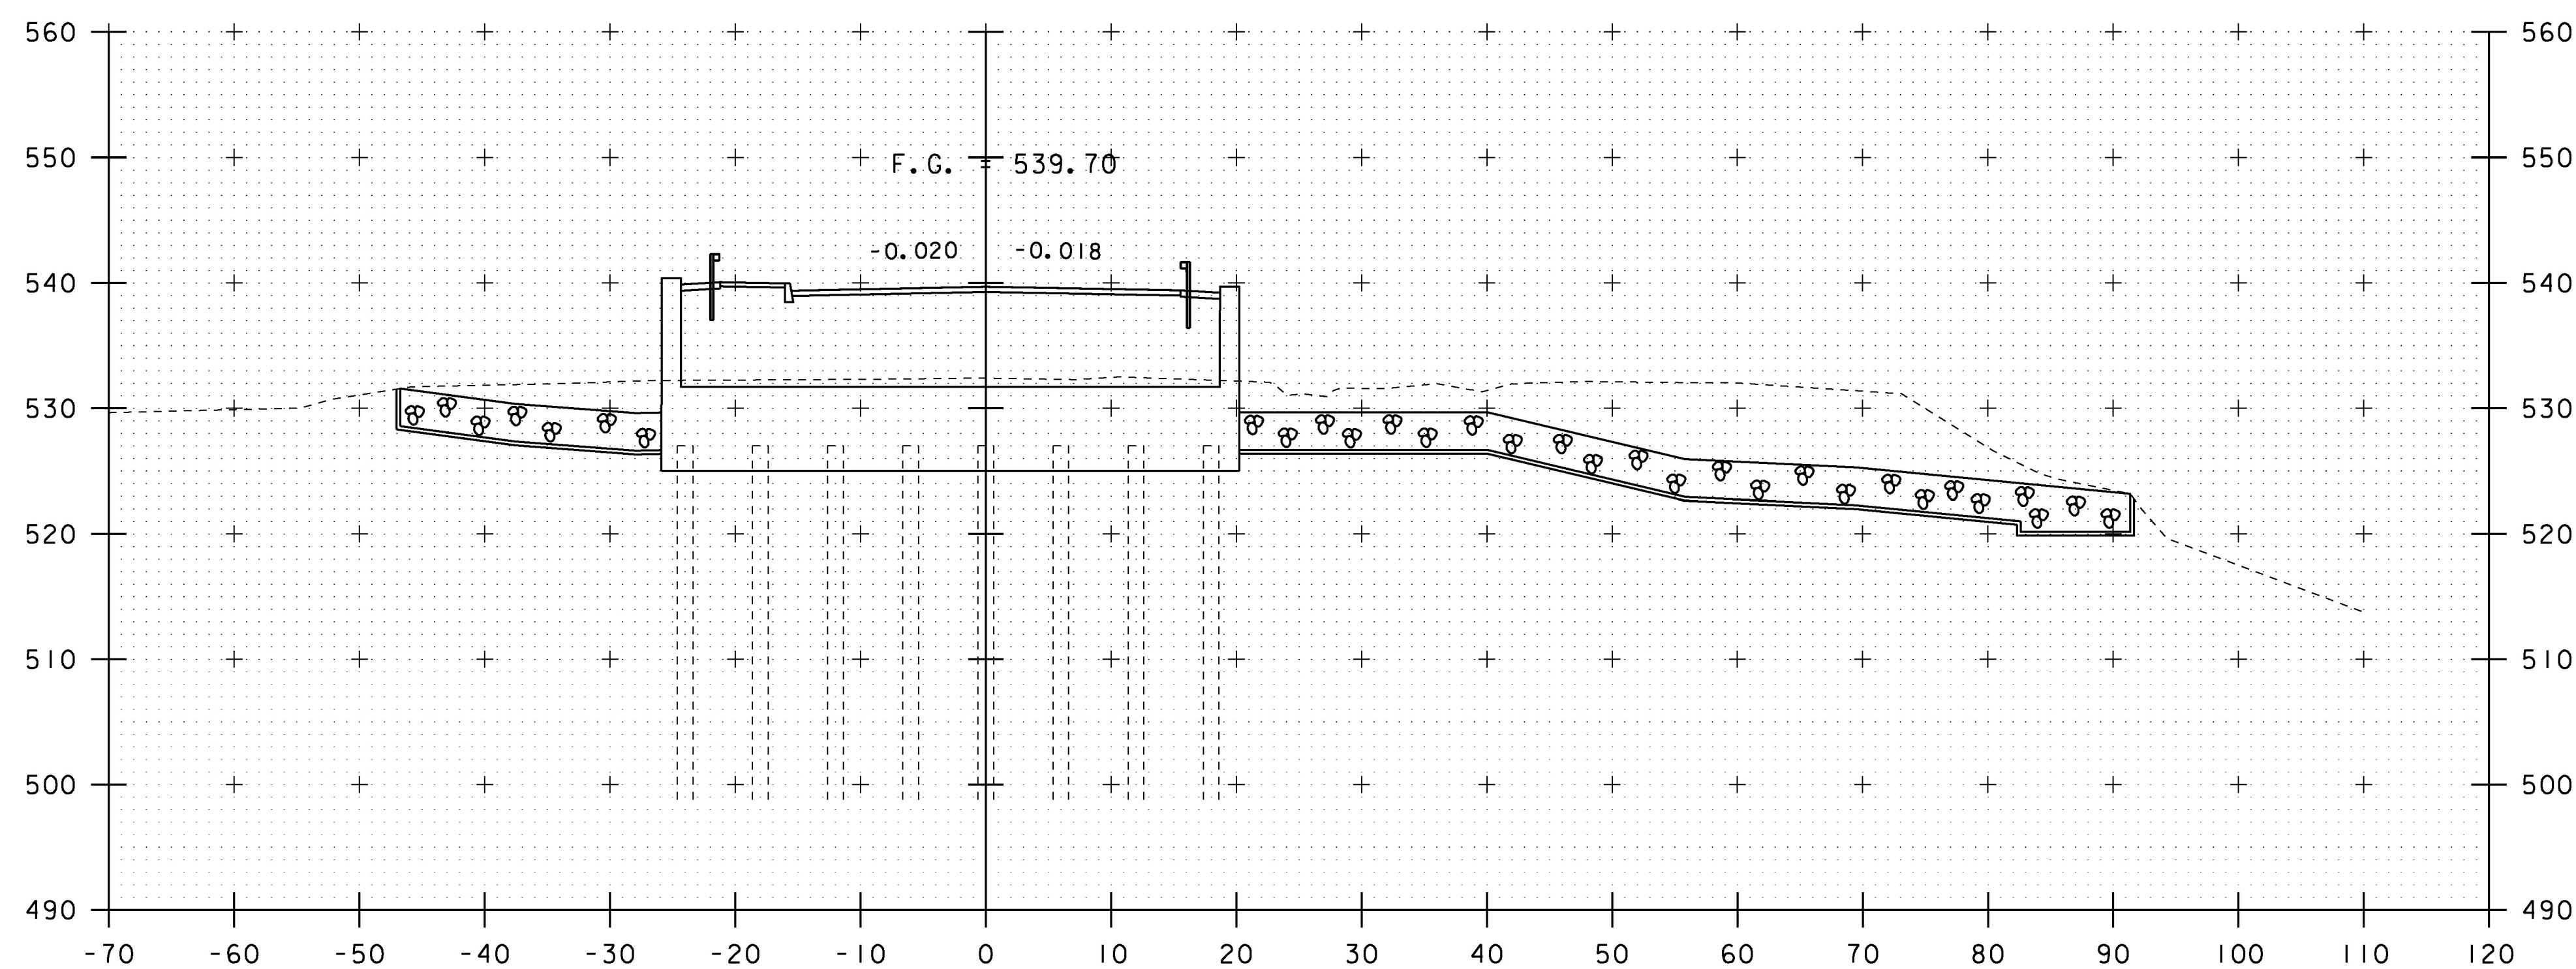

103+21 (SKEWED 15.14°)

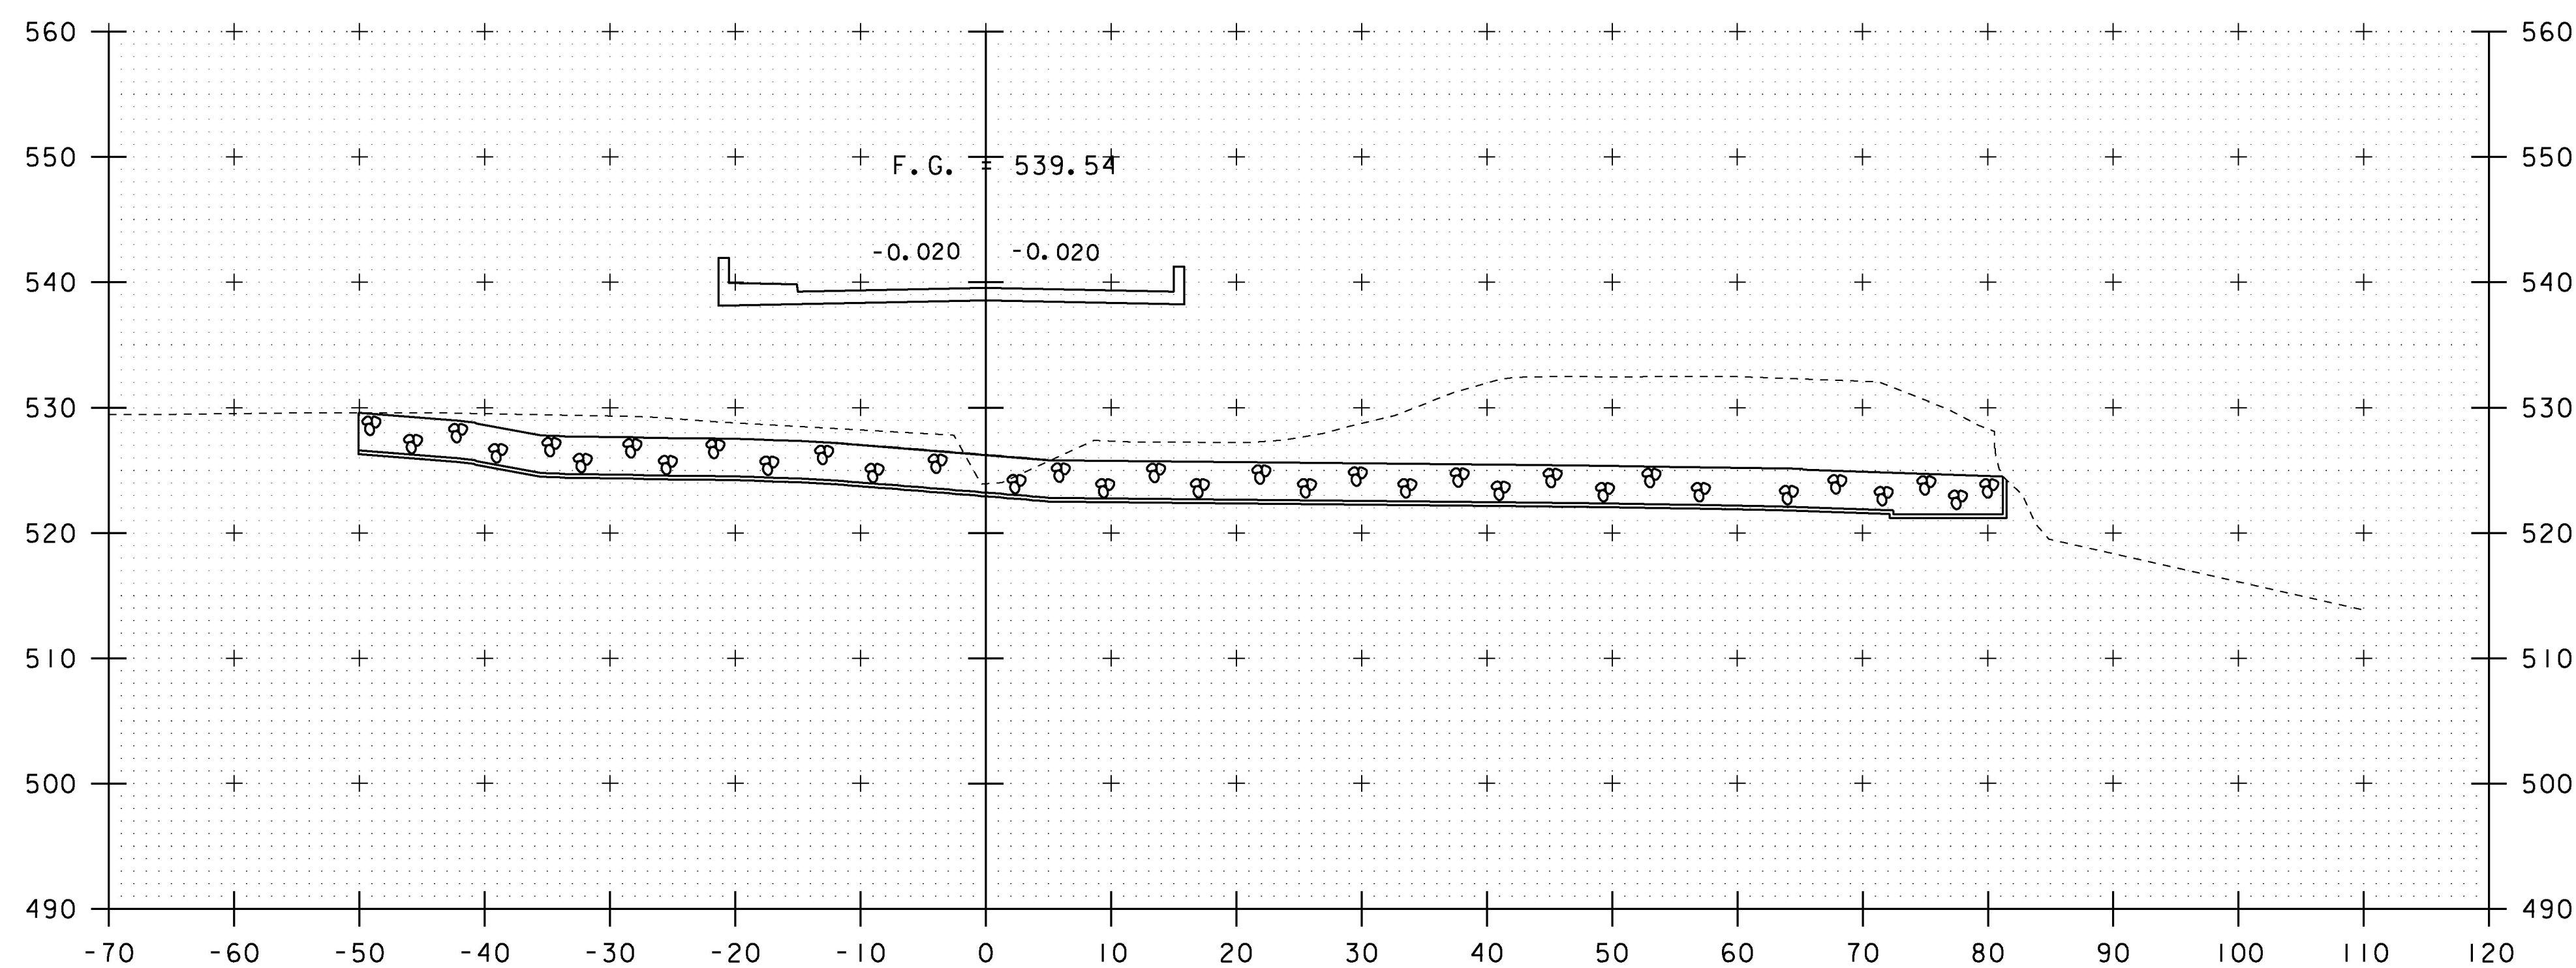

103+00

PROJECT NAME:	RUTLAND CITY
PROJECT NUMBER:	BRF 3000 (16)
FILE NAME:	s94j092xs.dgn
PROJECT LEADER:	C. CARLSON
DESIGNED BY:	M. EVANS-MONGEON
TH 8 CROSS SECTION SHEET 3	
PLOT DATE:	08-JUL-2014
DRAWN BY:	M. LONGSTREET
CHECKED BY:	EVANS-MONGEON
SHEET	201 OF 245

STA. 103+00 TO STA. 103+21