


106+50

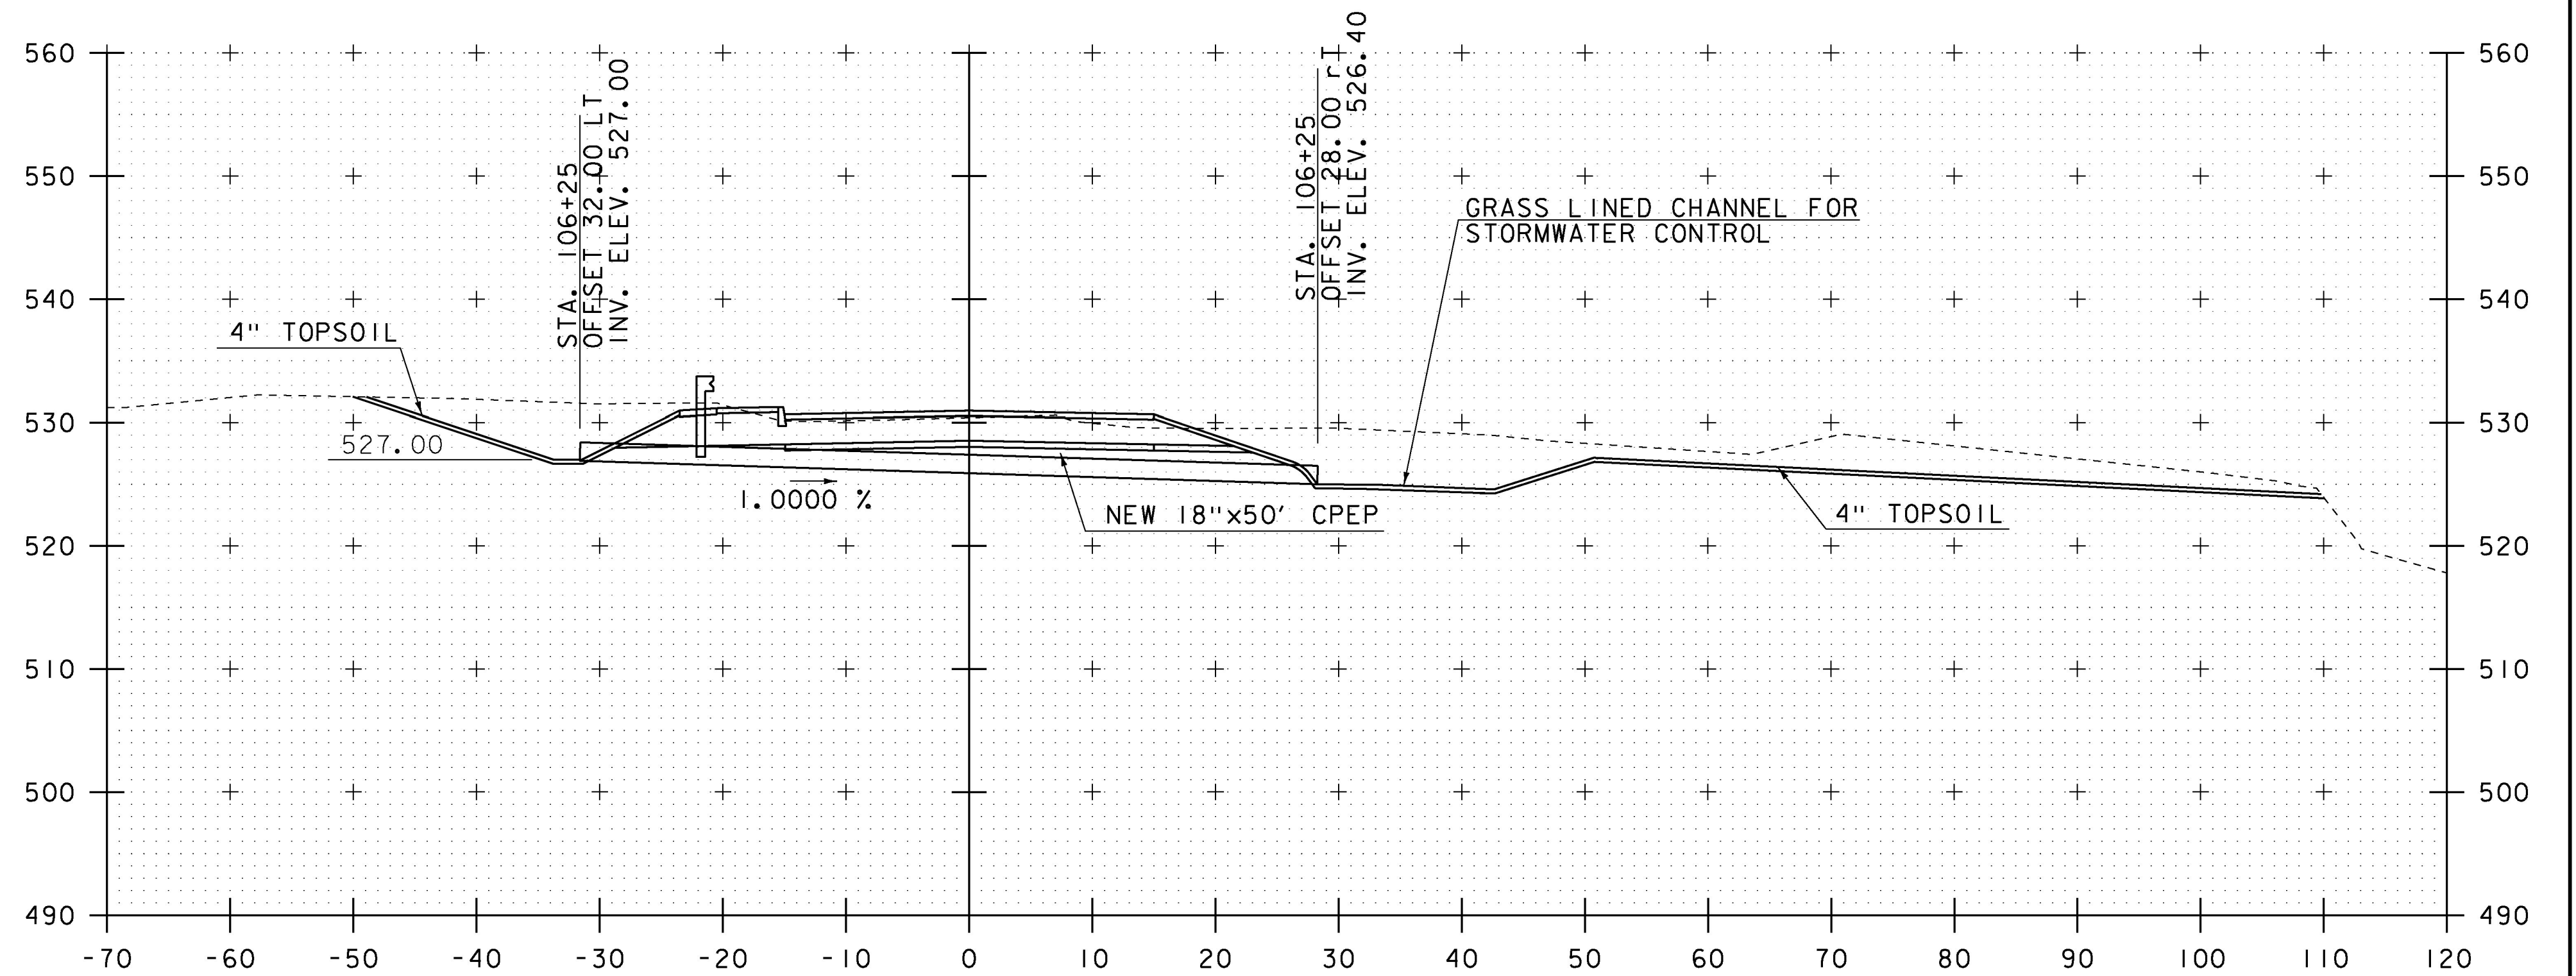

106+25

PROJECT NAME: RUTLAND CITY
 PROJECT NUMBER: BRF 3000 (16)

FILE NAME: s94j092xs.dgn
 PROJECT LEADER: C. CARLSON
 DESIGNED BY: M. EVANS-MONGEON
 TH 8 CROSS SECTION SHEET 7

PLOT DATE: 08-JUL-2014
 DRAWN BY: M. LONGSTREET
 CHECKED BY: EVANS-MONGEON
 SHEET 205 OF 245

STA. 106+25 TO STA. 106+50