



109+00

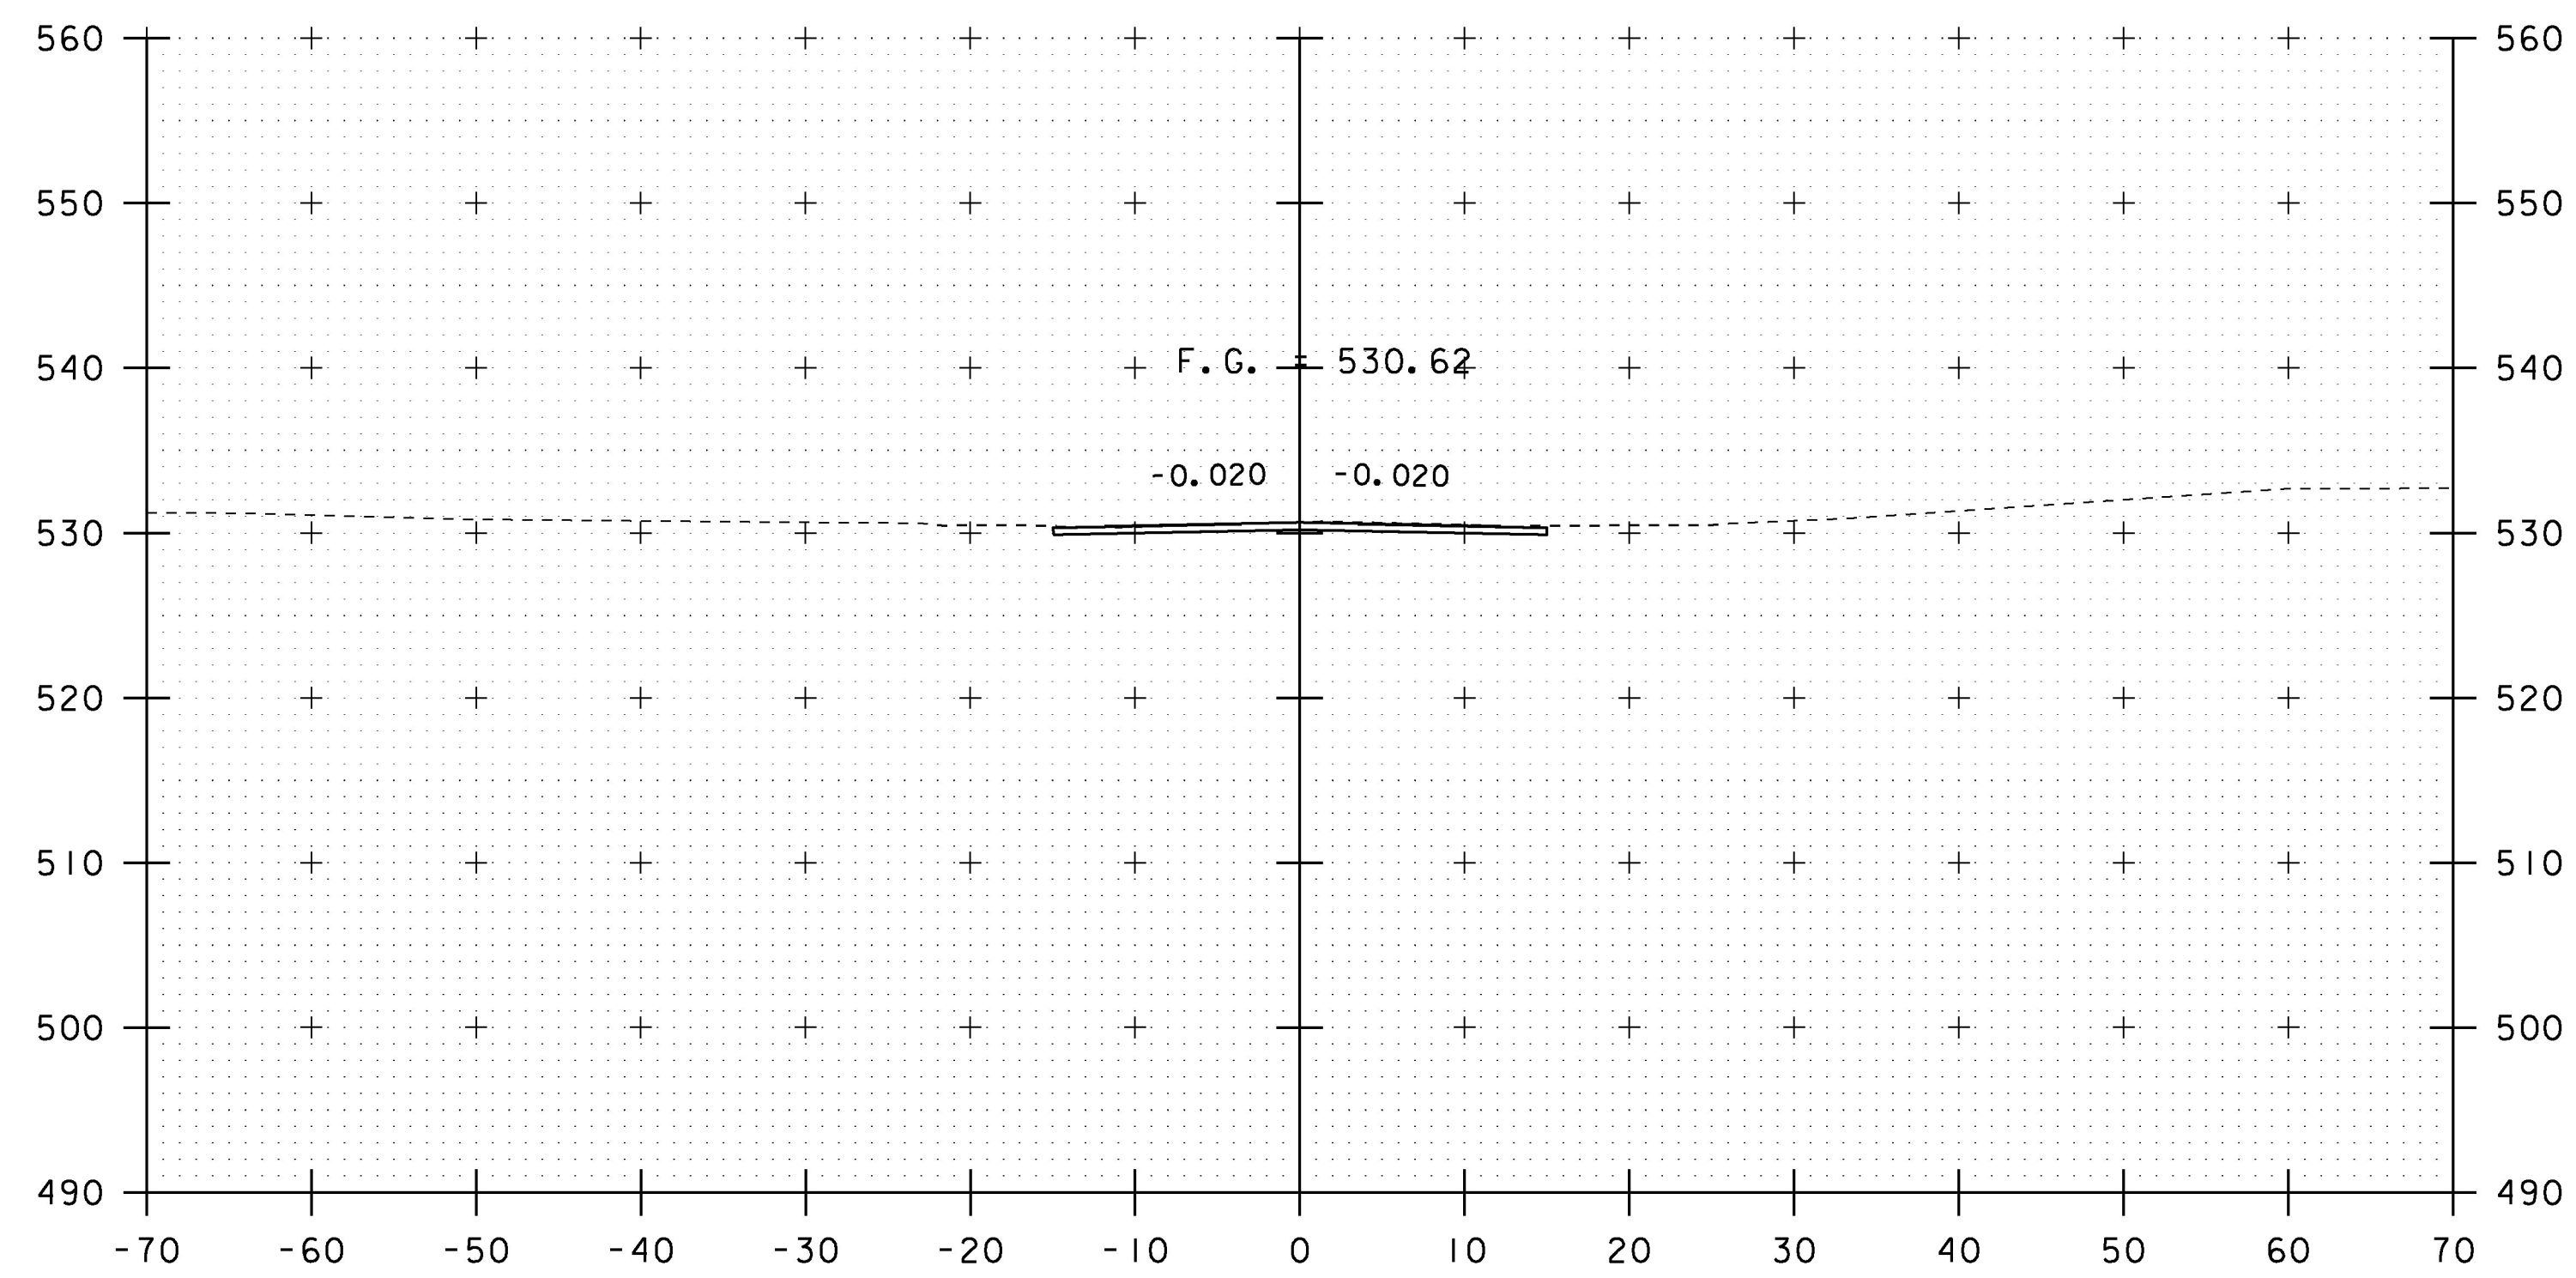

108+50

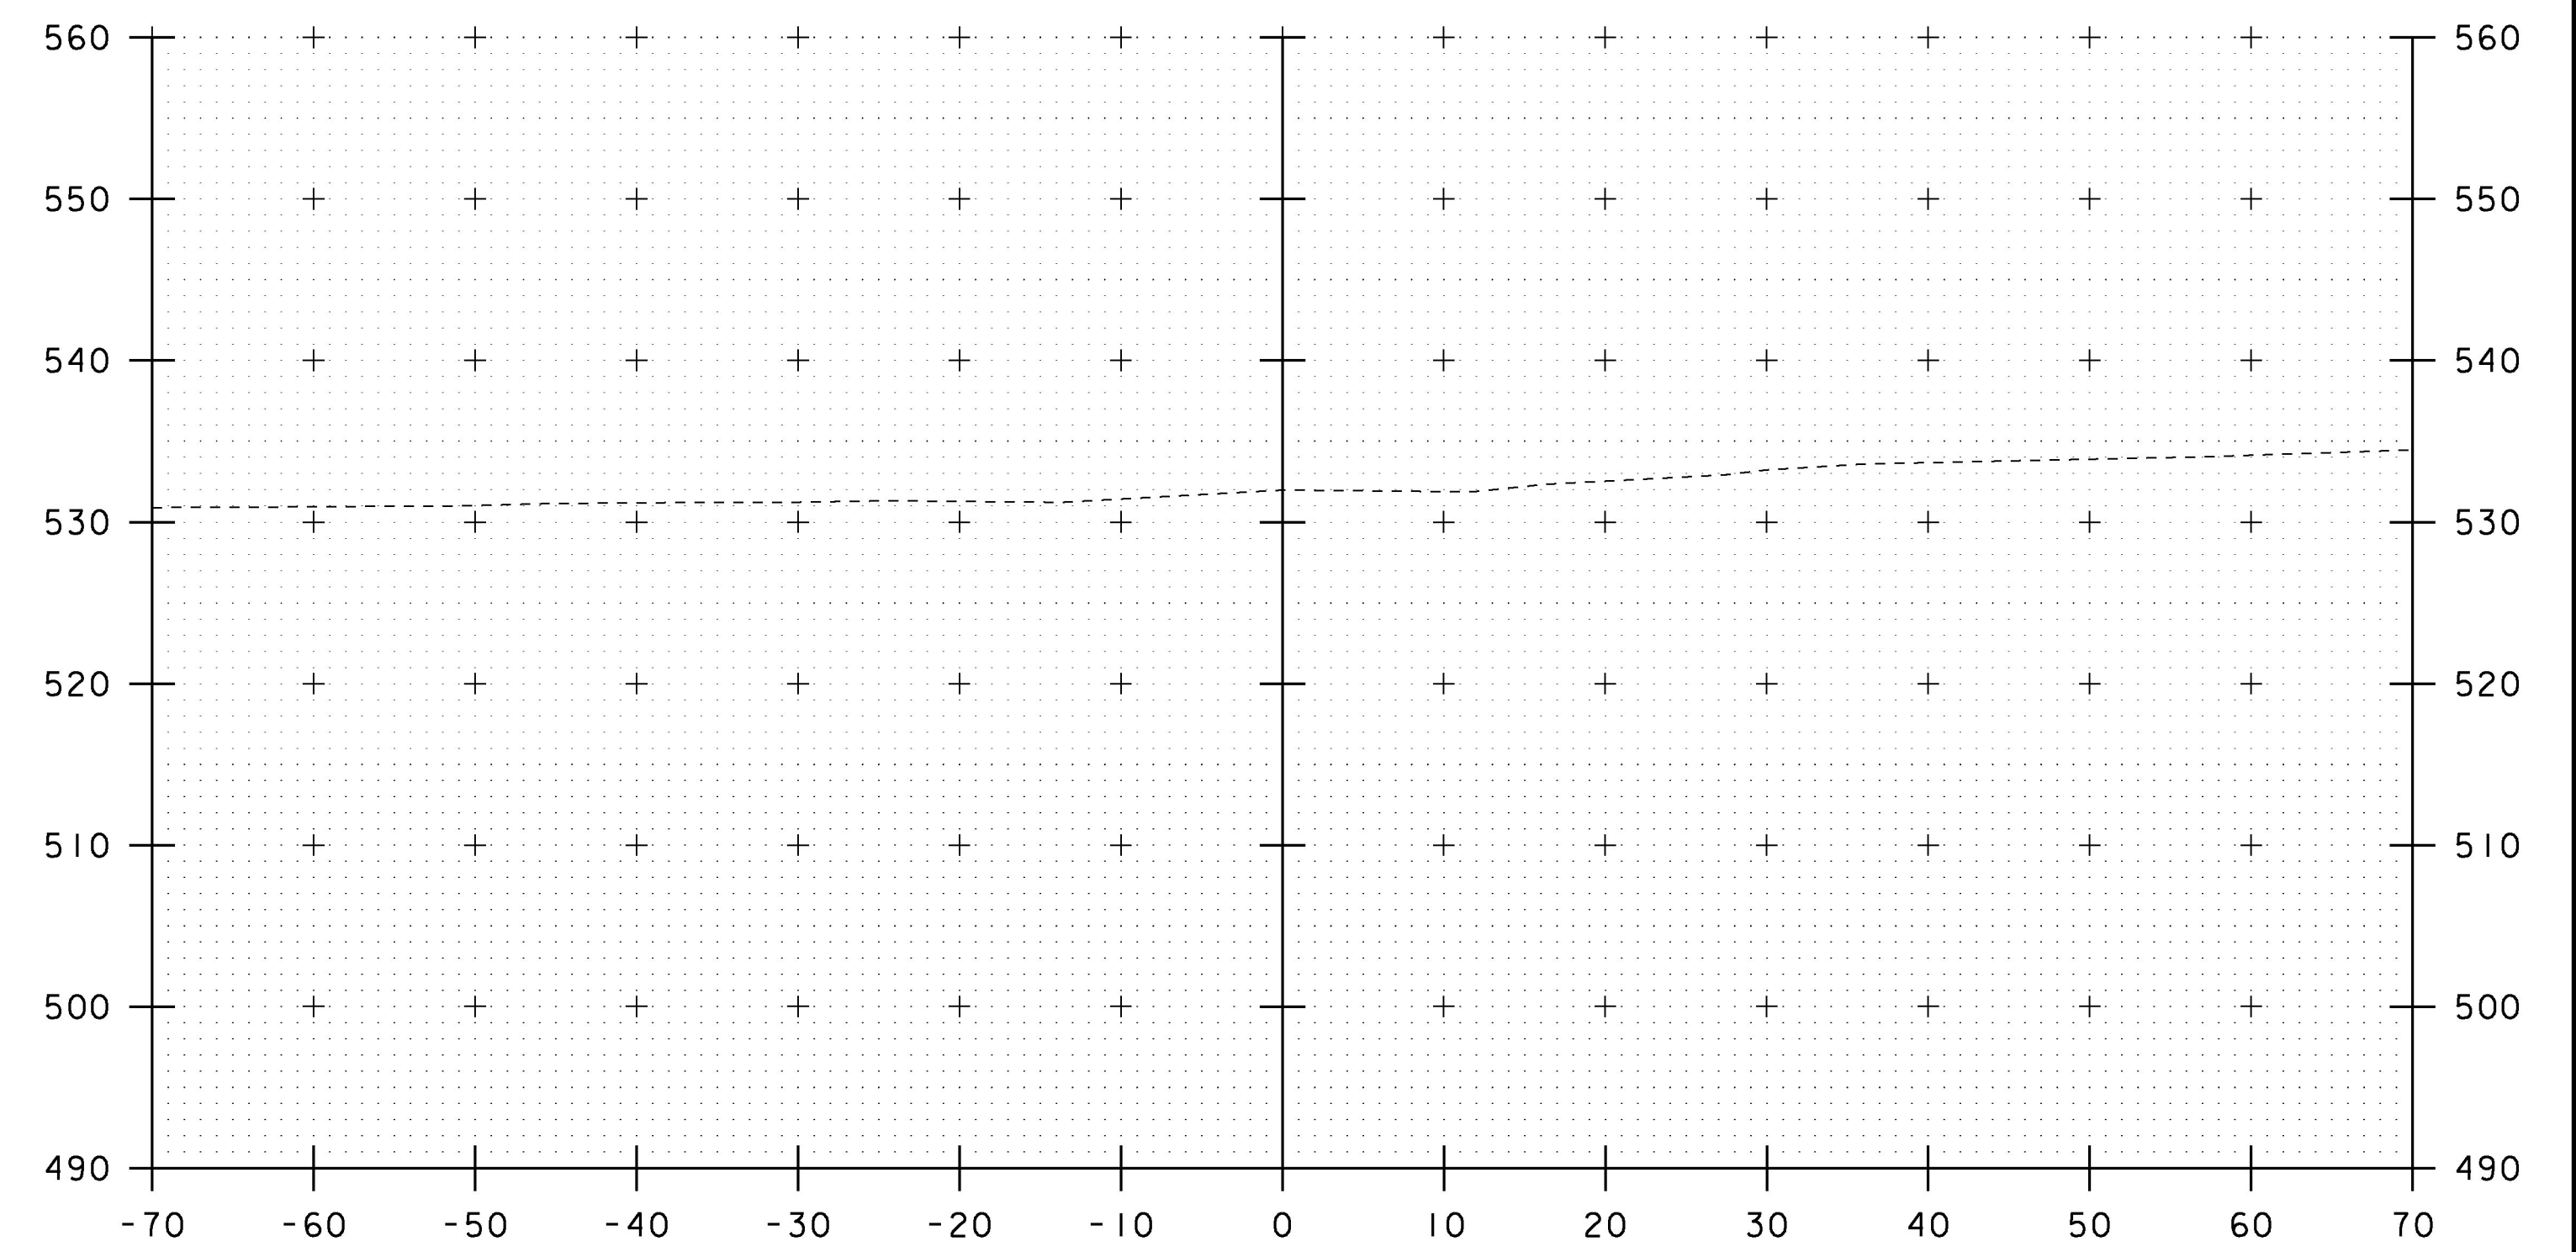

109+50

PROJECT NAME:	RUTLAND CITY	PLOT DATE:	08-JUL-2014
PROJECT NUMBER:	BRF 3000 (16)	DRAWN BY:	M.LONGSTREET
FILE NAME:	s94j092xs.dgn	DESIGNED BY:	M.EVANS-MONGEON
PROJECT LEADER:	C. CARLSON	CHECKED BY:	EVANS-MONGEON
TH 8 CROSS SECTION SHEET 9		SHEET	207 OF 245

STA. 108+50 TO STA. 109+00