




496+00

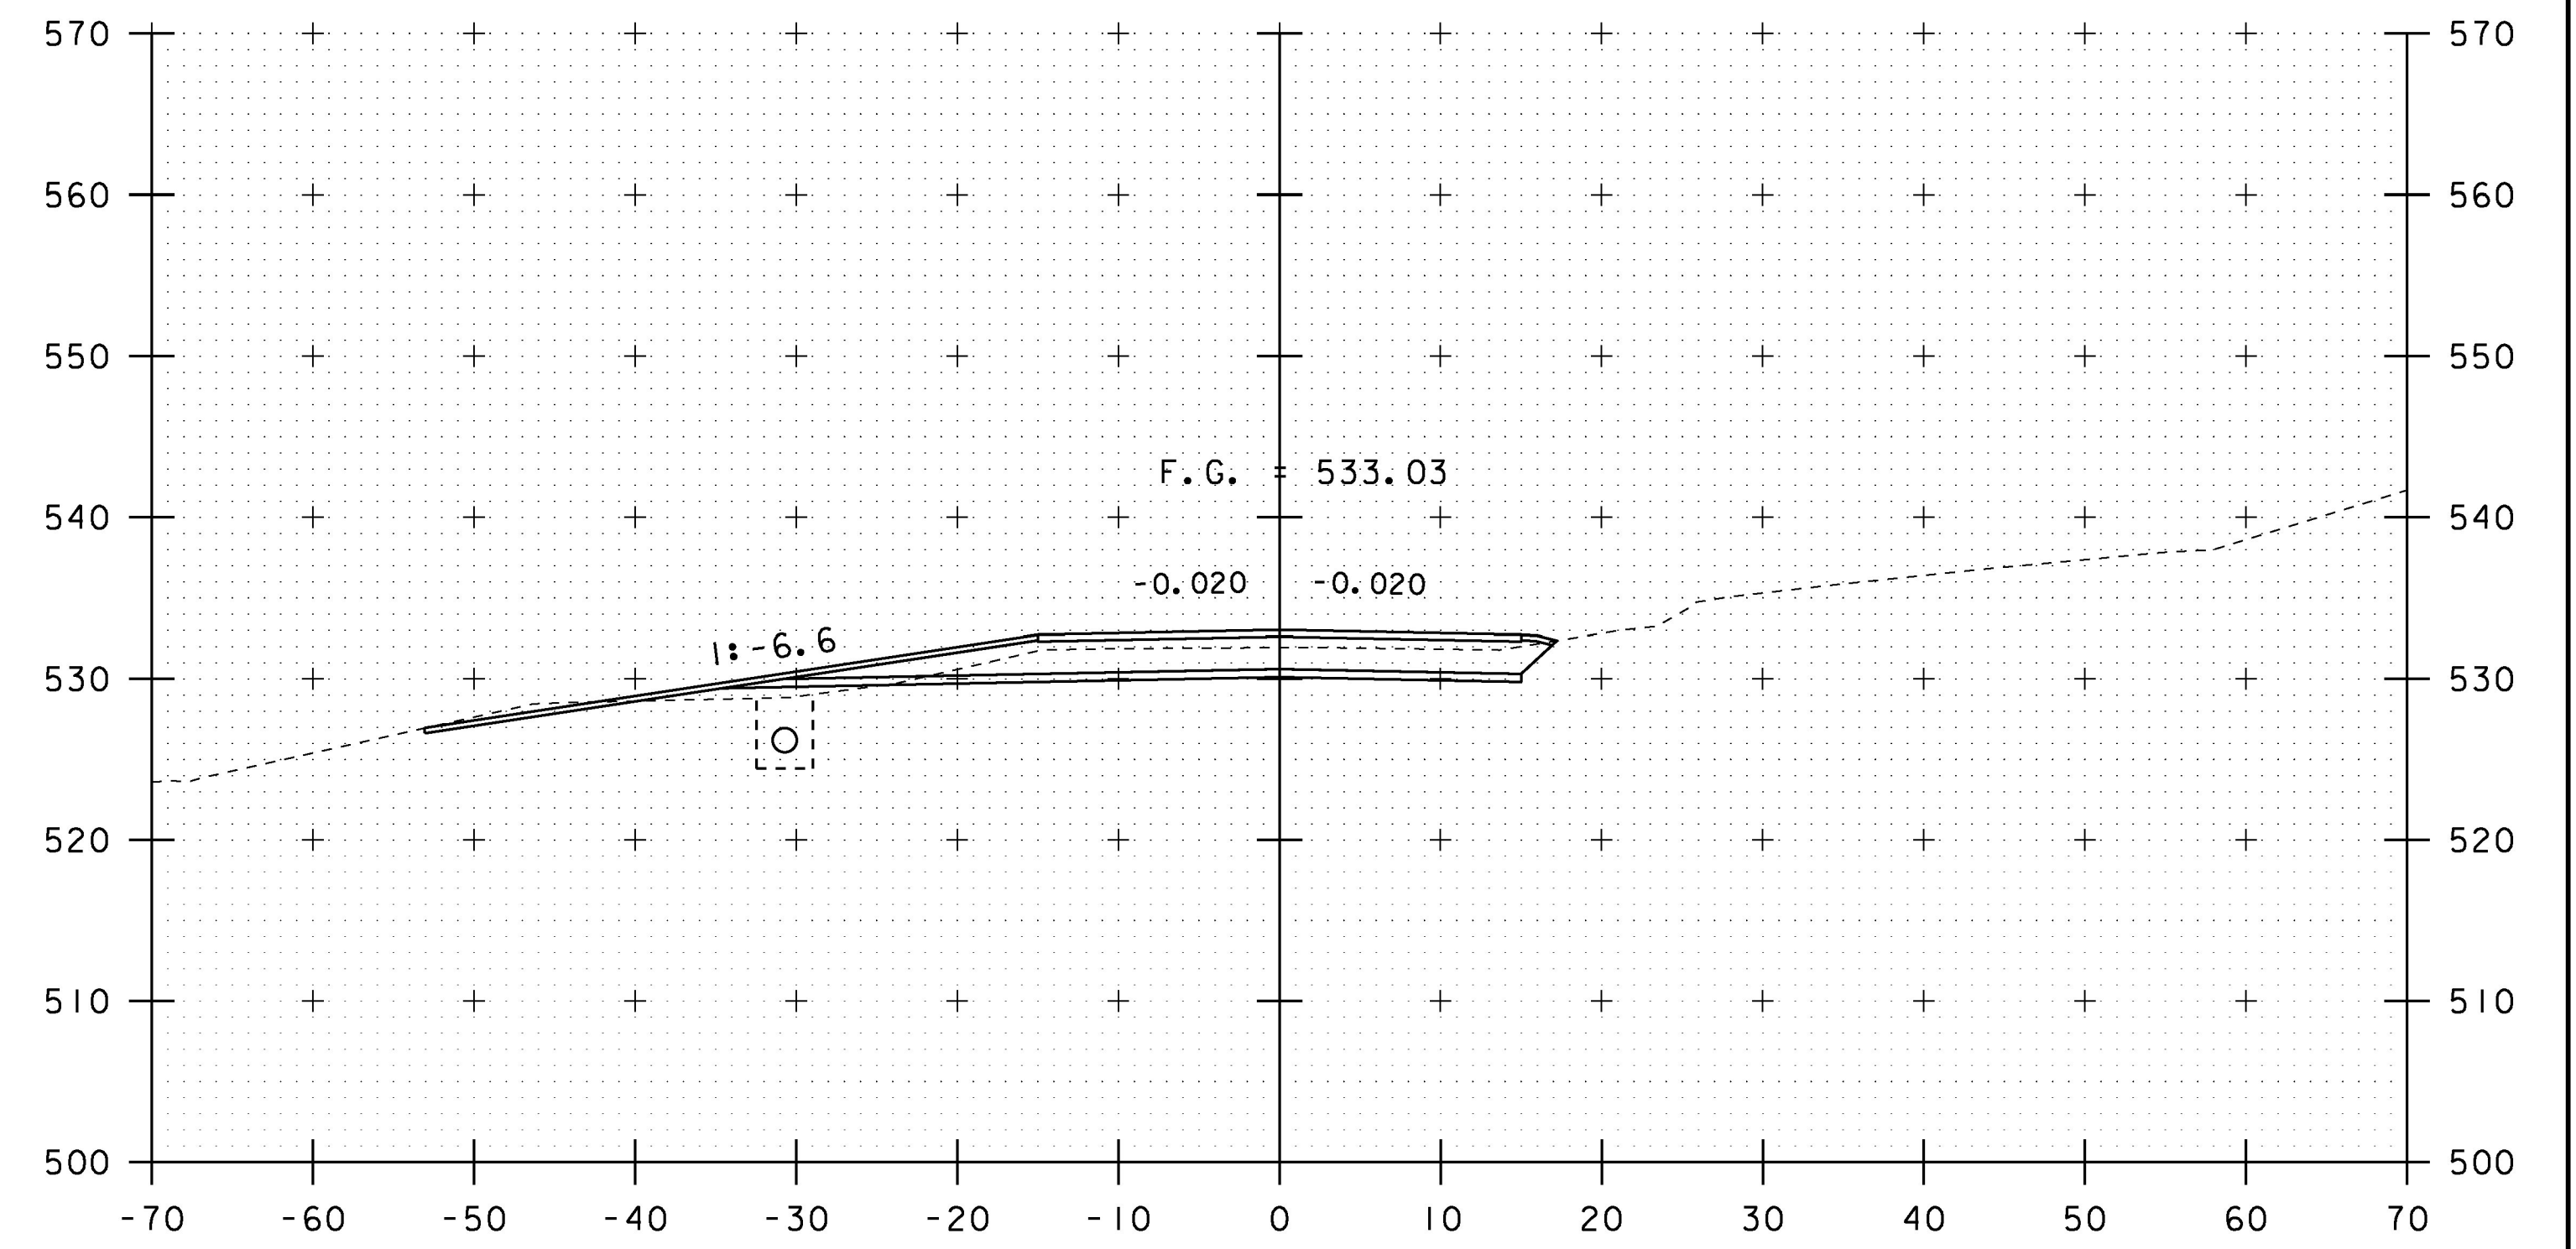

497+00

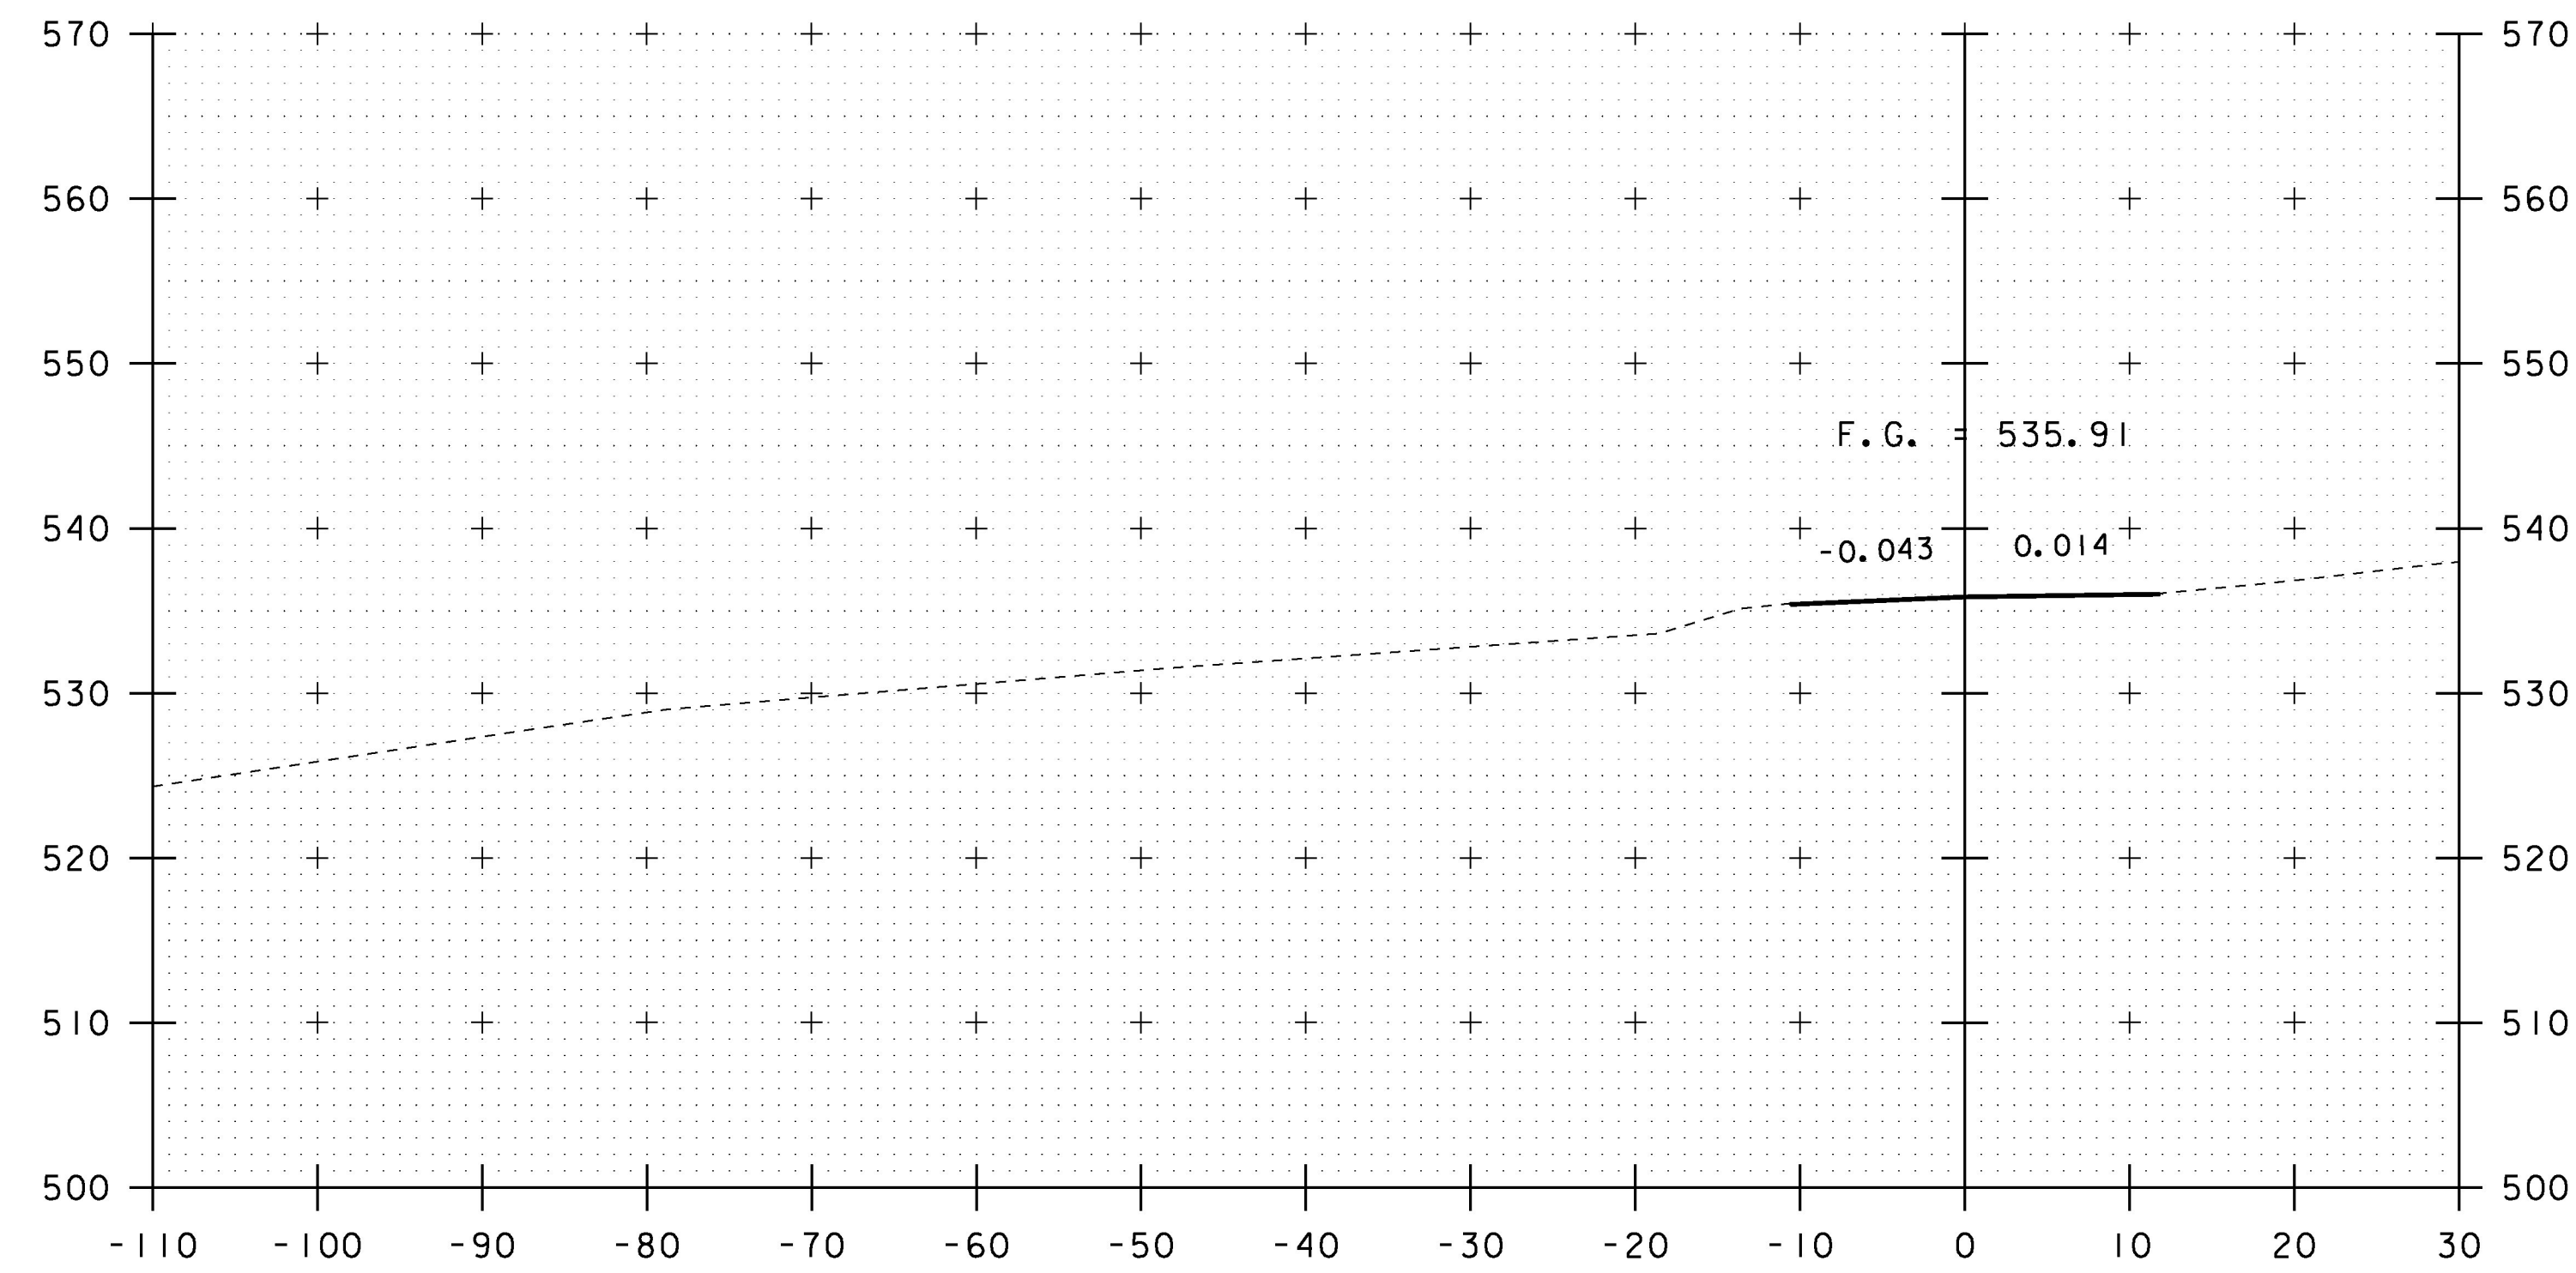

495+59  
BEGIN APPROACH

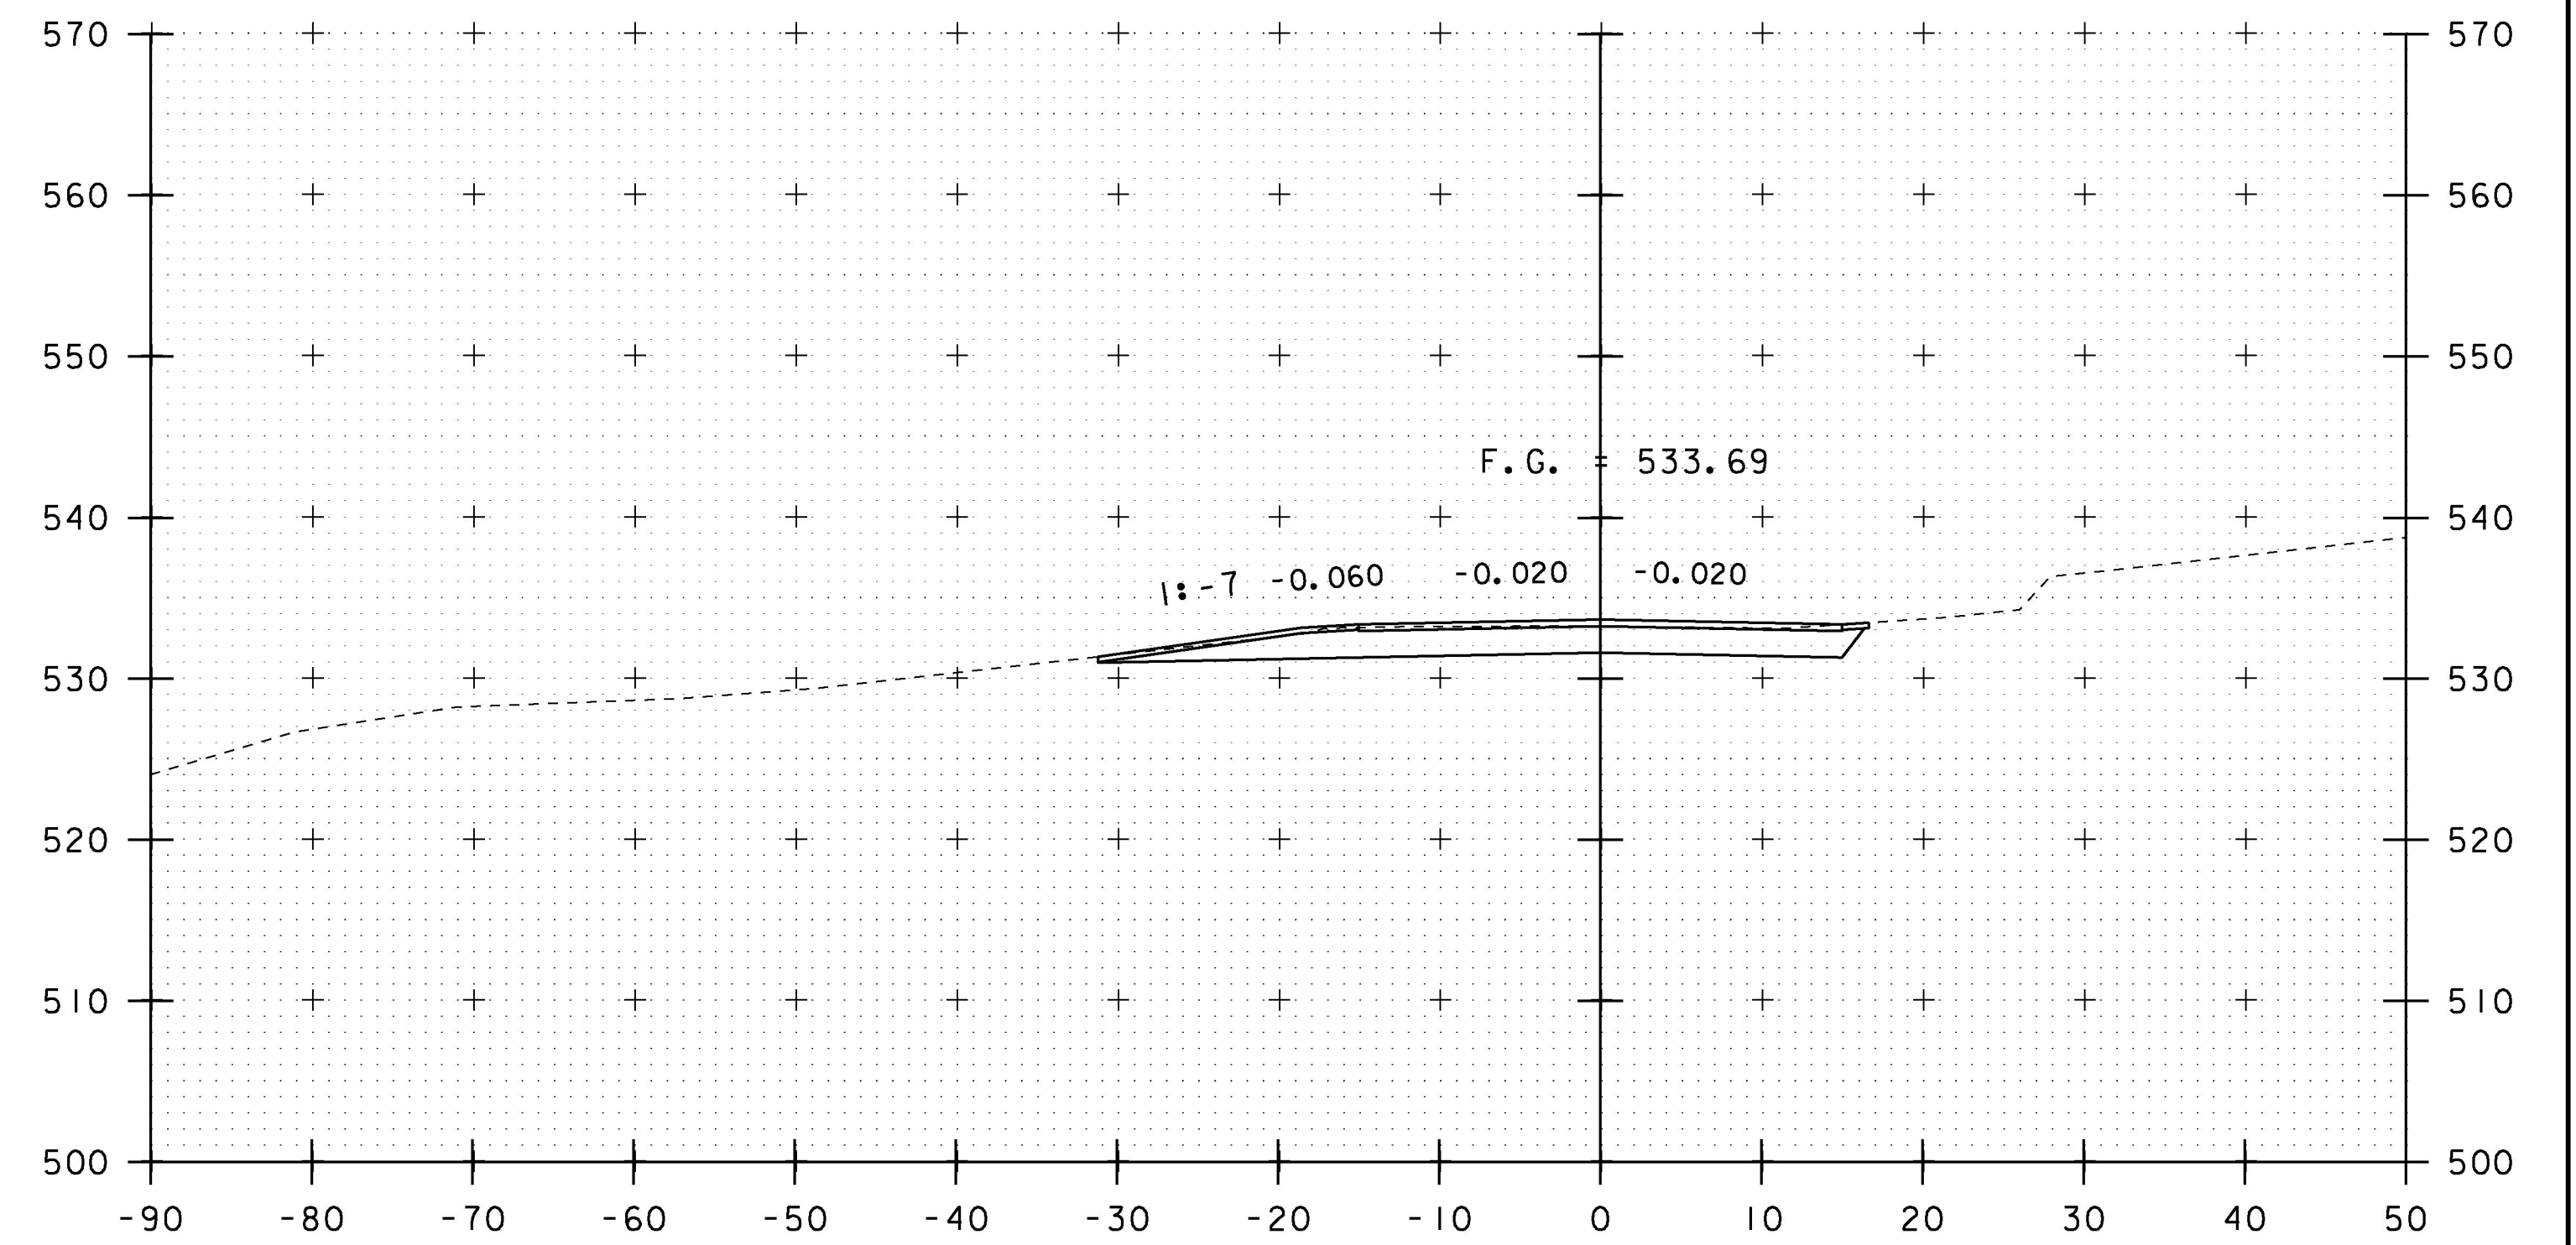

496+50  
BEGIN PROJECT 496+59

STA. 495+59 TO STA. 497+00

PROJECT NAME:	RUTLAND CITY	PLOT DATE:	08-JUL-2014
PROJECT NUMBER:	BRF 3000 (16)	DRAWN BY:	M.LONGSTREET
FILE NAME:	s94j092xs.dgn	DESIGNED BY:	M.EVANS-MONGEON
PROJECT LEADER:	C. CARLSON	CHECKED BY:	EVANS-MONGEON
TH 10 CROSS SECTION SHEET 1		SHEET	208 OF 245