



503+00

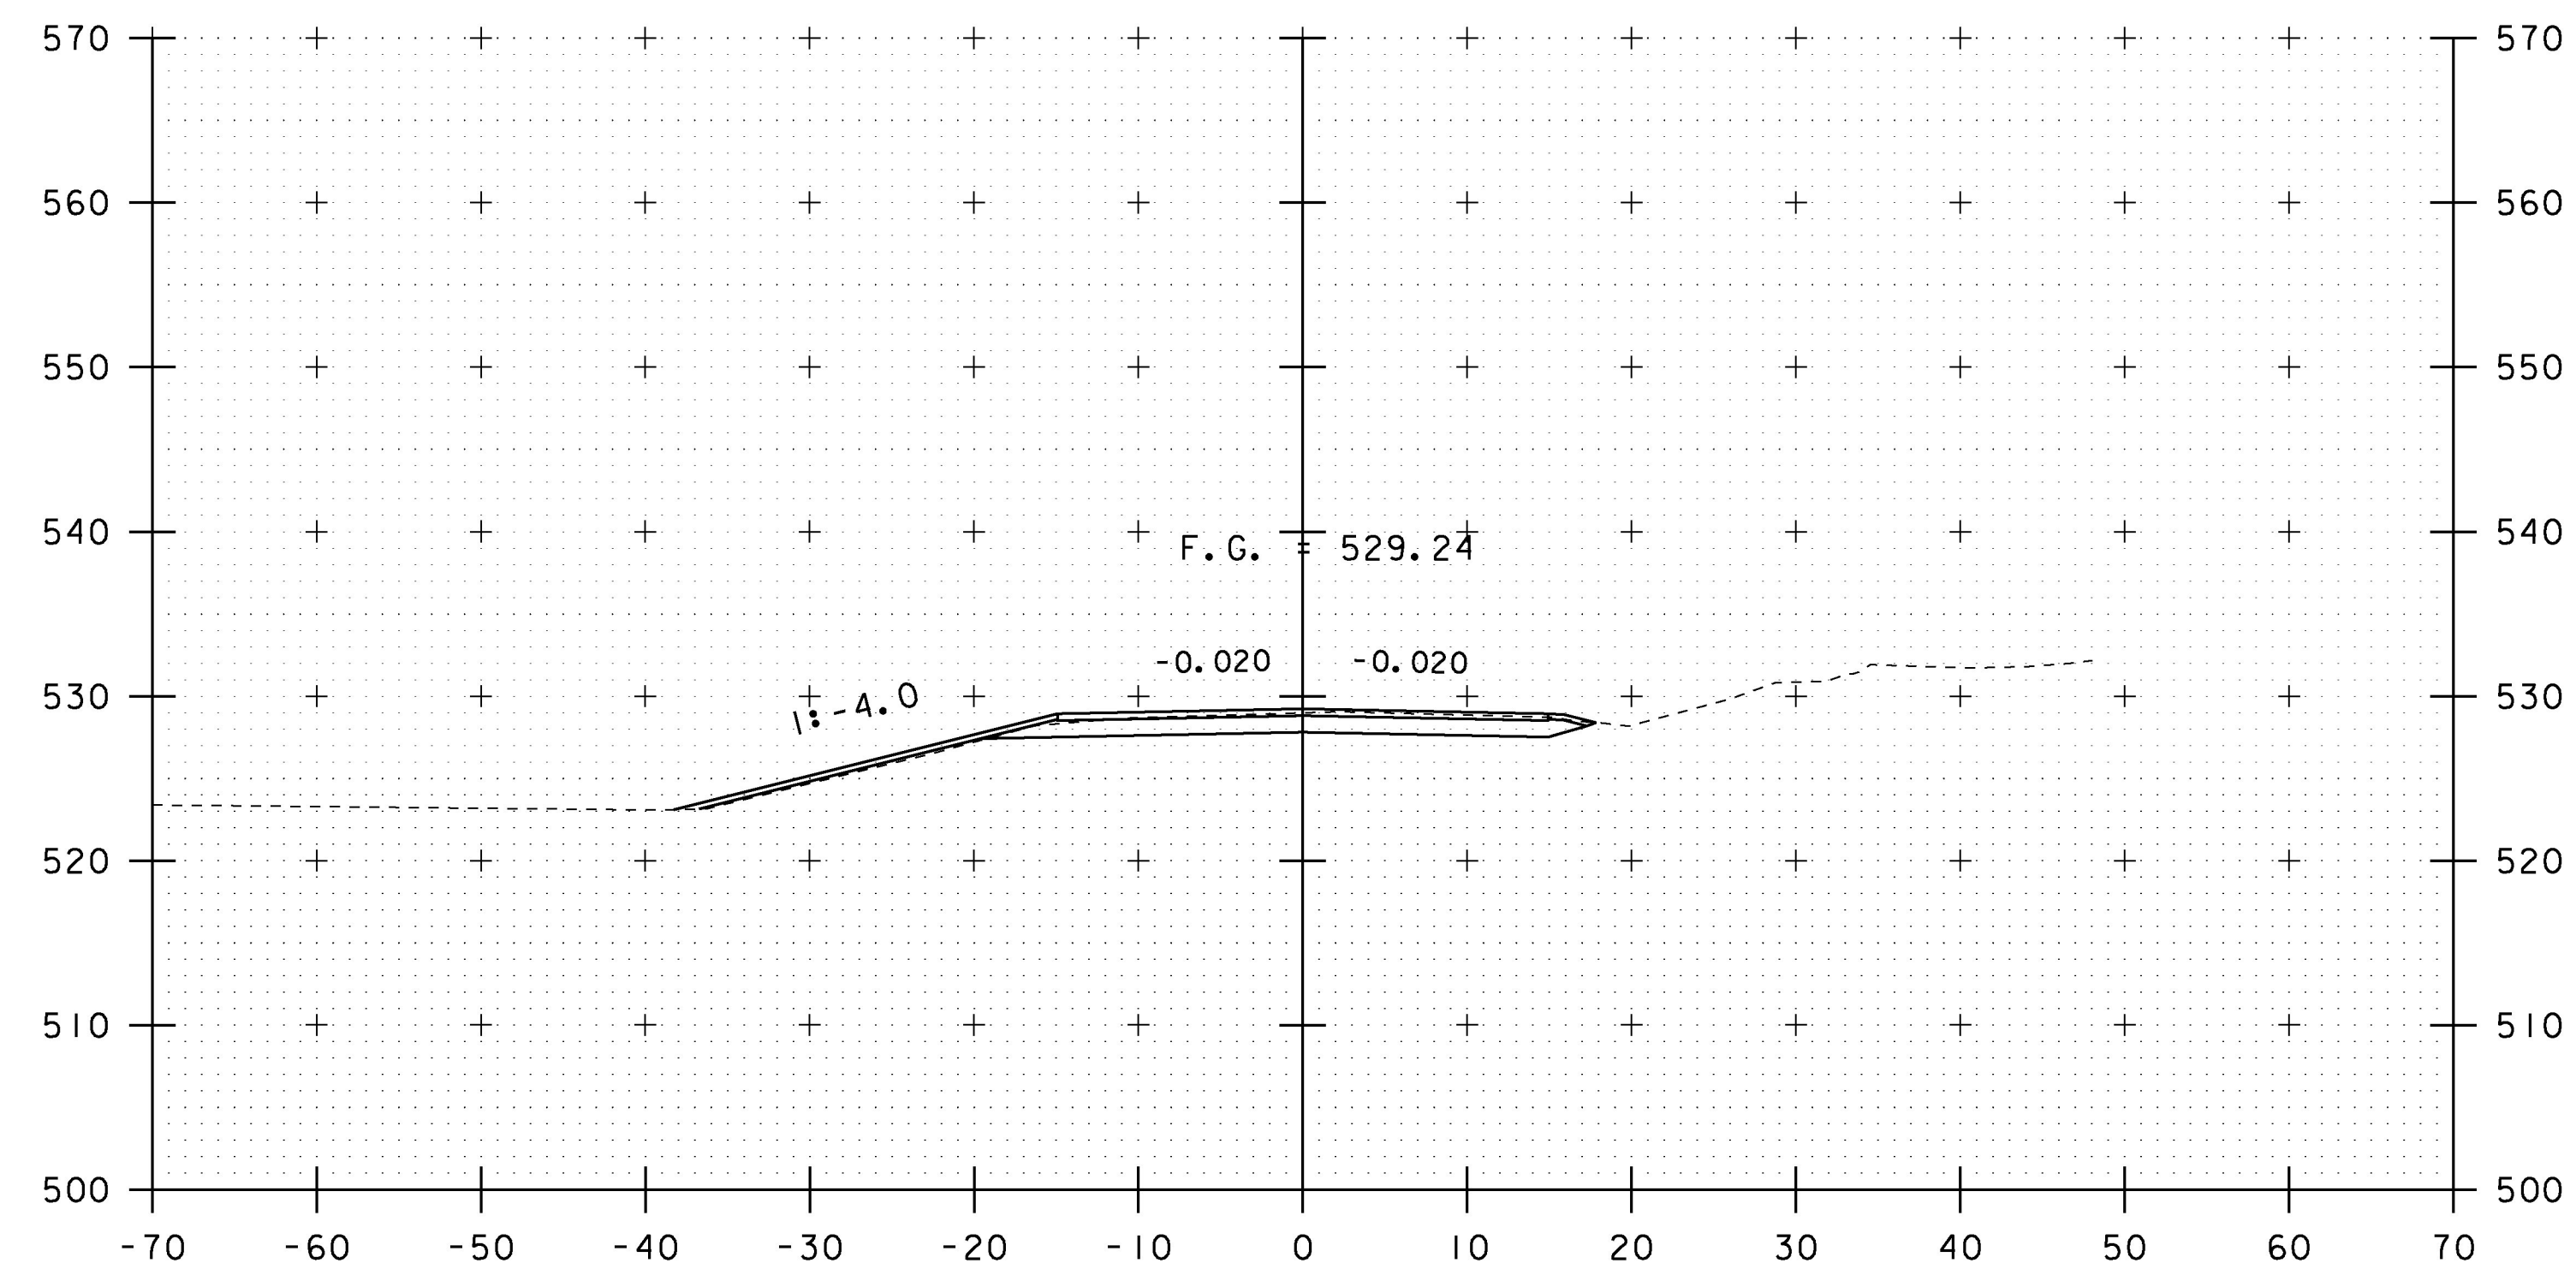

502+50

STA. 502+35.00 RIGHT
 END STRUCTURE EXCAVATION
 END GRANULAR BACKFILL FOR STRUCTURES
 END DRY MASONRY

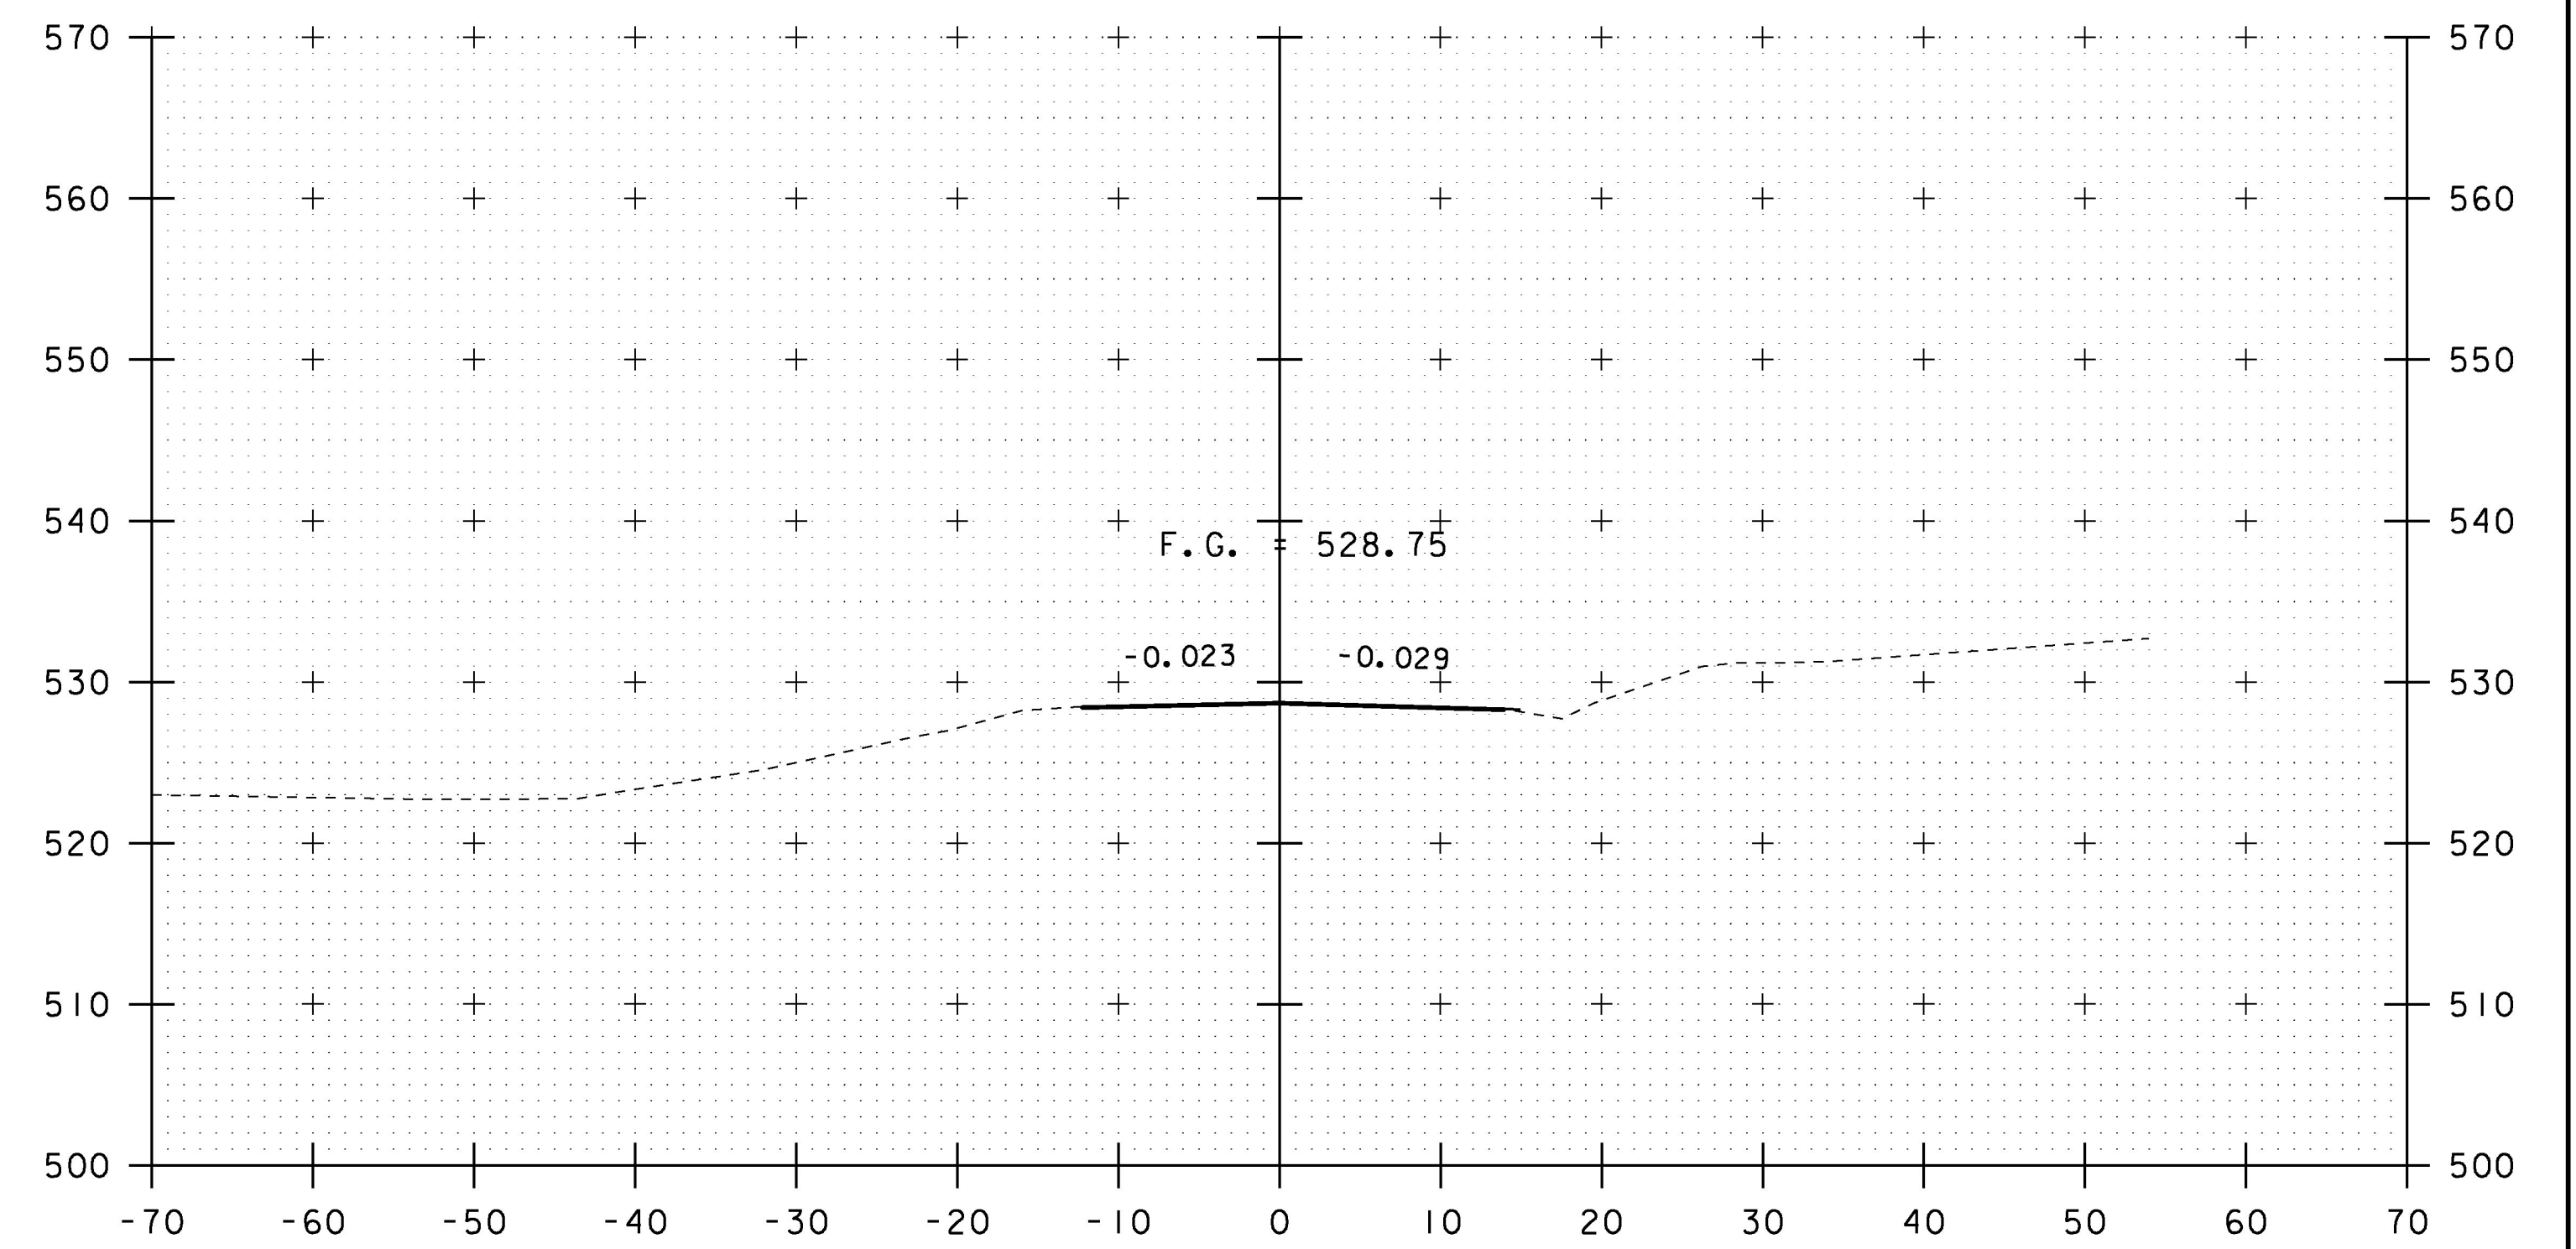

503+25
 END APPROACH

PROJECT NAME: RUTLAND CITY	PLOT DATE: 08-JUL-2014
PROJECT NUMBER: BRF 3000 (16)	DRAWN BY: M.LONGSTREET
FILE NAME: s94j092xs.dgn	CHECKED BY: EVANS-MONGEON
PROJECT LEADER: C. CARLSON	TH 10 CROSS SECTION SHEET 5
DESIGNED BY: M.EVANS-MONGEON	SHEET 212 OF 245

STA. 502+50 TO STA. 503+25