


501+93 ASKEW 18 DEG. LT

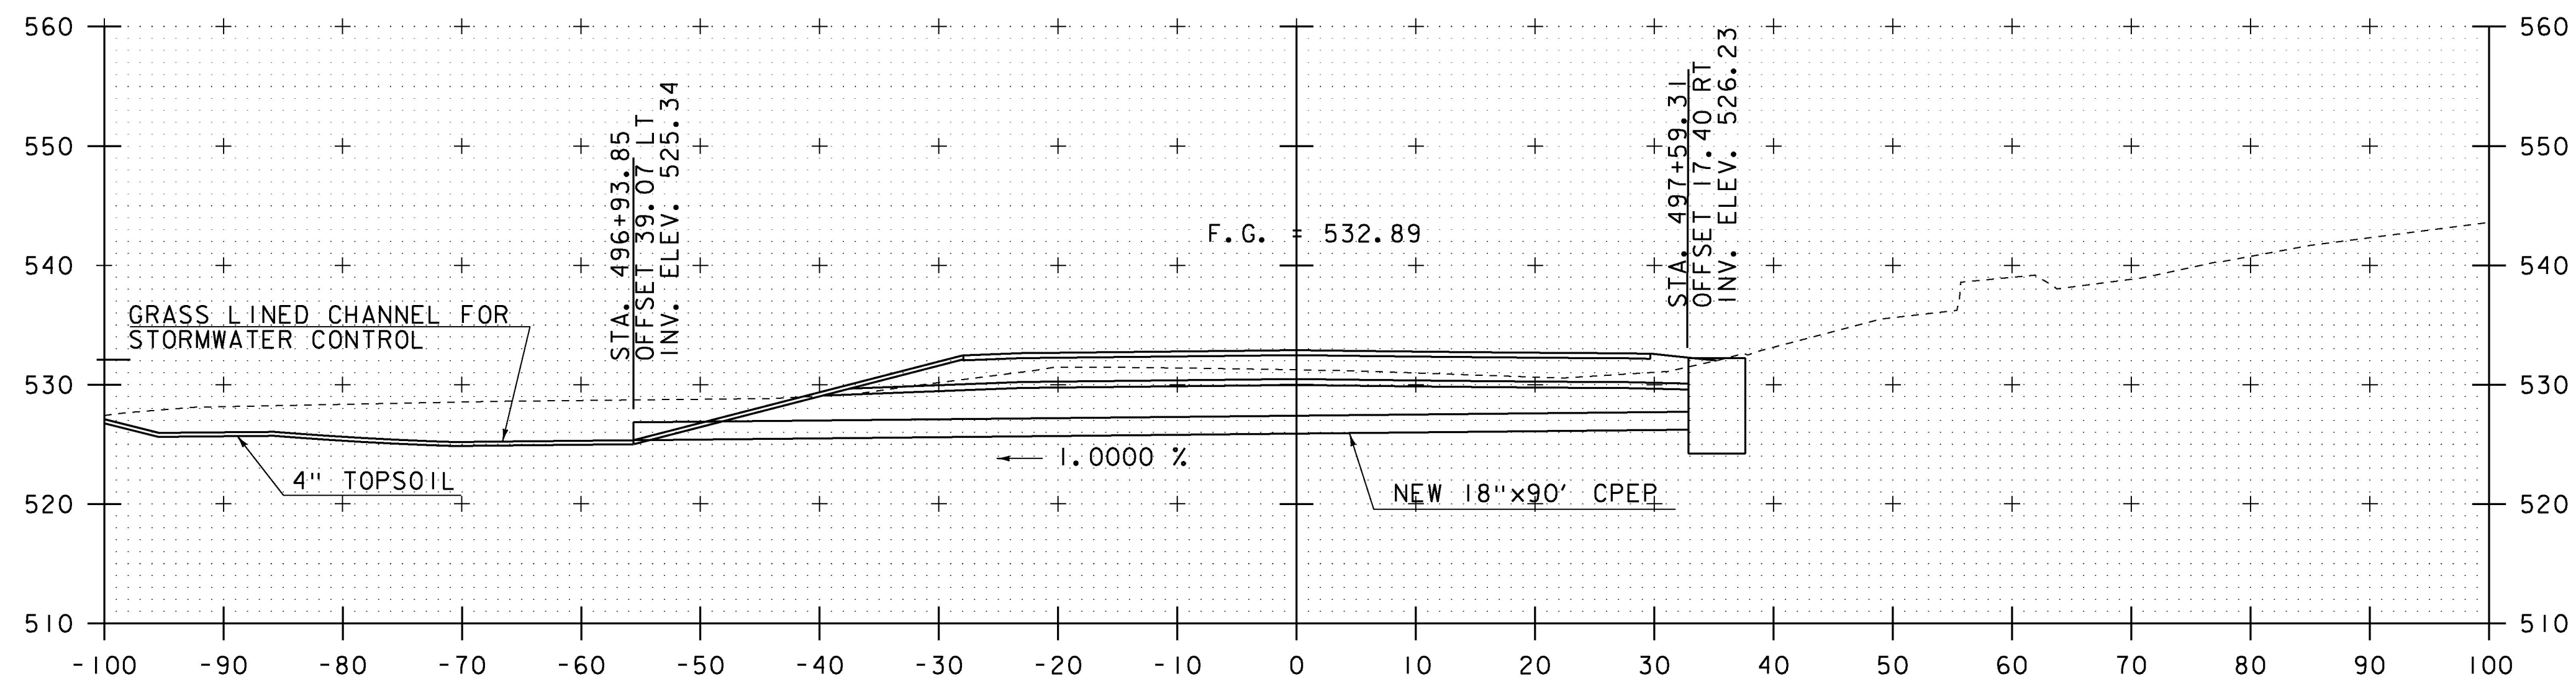

497+30 ASKEW 52.5 DEG. LT

STA. 497+30 AND 501+93

PROJECT NAME:	RUTLAND CITY
PROJECT NUMBER:	BRF 3000 (16)
FILE NAME:	s94j092xs.dgn
PROJECT LEADER:	C. CARLSON
DESIGNED BY:	M. EVANS-MONGEON
TH 10 PIPE PROFILES	
PLOT DATE:	08-JUL-2014
DRAWN BY:	M. LONGSTREET
CHECKED BY:	EVANS-MONGEON
SHEET	213 OF 245