


STA. 70+67 LT  
 BEGIN UNCLASSIFIED CHANNEL EXCAVATION  
 BEGIN STONE FILL, TYPE III  
 BEGIN GEOTEXTILE UNDER STONE FILL  
 BEGIN GRUBBING MATERIAL

70+75

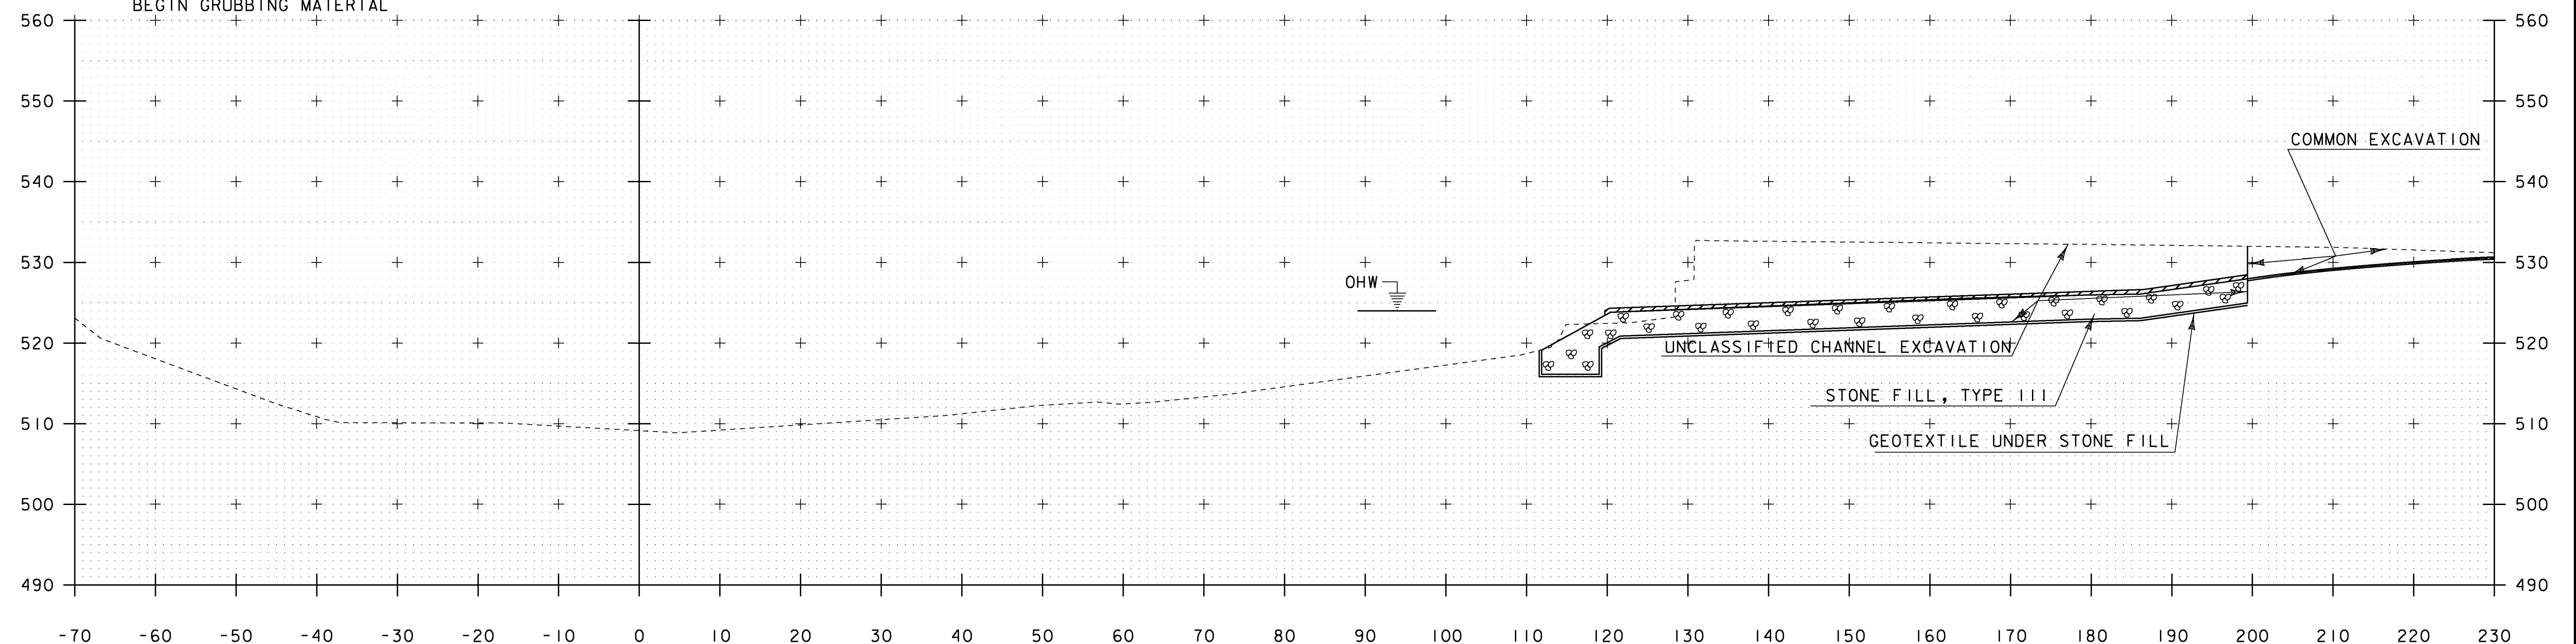

70+50

SCALE 1" = 10'  
STA. 70+50 TO STA. 70+75

PROJECT NAME:	RUTLAND CITY	PLOT DATE:	08-JUL-2014
PROJECT NUMBER:	BRF 3000 (16)	DRAWN BY:	M.LONGSTREET
FILE NAME:	s94j092xs.dgn	DESIGNED BY:	M.EVANS-MONGEON
PROJECT LEADER:	C. CARLSON	CHECKED BY:	EVANS-MONGEON
CHANNEL CROSS SECTION SHEET 2		SHEET	218 OF 245