


72+25

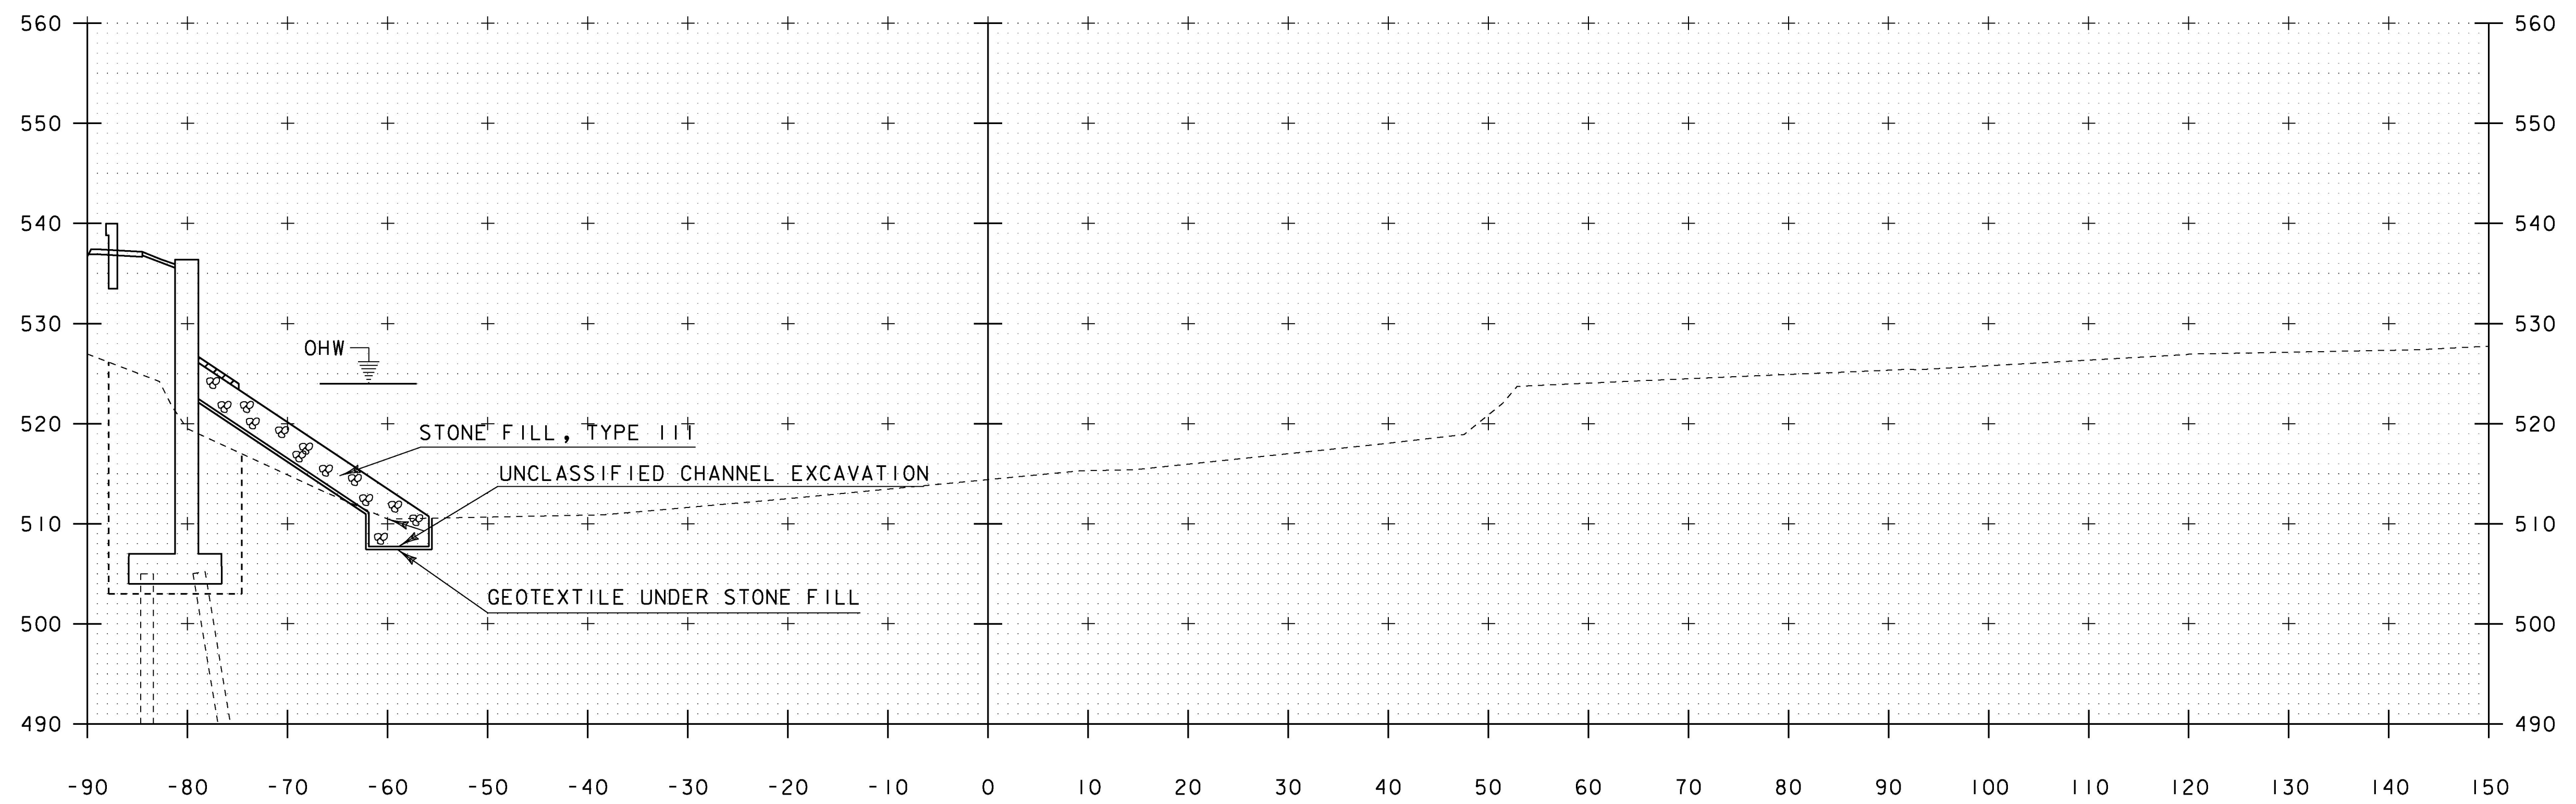

72+00

STA. 71+86 LT
BEGIN GRUBBING MATERIAL

PROJECT NAME:	RUTLAND CITY	PLOT DATE:	08-JUL-2014
PROJECT NUMBER:	BRF 3000 (16)	DRAWN BY:	M.LONGSTREET
FILE NAME:	s94j092xs.dgn	DESIGNED BY:	M.EVANS-MONGEON
PROJECT LEADER:	C. CARLSON	CHECKED BY:	EVANS-MONGEON
CHANNEL CROSS SECTION SHEET 5			SHEET 221 OF 245

SCALE 1" = 10'
STA. 72+00 TO STA. 72+25