

BOX BEAM GUARDRAIL
STA. 497+23.41 TO 499+25 LT

CAST-IN-PLACE CONCRETE CURB, TYPE B
STA. 497+65 TO 499+25 RT

STONE FILL, TYPE III
STA. 497+50 TO 499+25 LT

GEOTEXTILE UNDER STONE FILL
STA. 497+50 TO 499+25 LT

GRUBBING MATERIAL
STA. 497+50 TO 499+25 LT

UNCLASSIFIED CHANNEL EXCAVATION
STA. 497+50 TO 499+25 LT

DRY MASONRY
STA. 497+20 TO 497+28 RT
STA. 497+51 TO 497+85 RT
STA. 498+40 TO 498+86 RT
STA. 499+00 TO 499+25 RT


SPECIAL PROVISION (GATE FOR ORNAMENTAL FENCE, 4 FEET)
STA. 497+29 TO 497+50 RT

CONSTRUCT PAVED DRIVE
STA. 497+23 TO 497+57 RT

RELOCATE MAILBOX, SINGLE SUPPORT
STA 496+76 LT

TH 10 STA. 496+94 LT TO 497+62 RT
NEW 18" X 90' CAAP, PCCSP OR CPEP
W/ STONE FILL TYPE I AT OUTLET
DI AT INLET

TH 10 STA. 496+94 LT TO 497+62 RT
NEW 18" X 90' CAAP, PCCSP OR CPEP
W/ STONE FILL TYPE I AT OUTLET
DI AT INLET

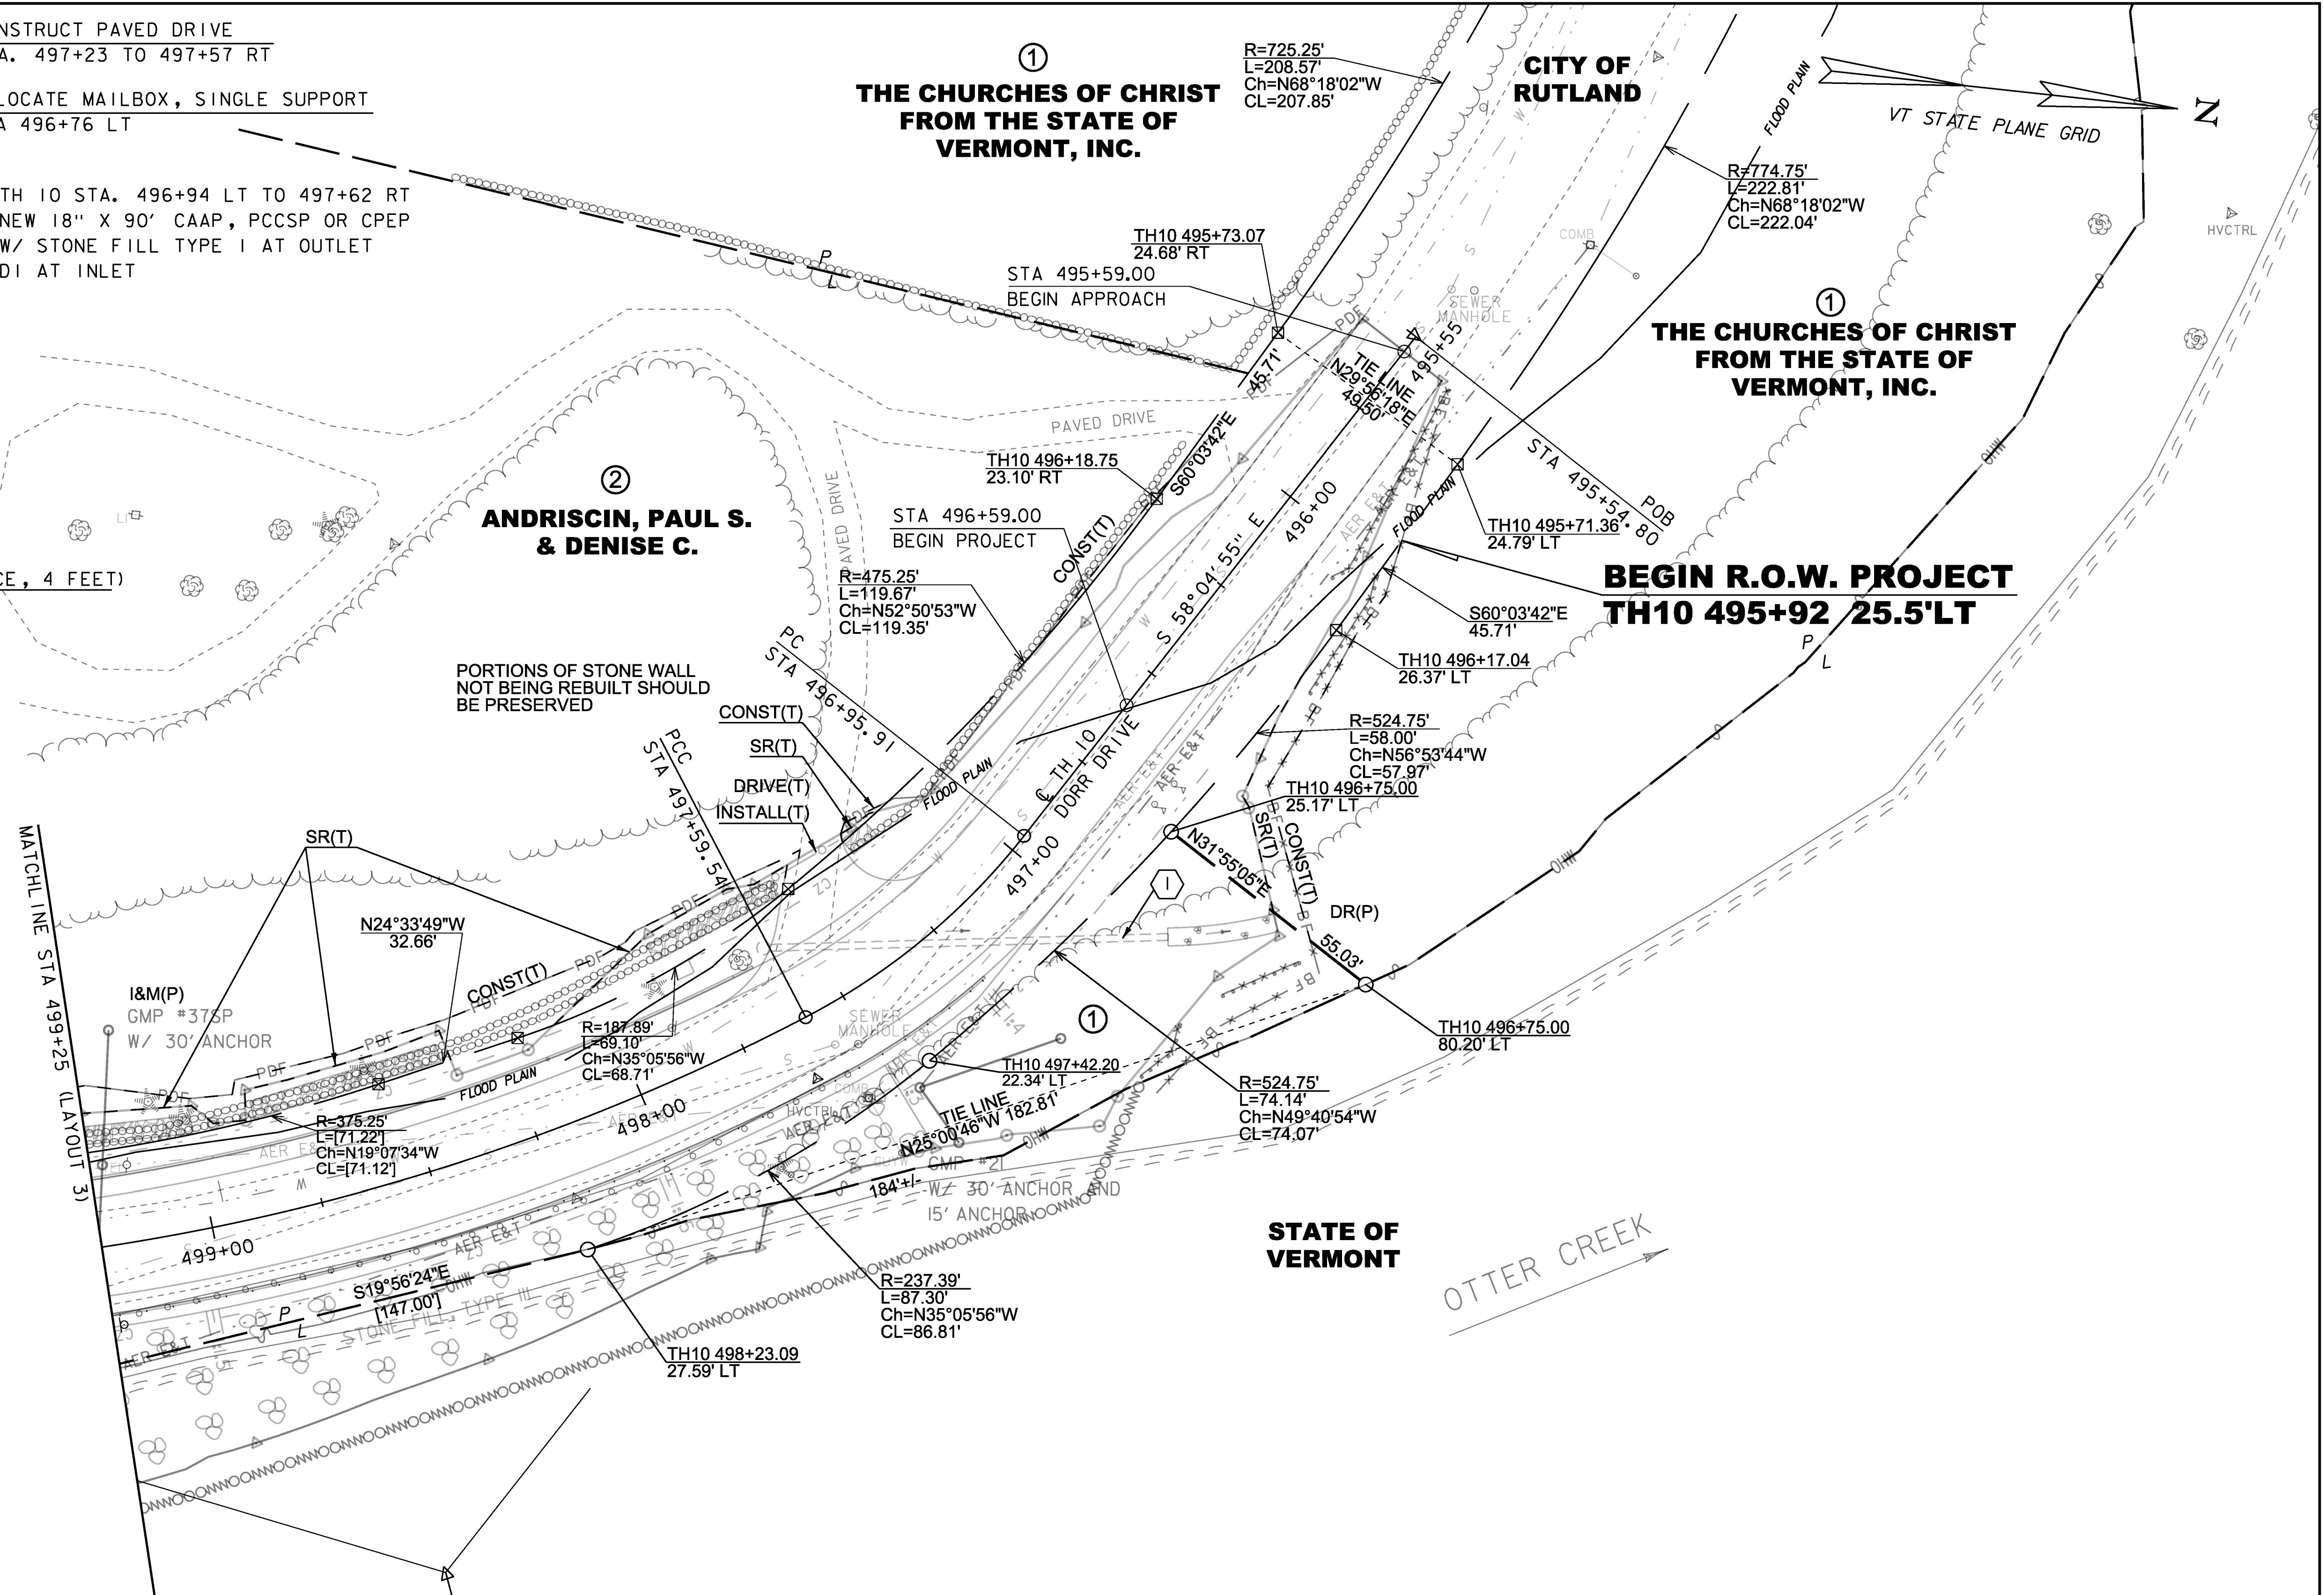

TH 10 CURVE (1)
 $\Delta = 68^{\circ}27'08''$ RT
 $D = 38^{\circ}11'50''$ (1) $D = 11^{\circ}27'33''$ (2)
 $R = 150.00'$ (1) $R = 500.00'$ (2)
 $T = 208.32'$ (1) $T = 306.78'$ (2)
 $L = 63.63'$ (1) $L = 385.25'$ (2)
 $E = 106.71'$

THIS PROJECT SUBJECT TO
STORMWATER PERMIT 704I-INDS

LINES SHOWN ON THIS PLAN AS EXISTING
PROPERTY LINES P/L ARE BELIEVED TO
BE ACCURATE BUT SHOULD NOT BE RELIED
UPON FOR PURPOSES UNRELATED TO THE
CITY OF RUTLAND'S ACQUISITION OF LAND
AND RIGHTS FOR THIS PROJECT.

**FOR R.O.W.
USE ONLY**

OTTER CREEK

SCALE 1" = 20'-0"
20 0 20

PROJECT NAME:	RUTLAND CITY	FILE NAME:	r94j092lay1.dgn	PLOT DATE:	03-JUL-2014
PROJECT NUMBER:	BRF 3000 (16)	PROJECT LEADER:	C. CARLSON	DRAWN BY:	E. PIERCE
		DESIGNED BY:	M. EVANS-MONGEON	CHECKED BY:	R. CLOUTIER
		ROW LAYOUT SHEET 1 OF 4		SHEET	242 OF 245