

SPECIAL PROVISION (DUCTILE IRON PIPE, CEMENT-LINED, ALL-INCLUSIVE) (10" WATER)
 103+47.7 RT TO 104+50.0 RT
 499+25.0 RT TO 501+30.0 RT
 500+14.6 RT TO 100+26.7 RT

SPECIAL PROVISION (DUCTILE IRON PIPE, CEMENT-LINED, ALL-INCLUSIVE) (10" WATER ON BRIDGE)
 100+51.7 TO 103+22.6 RT

SPECIAL PROVISION (DUCTILE IRON PIPE, CEMENT-LINED, ALL-INCLUSIVE) (10" WATER IN CASING)
 100+26.7 TO 100+51.7 RT
 103+22.7 TO 103+47.7 RT

SPECIAL PROVISION (DUCTILE IRON PIPE, CEMENT-LINED, ALL-INCLUSIVE) (6" WATER)
 500+90.0 RT

GATE VALVE WITH VALVE BOX

103+87.8 RT (10")
 500+00.0 RT (10")
 500+14.6 RT (10")
 500+24.4 RT (10")
 500+90.0 RT (6")

REMOVE HYDRANT
 500+64.2 RT

HYDRANT
 500+90.0 RT

EXPANSION ASSEMBLY (10" WATER)
 103+15 RT

SPECIAL PROVISION (DUCTILE IRON PIPE, CEMENT-LINED, ALL-INCLUSIVE) (10" SEWER)
 499+25.0 TO 499+48.0 LT
 499+52.0 TO 501+30.0 LT

SPECIAL PROVISION (SDR-35 PVC, ALL-INCLUSIVE) (10" SEWER)
 103+77.0 TO 104+50.0 LT

SPECIAL PROVISION (SDR-35 PVC, ALL-INCLUSIVE) (6" SEWER SERVICE)
 499+48.4 LT/RT

EXPANSION ASSEMBLY (6" FORCE MAIN)
 103+10 LT

SPECIAL PROVISION (DUCTILE IRON PIPE, CEMENT-LINED, ALL-INCLUSIVE) (6" FORCE MAIN)
 103+35.0 LT TO 103+73.0 LT
 501+29.5 LT TO 100+21.1 LT


SPECIAL PROVISION (DUCTILE IRON PIPE, CEMENT-LINED, ALL-INCLUSIVE) (6" FORCE MAIN ON BRIDGE)
 100+43.1 TO 103+13.6 LT

SPECIAL PROVISION (DUCTILE IRON PIPE, CEMENT-LINED, ALL-INCLUSIVE) (6" FORCE MAIN IN CASING)
 100+21.1 TO 100+43.1 LT
 103+13.6 TO 103+35.0 LT


SPECIAL PROVISION (SANITARY MANHOLE, ALL-INCLUSIVE) (4' DIA.)
 103+75.0, 17.8' LT
 499+50.0, 11.4' LT

CAST IRON COVER WITH FRAME, SEWER
 103+75.0 LT
 499+50.0 LT

SPECIAL PROVISION (TRANSITE PIPE REMOVAL)
 102+92.3 TO 104+50.0

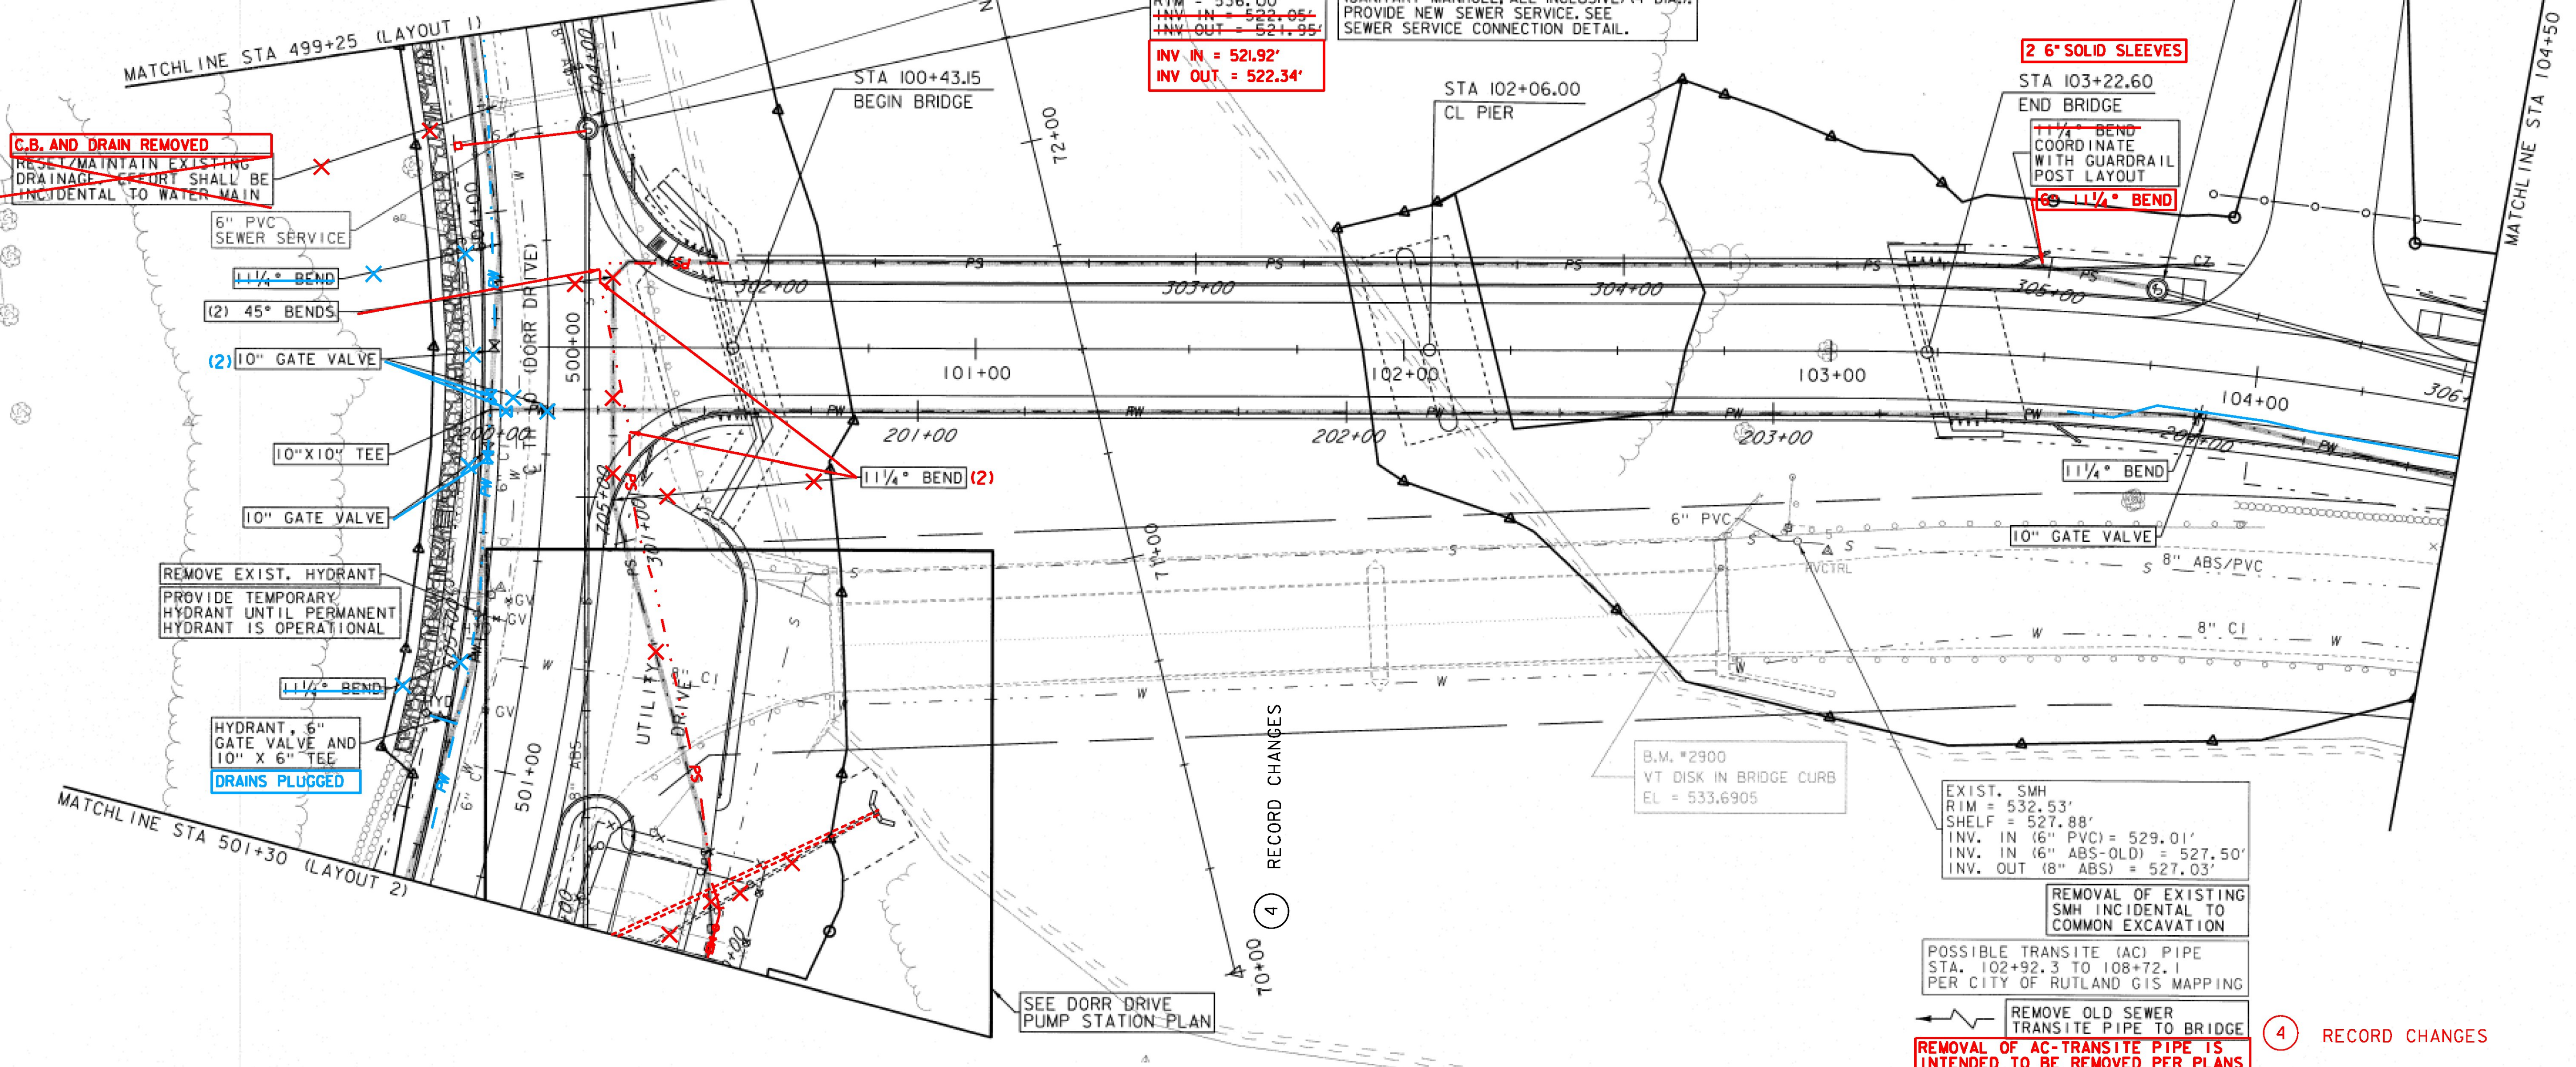

RECORD DRAWING WATER AND SEWER ELEMENTS
 SOME OF THE CONTENT SHOWN ON THESE RECORD DRAWINGS HAS BEEN PREPARED BASED ON INFORMATION FURNISHED BY OTHERS. THE LOCATION OF ITEMS SHOWN WITHOUT LABELED DIMENSIONS SHALL BE CONSIDERED AS APPROXIMATE. MODIFICATIONS TO BRIDGE ELEMENTS ARE NOT ADDRESSED ON THESE RECORD PLANS. THE SITE WAS NOT RE-SURVEYED AFTER CONSTRUCTION, SO RECORD LOCATIONS, ELEVATIONS AND FINISH GRADES ARE APPROXIMATE AND SHALL BE CONSIDERED "SCHEMATIC." DETAILS AND CROSS SECTIONS MAY NOT REFLECT "AS-BUILT" CONDITIONS.

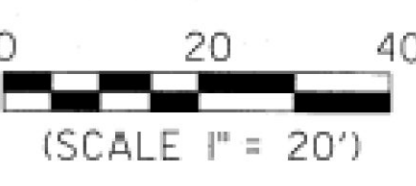

WATER AND SEWER PLANS		PROJECT NAME: RUTLAND CITY	PLOT DATE: 6/17/2014
		PROJECT NUMBER: BRF 3000 (16)	DRAWN BY: W. GORDON
	540 Commercial Street, Manchester, NH 03101 (603) 668-8223 • Fax: (603) 668-9802 clde@cldeengineers.com • www.cldeengineers.com Maine • New Hampshire • Vermont	FILE NAME: z94j092bdrwtrswr.dgn	CHECKED BY: S. REICHERT
		PROJECT LEADER: C. BEAN	SHEET 12 OF 22
		DESIGNED BY: D. LEWIS	WATER/SEWER LAYOUT 3