


RECEIVED
 ON: March 21, 2016
 and Checked for
CONFORMANCE
 BY: ABC DATE:

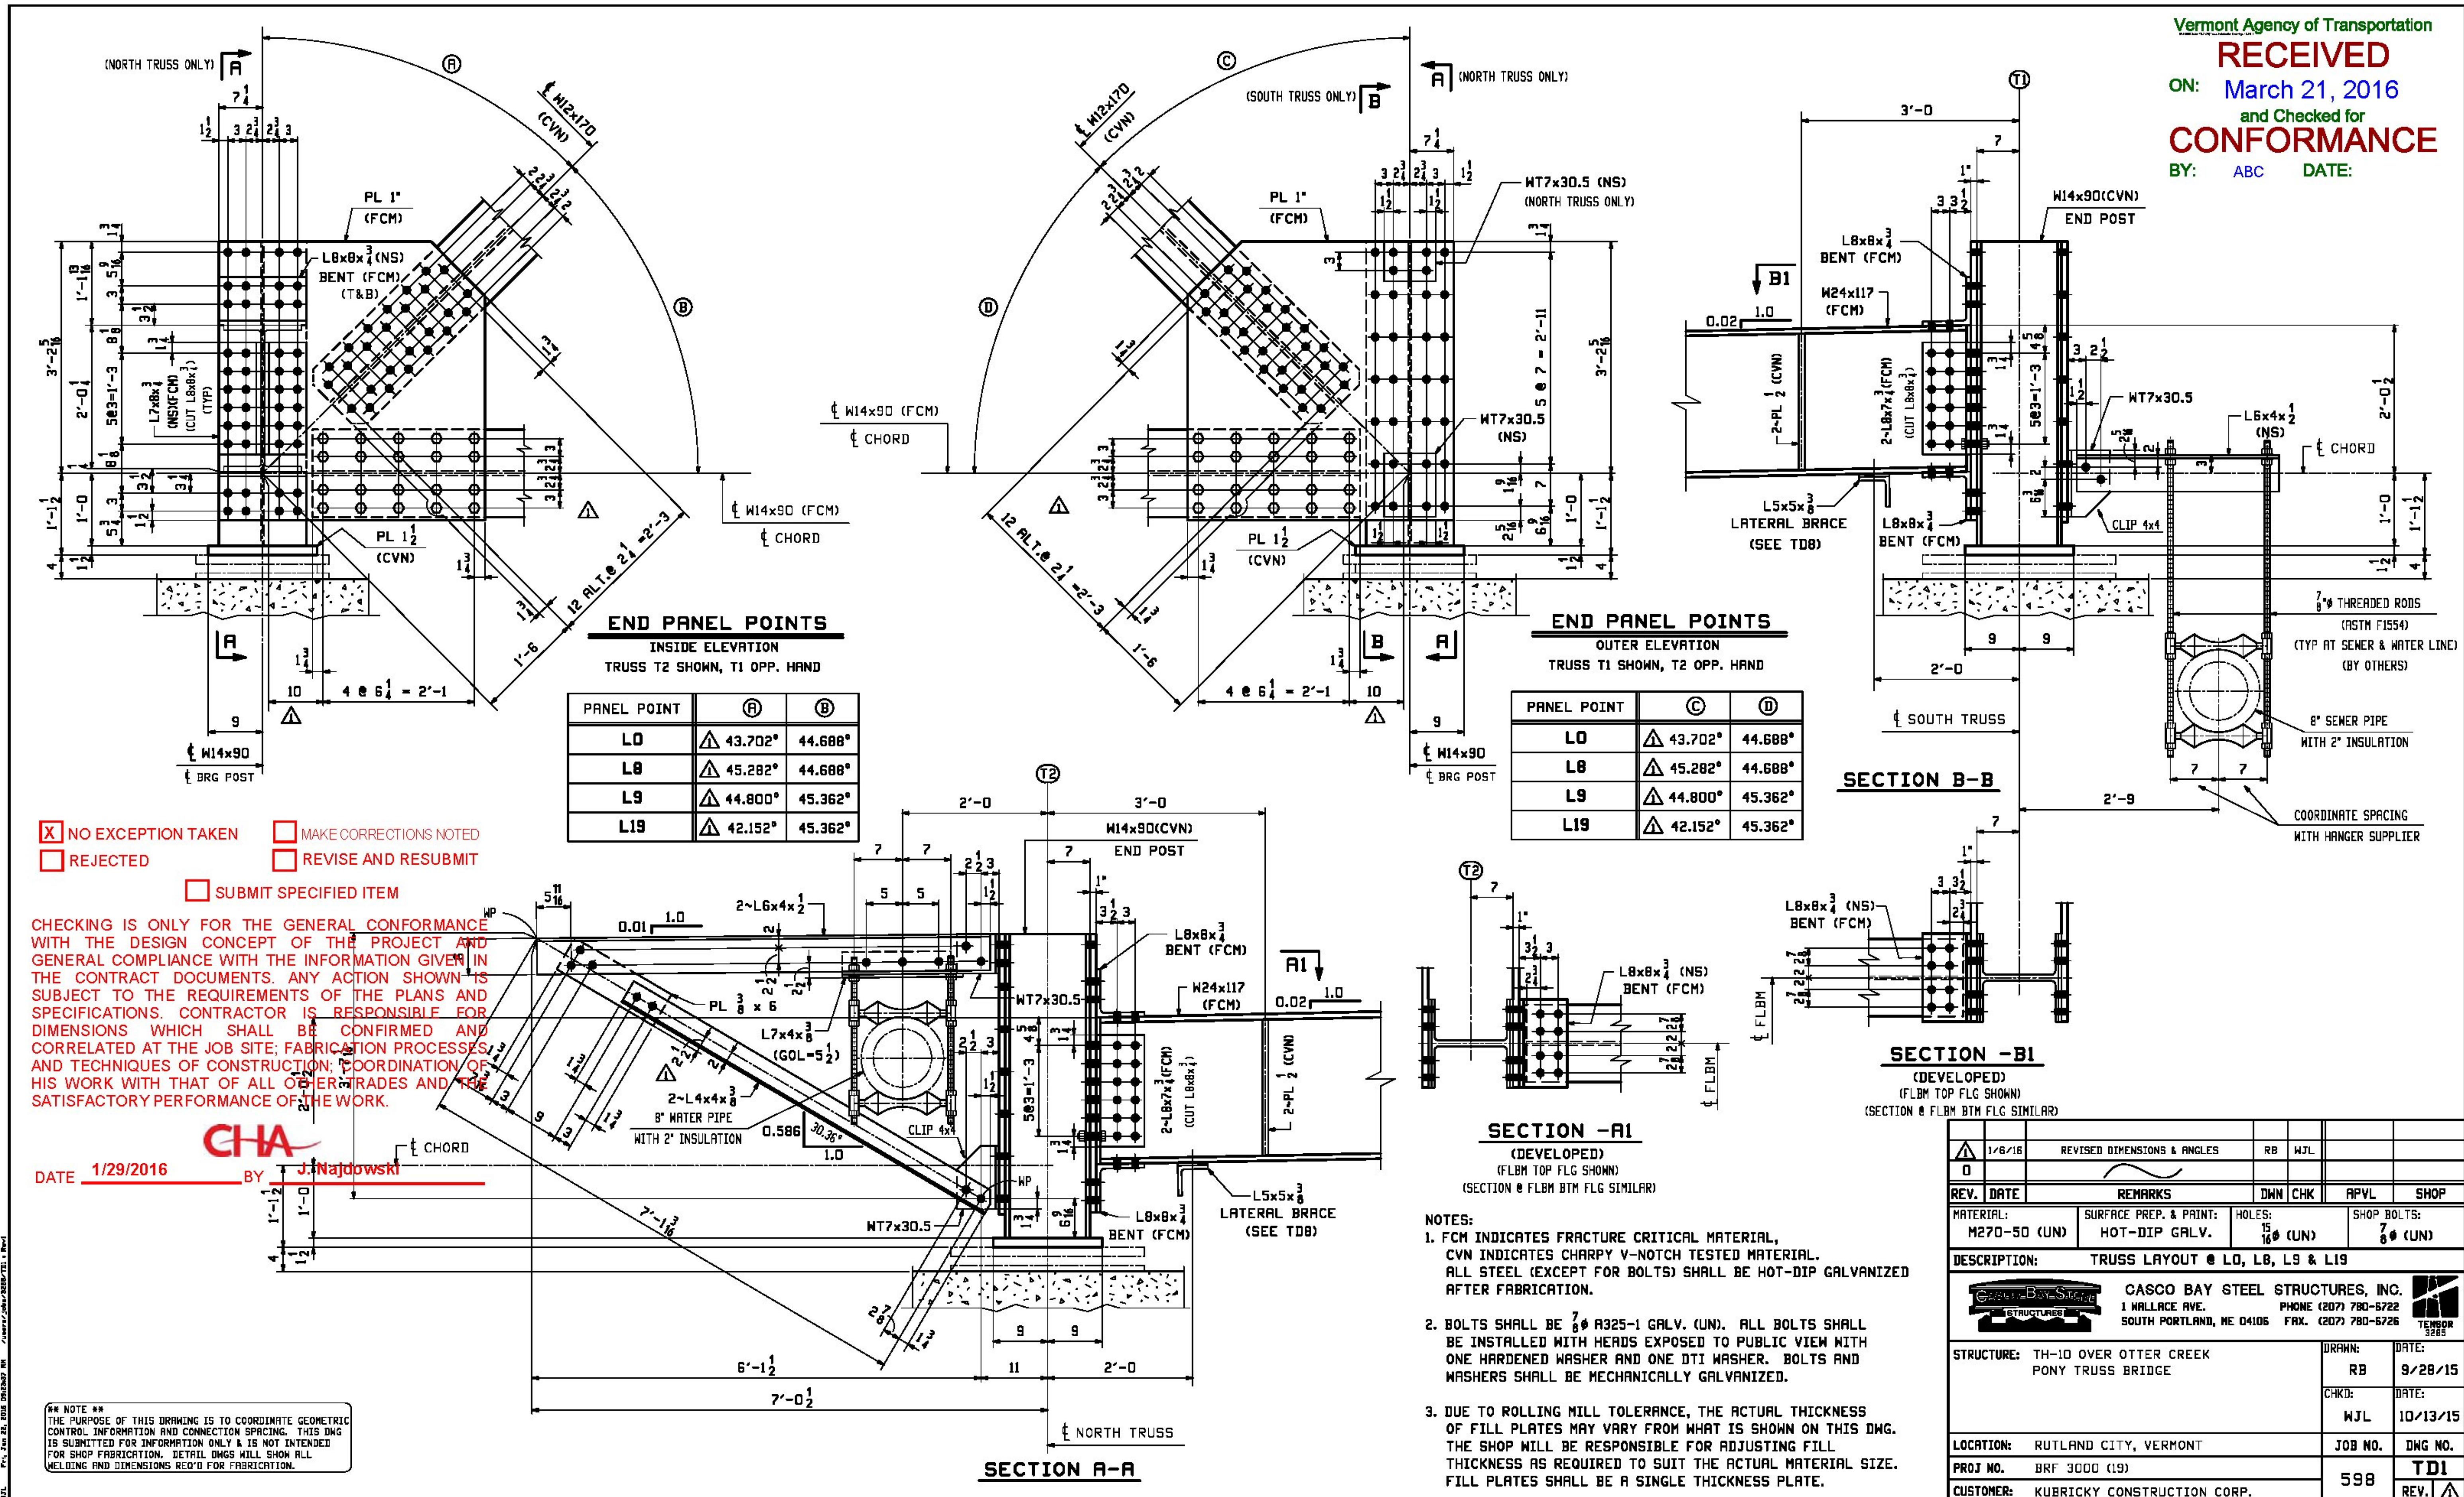

END PANEL POINTS
 INSIDE ELEVATION
 TRUSS T2 SHOWN, T1 OPP. HAND

PANEL POINT	A	B
L0	Δ 43.702°	44.688°
L8	Δ 45.282°	44.688°
L9	Δ 44.800°	45.362°
L19	Δ 42.152°	45.362°

END PANEL POINTS
 OUTER ELEVATION
 TRUSS T1 SHOWN, T2 OPP. HAND

PANEL POINT	C	D
L0	Δ 43.702°	44.688°
L8	Δ 45.282°	44.688°
L9	Δ 44.800°	45.362°
L19	Δ 42.152°	45.362°

- NO EXCEPTION TAKEN
- MAKE CORRECTIONS NOTED
- REJECTED
- REVISE AND RESUBMIT
- SUBMIT SPECIFIED ITEM

CHECKING IS ONLY FOR THE GENERAL CONFORMANCE WITH THE DESIGN CONCEPT OF THE PROJECT AND GENERAL COMPLIANCE WITH THE INFORMATION GIVEN IN THE CONTRACT DOCUMENTS. ANY ACTION SHOWN IS SUBJECT TO THE REQUIREMENTS OF THE PLANS AND SPECIFICATIONS. CONTRACTOR IS RESPONSIBLE FOR DIMENSIONS WHICH SHALL BE CONFIRMED AND CORRELATED AT THE JOB SITE; FABRICATION PROCESSES AND TECHNIQUES OF CONSTRUCTION; COORDINATION OF HIS WORK WITH THAT OF ALL OTHER TRADES AND THE SATISFACTORY PERFORMANCE OF THE WORK.

CHA

DATE 1/29/2016 BY J. Najdowski

NOTE: THE PURPOSE OF THIS DRAWING IS TO COORDINATE GEOMETRIC CONTROL INFORMATION AND CONNECTION SPACING. THIS DWG IS SUBMITTED FOR INFORMATION ONLY & IS NOT INTENDED FOR SHOP FABRICATION. DETAIL DWGS WILL SHOW ALL WELDING AND DIMENSIONS REQUIRED FOR FABRICATION.

- NOTES:
- FCM INDICATES FRACTURE CRITICAL MATERIAL, CVN INDICATES CHARPY V-NOTCH TESTED MATERIAL. ALL STEEL (EXCEPT FOR BOLTS) SHALL BE HOT-DIP GALVANIZED AFTER FABRICATION.
 - BOLTS SHALL BE 7/8" A325-1 GALV. (UN). ALL BOLTS SHALL BE INSTALLED WITH HEADS EXPOSED TO PUBLIC VIEW WITH ONE HARDENED WASHER AND ONE DTI WASHER. BOLTS AND WASHERS SHALL BE MECHANICALLY GALVANIZED.
 - DUE TO ROLLING MILL TOLERANCE, THE ACTUAL THICKNESS OF FILL PLATES MAY VARY FROM WHAT IS SHOWN ON THIS DWG. THE SHOP WILL BE RESPONSIBLE FOR ADJUSTING FILL THICKNESS AS REQUIRED TO SUIT THE ACTUAL MATERIAL SIZE. FILL PLATES SHALL BE A SINGLE THICKNESS PLATE.

REV.	DATE	REMARKS	DNW	CHK	APVL	SHOP
1/6/16		REVISED DIMENSIONS & ANGLES	RB	WJL		
0						
MATERIAL:		SURFACE PREP. & PAINT:	HOLES:		SHOP BOLTS:	
M270-50 (UN)		HOT-DIP GALV.	7/8" (UN)		7/8" (UN)	
DESCRIPTION: TRUSS LAYOUT @ L0, L8, L9 & L19						
STRUCTURE: TH-10 OVER OTTER CREEK PONY TRUSS BRIDGE			DRAWN: RB		DATE: 9/28/15	
LOCATION: RUTLAND CITY, VERMONT			CHKD: WJL		DATE: 10/13/15	
PROJ NO. BR 3000 (19)			JOB NO. 598		DWG NO. TDI	
CUSTOMER: KUBRICKY CONSTRUCTION CORP.			REV. A			