


ONE ~ BOTTOM CHORD ~ 1BC1N  
(L0 - L2 NORTH)  
ONE ~ BOTTOM CHORD ~ 1BC1S  
(L0 - L2 SOUTH)

ALIKE EXCEPT FOR MARK

ONE ~ BOTTOM CHORD ~ 1BC4N  
(L8 - L6 NORTH)  
ONE ~ BOTTOM CHORD ~ 1BC4S  
(L8 - L6 SOUTH)

SHOP NOTE "G"  
ALL STEEL SHALL BE HOT DIP GALVANIZED IN ACCORDANCE WITH SUBSECTION 506.15.

SHOP NOTE "H"  
HOLES IN BOTH FLANGES OF EACH BOTTOM CHORD BEAM ARE ALIKE.

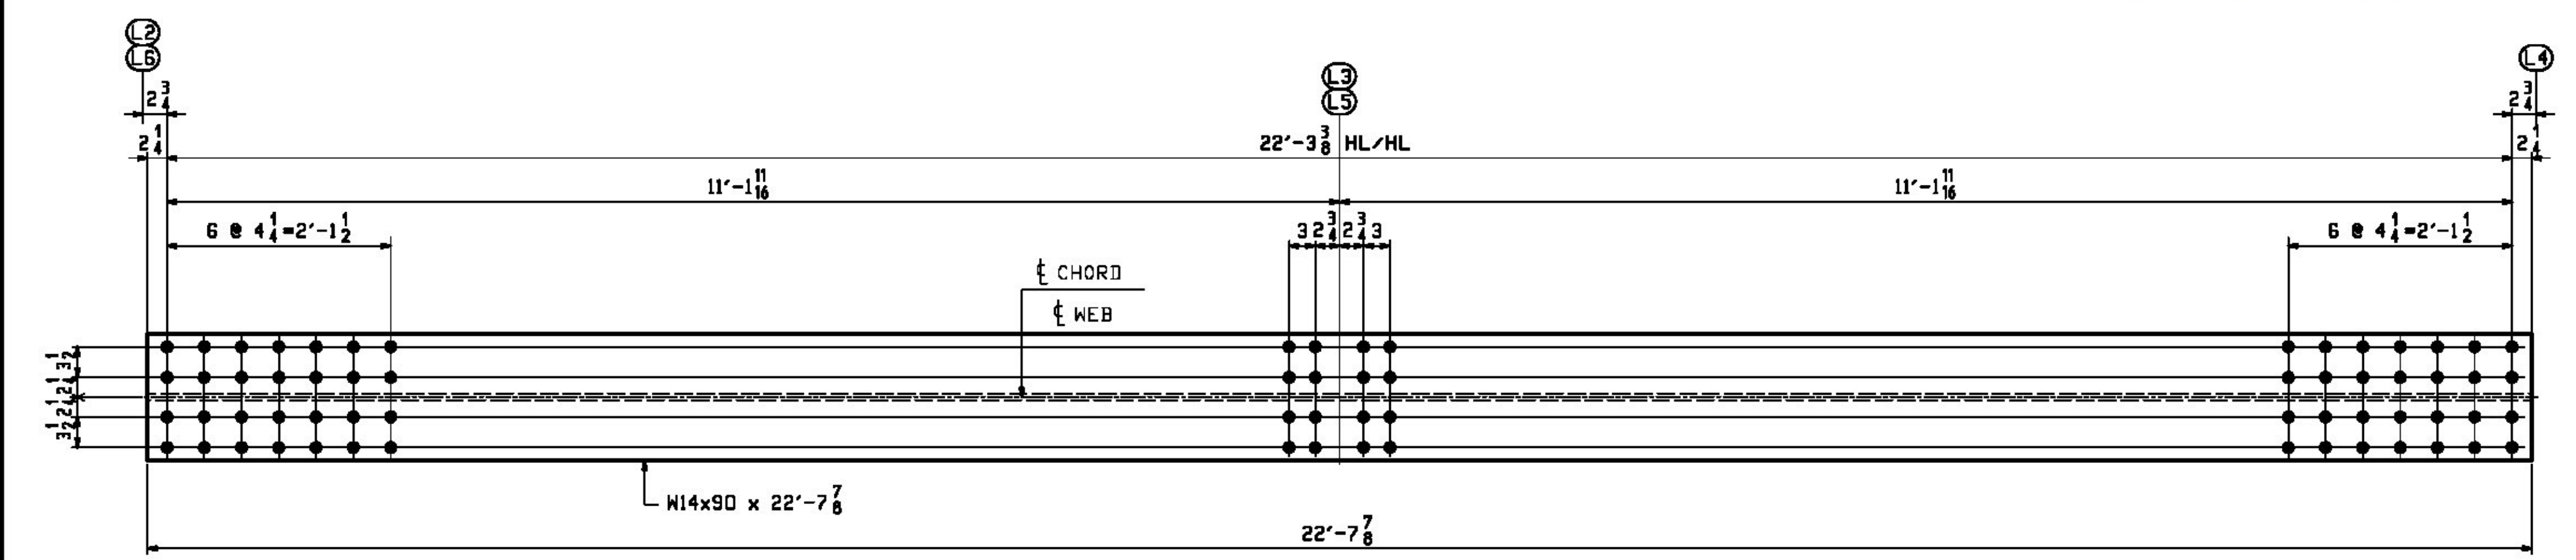

ONE ~ BOTTOM CHORD ~ 1BC2N  
(L2 - L4 NORTH)  
ONE ~ BOTTOM CHORD ~ 1BC2S  
(L2 - L4 SOUTH)

ALIKE EXCEPT FOR MARK

ONE ~ BOTTOM CHORD ~ 1BC3N  
(L6 - L4 NORTH)  
ONE ~ BOTTOM CHORD ~ 1BC3S  
(L6 - L4 SOUTH)

SHOP NOTE:  
DO NOT SHIP FROM THIS DRAWING

JOB NO.		DRAWING NO.		REV.
598		1		1
REV.	DATE	BY	REMARKS	PROCUREMENT NOTES
1				
2				
3				
Vermont Agency of Transportation  
**RECEIVED**  
ON: March 21, 2016  
and Checked for  
**CONFORMANCE**  
BY: ABC DATE:

NO EXCEPTION TAKEN  
 REJECTED  
 MAKE CORRECTIONS NOTED  
 REVISE AND RESUBMIT  
 SUBMIT SPECIFIED ITEM

CHECKING IS ONLY FOR THE GENERAL CONFORMANCE WITH THE DESIGN CONCEPT OF THE PROJECT AND GENERAL COMPLIANCE WITH THE INFORMATION GIVEN IN THE CONTRACT DOCUMENTS. ANY ACTION SHOWN IS SUBJECT TO THE REQUIREMENTS OF THE PLANS AND SPECIFICATIONS. CONTRACTOR IS RESPONSIBLE FOR DIMENSIONS WHICH SHALL BE CONFIRMED AND CORRELATED AT THE JOB SITE; FABRICATION PROCESSES AND TECHNIQUES OF CONSTRUCTION; COORDINATION OF HIS WORK WITH THAT OF ALL OTHER TRADES AND THE SATISFACTORY PERFORMANCE OF THE WORK.

CHA  
DATE 1/29/2016 BY J. Najdowski

NOTES:  
1. FOR GENERAL NOTES SEE DMG. GNI.  
2. FCM - DENOTES FRACTURE CRITICAL MATERIAL.

REV.	DATE	REMARKS	DWN	CHK	APVL	SHOP
0						
MATERIAL:	M270-50	SURFACE PREP. & PAINT: HOT-DIP GALV.	HOLES: 15/16"	SHOP BOLTS: NONE		
DESCRIPTION:	BOTTOM CHORDS					
STRUCTURE:	TH-10 OVER OTTER CREEK PONY TRUSS BRIDGE		DRAWN:	DATE:		
			RB	12/15/15		
			CHKD:	DATE:		
			WJL	1/13/16		
LOCATION:	RUTLAND CITY, VERMONT		JOB NO.	598	DWG NO.	1
PROJ NO.	BRF 3000 (19)					
CUSTOMER:	KUBRICKY CONSTRUCTION CORP.					

CASCO BAY STEEL STRUCTURES, INC.  
1 WALLACE AVE. PHONE (207) 780-6722  
SOUTH PORTLAND, ME 04106 FAX (207) 780-6726

MFL 1/23/16 10:51 AM 1/23/16 10:51 AM