


**SECTION A-A (NORTH SIDE ELEVATION)**  
(LOOKING NORTH)

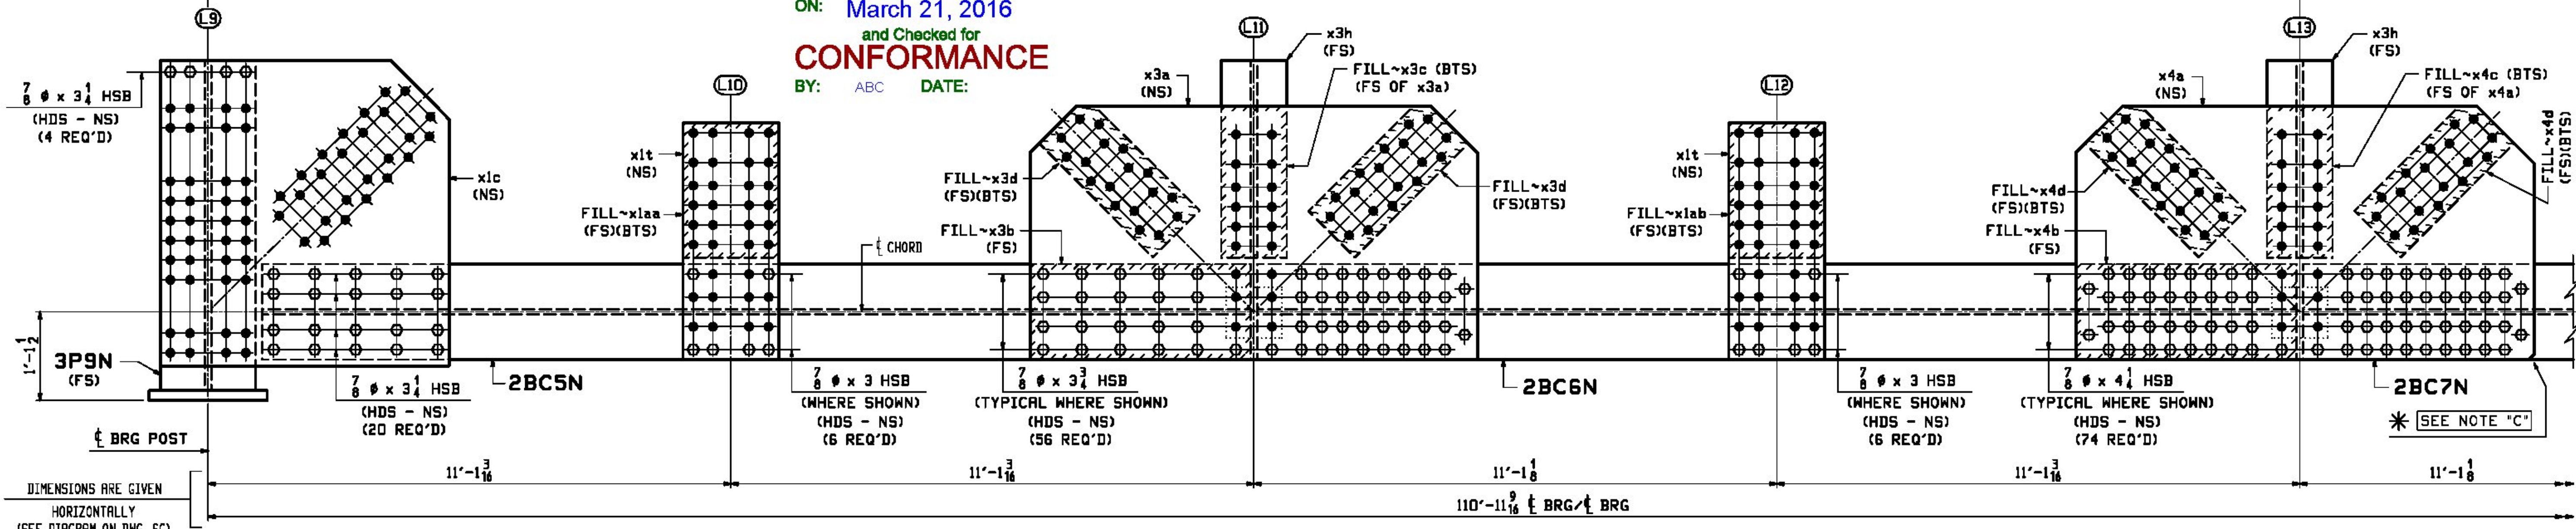


**SECTION B-B (SOUTH SIDE ELEVATION)**  
(LOOKING NORTH)

Vermont Agency of Transportation  
**RECEIVED**  
 ON: March 21, 2016  
 and Checked for  
**CONFORMANCE**  
 BY: ABC DATE:

- NO EXCEPTION TAKEN
- MAKE CORRECTIONS NOTED
- REJECTED
- REVISE AND RESUBMIT
- SUBMIT SPECIFIED ITEM

**ONE ~ BOTTOM CHORD ASSEMBLY ~ 6BC2N**  
 (@ NORTH TRUSS T2 - SPAN 2)  
 (FOR BLOCKING DIAGRAM SEE DWG. 6C)

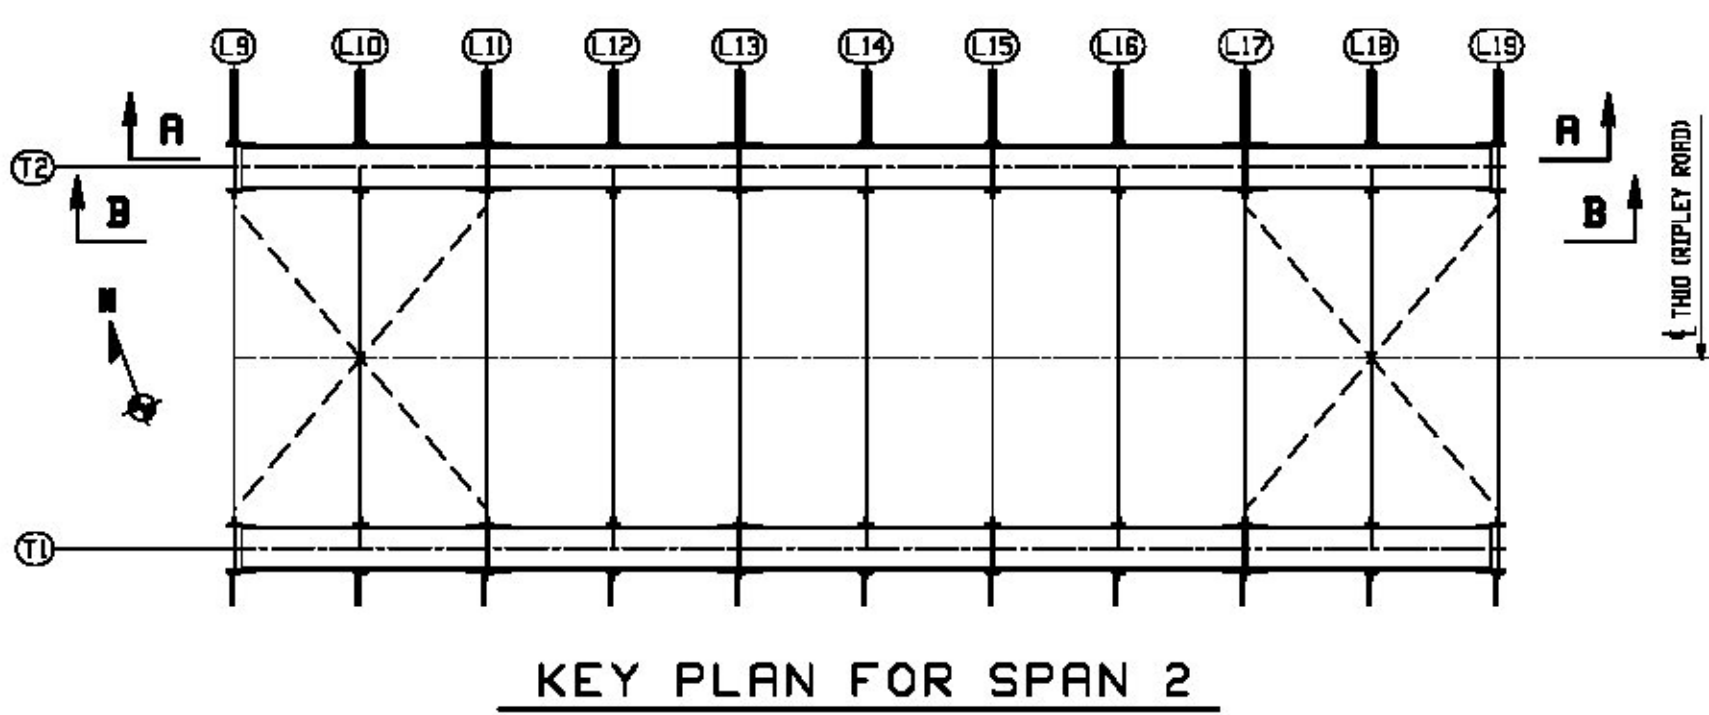

**KEY PLAN FOR SPAN 2**

CHECKING IS ONLY FOR THE GENERAL CONFORMANCE WITH THE DESIGN CONCEPT OF THE PROJECT AND GENERAL COMPLIANCE WITH THE INFORMATION GIVEN IN THE CONTRACT DOCUMENTS. ANY ACTION SHOWN IS SUBJECT TO THE REQUIREMENTS OF THE PLANS AND SPECIFICATIONS. CONTRACTOR IS RESPONSIBLE FOR VERIFYING DIMENSIONS WHICH SHALL BE CONFIRMED AND CORRELATED AT THE JOB SITE FABRICATION PROCESSES AND TECHNIQUES OF CONNECTIONS. THIS WORK WITH THAT OF THE FABRICATOR SHALL BE SATISFACTORY PERFORMANCE. ALL BOLTS SHALL BE A325-1. ALL BOLTS SHALL BE WITH ONE HARDENED WASHER AND ONE DTI WASHER. WASHERS SHALL BE MECHANICALLY GALVANIZED.

DATE 1/29/2016 BY J. Najdowski

**\* SHOP NOTE "C"**  
 FOR PLATE ORIENTATION PLACE CLIP TOWARDS SIDE SHOWN.

WORK THIS DWG. WITH DWG. 6BC & 6C

REV.	DATE	REMARKS	DWN	CHK	APVL	SHOP
0						
MATERIAL:	M270-50 (UN)	SURFACE PREP. & PAINT: SEE DWG. GNI	HOLES: 15/16"			SHOP BOLTS: AS NOTED
DESCRIPTION: BOTTOM CHORD ASSEMBLY (NORTH TRUSS - SPAN 2)						
		<b>CASCO BAY STEEL STRUCTURES, INC.</b> 1 WALLACE AVE. SOUTH PORTLAND, ME 04106		PHONE (207) 780-6722 FAX (207) 780-6726		
STRUCTURE: TH-10 OVER OTTER CREEK PONY TRUSS BRIDGE			DRAWN: RB	DATE: 12/17/15		
			CHKD: WJL	DATE: 1/14/16		
LOCATION: RUTLAND CITY, VERMONT			JOB NO. 598	DWG NO. 6AC		
PROJ NO. BRF 3000 (19)						
CUSTOMER: KUBRICKY CONSTRUCTION CORP.						